



WELD LEGEND	
—	SHOP
- - -	FIELD
- · - · -	NO X-RAY REQ'D

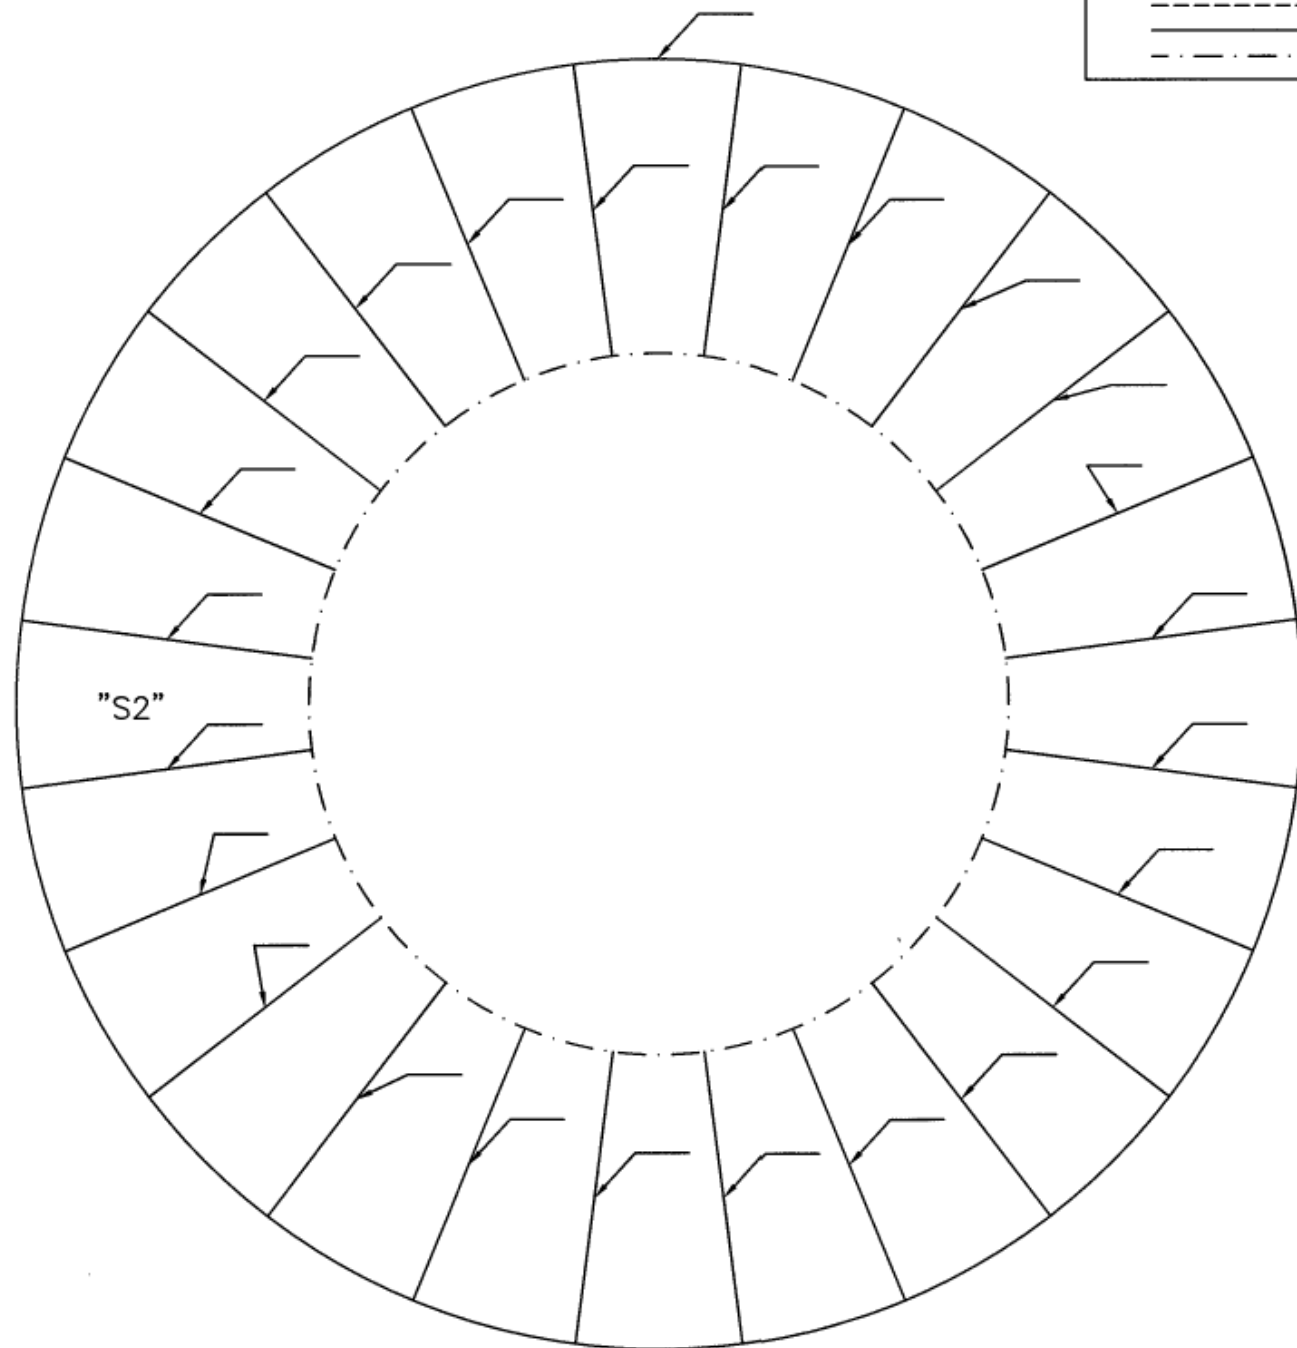

TOP LAY-OUT

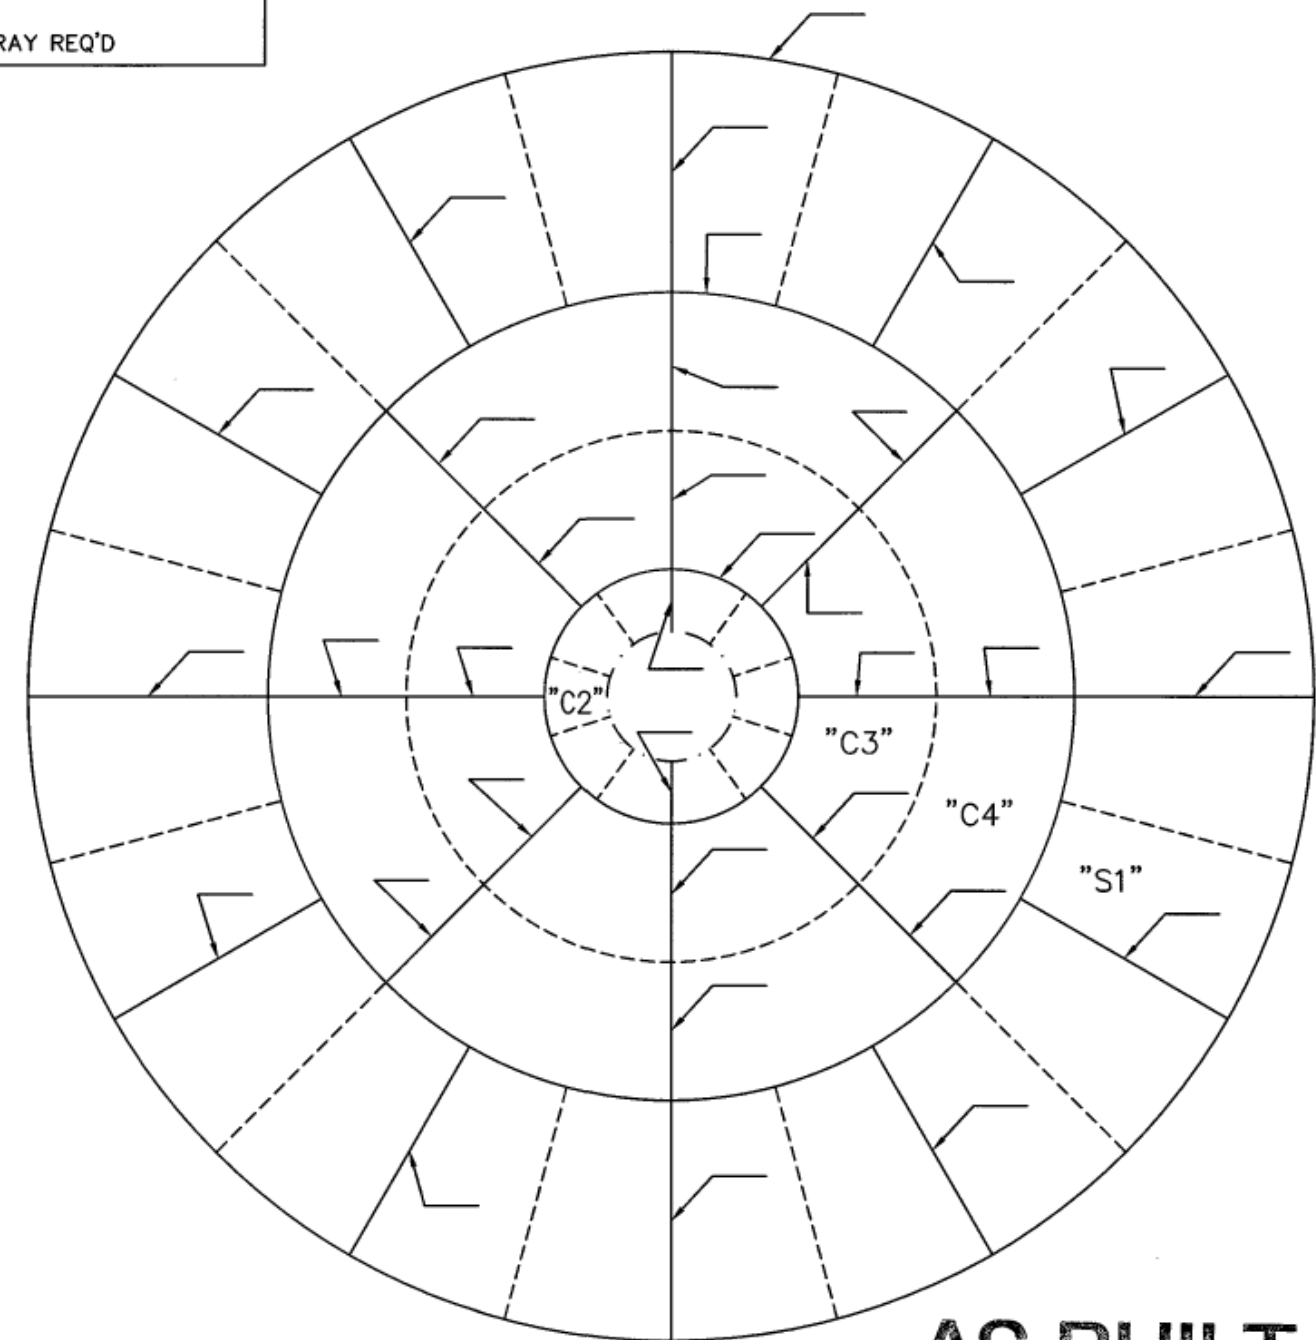

BOTTOM LAY-OUT

AS BUILT

NOTE:  
1. THIS DRAWING TO BE USED IN CONJUNCTION WITH DRAWING XR2.

NOTE:  
THE SYMBOL ABOVE SHOULD BE USED TO DESIGNATE THE WELDER OF EACH SEAM. PUT THE OUTSIDE WELDER'S INITIAL ON TOP OF THE LINE AND THE INSIDE WELDER'S INITIAL ON THE BOTTOM OF THE LINE. IF DIFFERENT WELDERS WELDED SEAMS OF THE SAME SECTION, YOU MUST SPECIFY EACH WELDER AT EACH SEAM.

REV.	BY:	DATE	REMARKS
<div> <div>CALDWELL</div> <div>Since 1887</div> <div>Water - Energy - Industrial</div> </div>			
ROANOKE COUNTY, VIRGINIA 250,000 GALLON PEDESHERE TANK			
BY:	JLH	TITLE:	FIELD X-RAY LAYOUT
DATE:	9/09/15	DRAWING NO:	E-8344
			XR1