




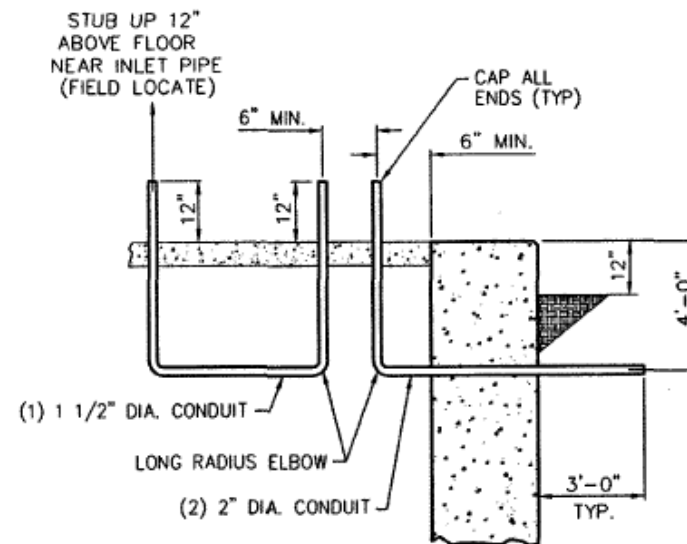

CONDUIT DETAIL
REQUIRED @ LOCATIONS SHOWN IN PLAN VIEW.

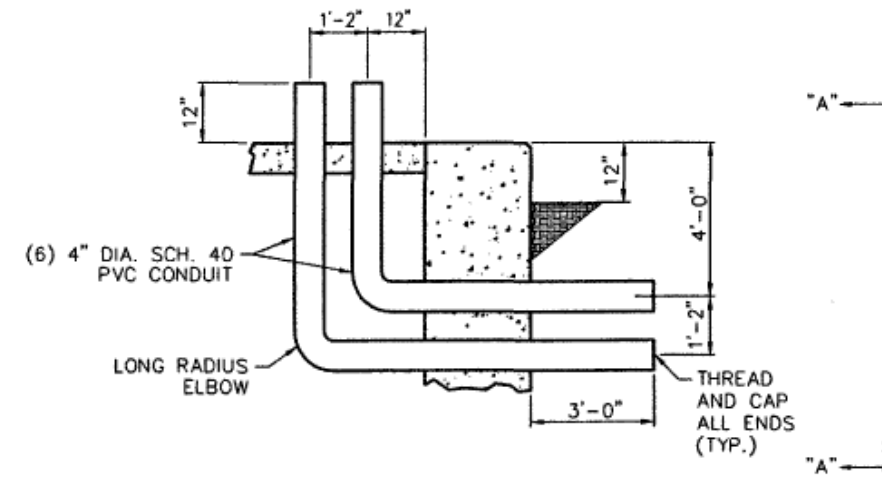


ANTENNA CONDUIT DETAIL
REQUIRED @ LOCATION SHOWN IN PLAN VIEW.

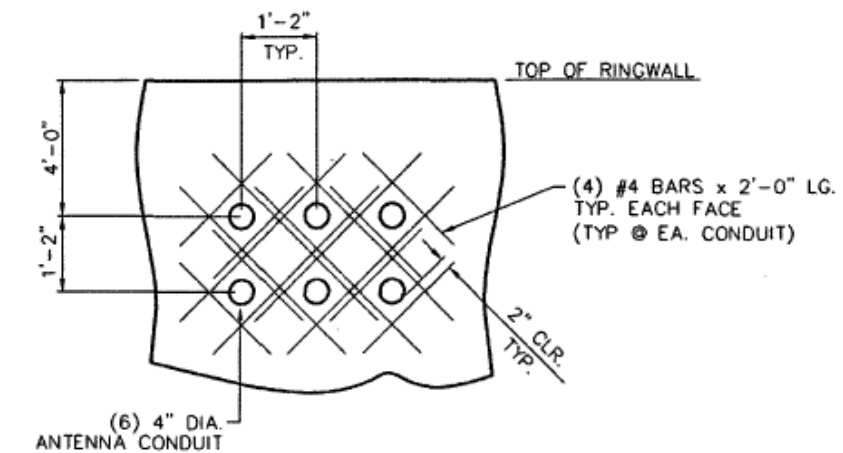


SECTION "A-A"


NOTE: DO NOT CUT TYPICAL RINGWALL REINFORCING TO INSTALL CONDUIT. ADJUST CONDUIT AS REQ'D TO MAINTAIN MINIMUM SPACING SHOWN.

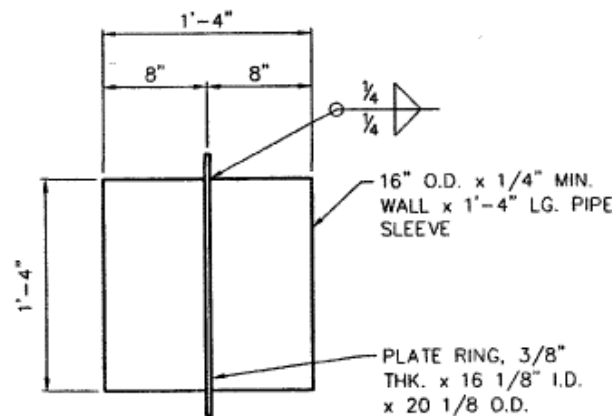

PIPE SLEEVE
FOR 12" DIA. INLET @ RINGWALL

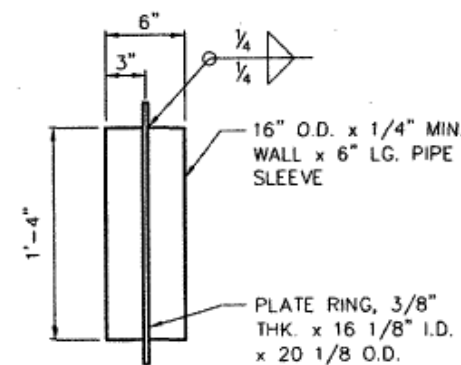

PIPE SLEEVE
FOR 12" DIA. INLET @ BASE CONE FLOOR

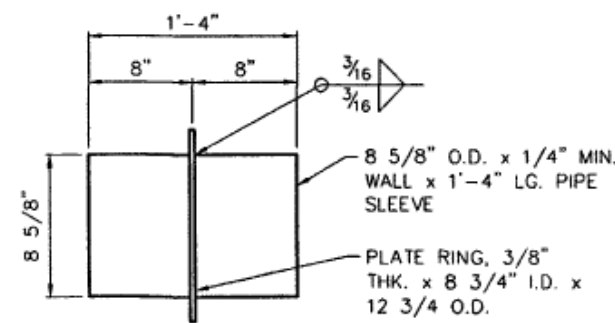

PIPE SLEEVE
FOR 4" DIA. FLOOR DRAIN @ RINGWALL

AS BUILT

		REV.		BY:	DATE	REMARKS
		ROANOKE, VIRGINIA 250,000 GALLON PEDESHERE				
		BY: AMK		TITLE: RING FOUNDATION ANTENNA/CONDUIT DETAILS		
		DATE: 06/26/15		DRAWING NO. E-8344 F4 OF 4		