
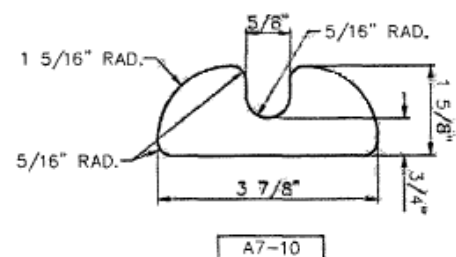
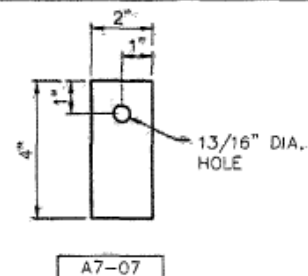
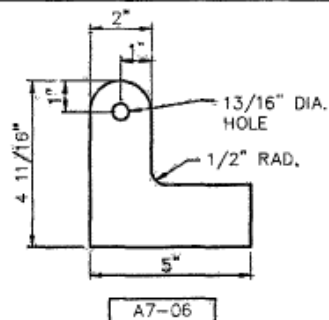


SHIPPING ITEM	QTY.	PC. MK.	QTY.	MATERIAL REQ'D	DESCRIPTION	UNIT WT.
① A7-MP-24	1			24" DIA. PEDESTAL ACCESS MANHOLE		245
		A7-01	1	PL 1/8" x 2'-3" DIA.	COVER	
		A7-02	1	FB 1/8" x 2" x 6'-10 7/8" LG. (ROLL TO 26 1/2' 00)	BAR	
		A7-03	1	FB 1/8" x 2" x 12" (BENT)	HANDLE	
		A7-04	2	BY 3/4" DIA. x 1 1/2" LG.	M. BOLT w/NUT	
②		A7-05	1	PI 24" OD x 7/8" x 11" LG.	STEEL TUBE	
		A7-06	2	PL 3/8"	HINGE	
		A7-07	2	FB 3/8" x 2" x 4" LG. w/13/16" HOLE	HINGE BAR	
		A7-08	1	BY 1/2" DIA. x 1 1/2" LG.	M. BOLT w/NUT	
		A7-09	1	PL 1/4" PLATE	LATCH	
		A7-10	1	PL 1/4" PLATE	LATCH	

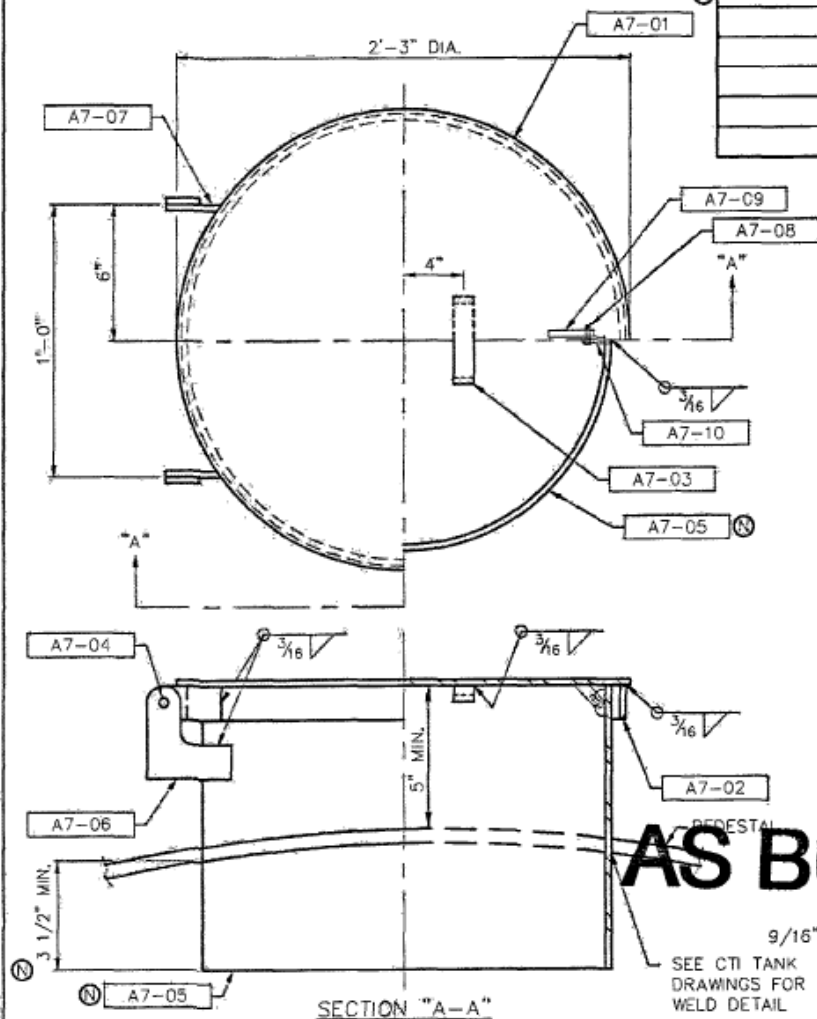

AS BUILT

SEE CTI TANK
DRAWINGS FOR
WELD DETAIL

REV.	BY:	DATE	REMARKS
TITLE: ROANOKE, VIRGINIA			
② 24" DIA. PEDESTAL ACCESS MANHOLE			
DRAWING NO.: E-8344			
② A7			