
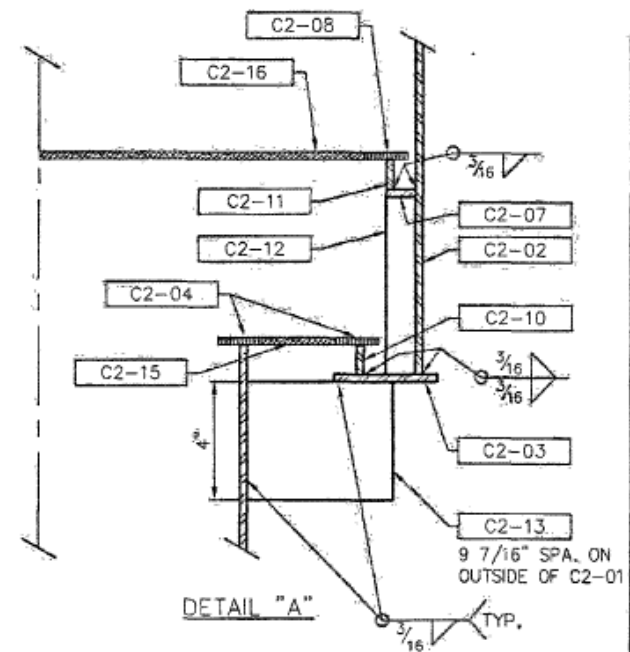


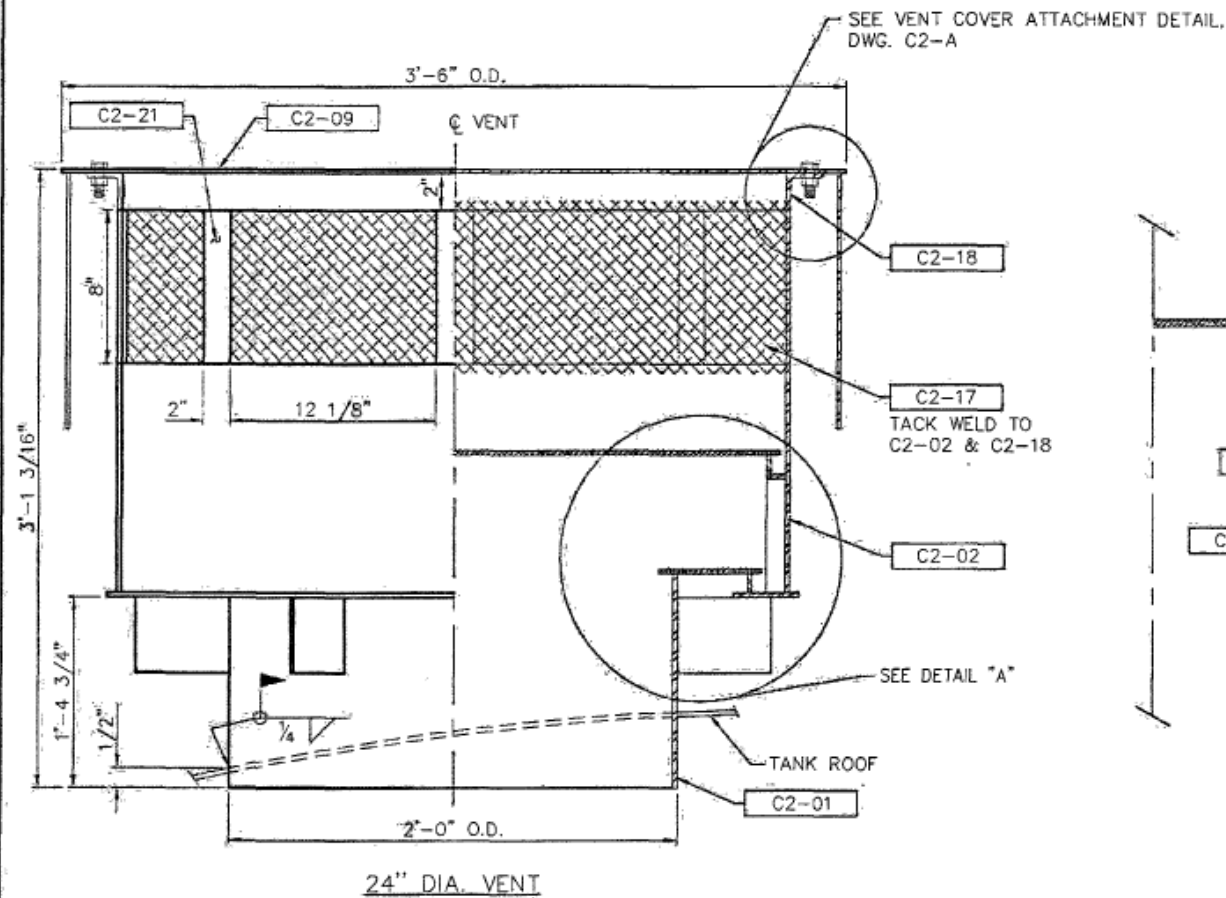

NOTE:
SEE DWG. C2-A FOR ADDITIONAL DETAILS

AS BUILT

CALDWELL
Since 1887
Water - Energy - Industrial

TITLE:
24" DIA. VENT

DRAWING NO.:
C2