



(36) 1/4" DIA. HOLES ON
33 1/2" DIA. BOLT CIRCLE FOR

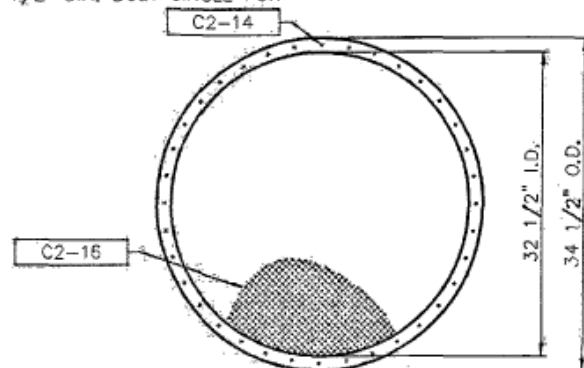

UPPER PALLET RING/SCREEN

(36) 1/4" DIA. HOLES
ON A 31 1/4" BOLT CIRCLE FOR

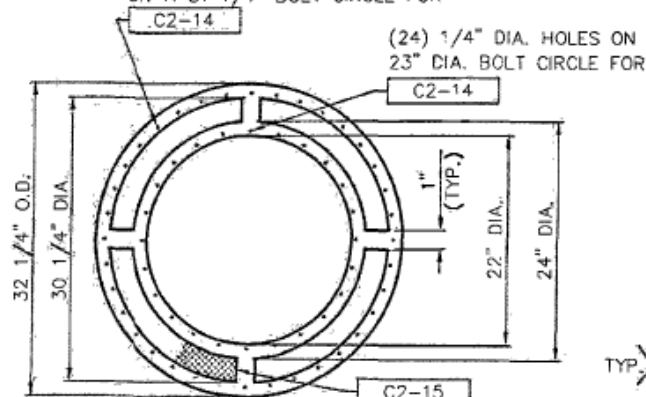


LOWER PALLET RING/SCREEN

NOTES:

1. SCREEN PALLETS TO BE MADE FROM 3/8" THK. HDPE MATERIAL (WHITE).
2. SCREENS TO BE FASTENED DOWN BY NYLON PUSH IN RIVETS (1/4" x 0.437" LG. BLACK FLAT HEAD RIVET) PART C2-14.
3. SEE DWG. C2 FOR ADDITIONAL DETAILS.
4. PALLET SCREENS TO BE EXTRUDED POLYESTER SUPER SCREEN (UV RESISTANT 17/14 MESH).

SHIPPING ITEM	QTY.	P.C. MK.	QTY.	MATERIAL REQ'D	DESCRIPTION	UNIT WT.
C2-PV-24	1			24" DIA. VENT		480
		C2-01	1	PI 1/4" x 24" O.D. x 1'-6" LG.	VENT NECK	
		C2-02	1	PI 1/4" x 36" O.D. x 10" LG.	VENT BODY	
		C2-03	1	PL 1/4" x 37" O.D. x 30" I.D.	PLATE RING	
		C2-04	1	BY 3/8" x 32 1/4" O.D. x 22" I.D.	LOWER PALLET RING	
		C2-07	1	PL 1/4" x 35 1/4" O.D. x 33 1/2" I.D.	PLATE RING	
		C2-08	1	BY 3/8" x 34 1/2" O.D. x 32 1/2" I.D.	UPPER PALLET RING	
		C2-09	1	PL 3/16" x 42" DIA.	COVER PLATE	
		C2-10	1	FB 3/16" x 1" x 99 3/4" LG. (ROLLED TO 32" O.D.)	PALLET SUPPORT	
		C2-11	1	FB 3/16" x 1" x 106" LG. (ROLLED TO 34" O.D.)	PALLET SUPPORT	
		C2-12	4	FB 1/4" x 1" x 6" LG.	BAR RING SUPPORT	
		C2-13	8	FB 1/4" x 4" x 5" LG.	VENT GUSSET	
		C2-14	96	BY 1/4" x 0.437" BLACK FLAT HEAD	PUSH IN RIVET	
		C2-15	1	BY 32 1/4" O.D. x 22" I.D. (SEE NOTE 4)	LOWER SCREEN	
		C2-16	1	BY 34 1/2" O.D. (SEE NOTE 4)	UPPER SCREEN	
		C2-17	1	BY 9" x 9'-6" FLATTENED EXP. METAL	VENT BODY SCREEN	
		C2-18	1	AN 1/4" x 2" x 2" x 9'-5 1/16" (ROLLED TO 36" O.D.)		
		C2-19	1	FB 3/16" x 12" x 10'-8 1/4" LG.	SCREEN SHIELD	
		C2-20	3	BY 1/2" DIA. x 1 1/2" (ZINC PL.)	LATCH BOLT w/NUT	
		C2-21	8	FB 1/4" x 2" x 8" LG.	BAR	

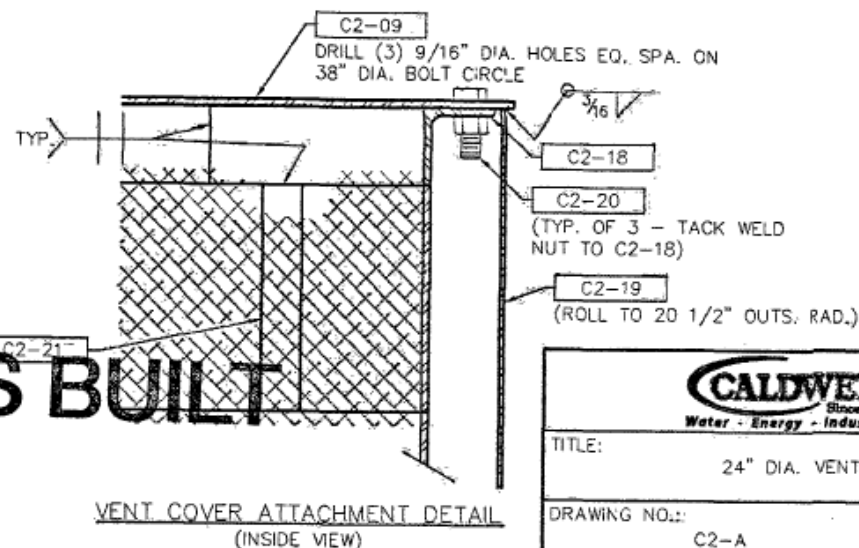

AS BUILT

VENT COVER ATTACHMENT DETAIL
(INSIDE VIEW)

CALDWELL
Since 1987
Water - Energy - Industrial

TITLE:
24" DIA. VENT

DRAWING NO.:
C2-A