


w:\drawings\2019\2019-03\401-cad\01-engineering\02-design\as-built\19034-comp-as-built.dwg 19034-comp-as-built-01-cv01.plt


AS-BUILT
GRIFFIN / VAN WINKLE
WATERLINE REPLACEMENTS

SITUATED IN
THE CITY OF ROANOKE, VIRGINIA
DATE: SEPTEMBER 30, 2020
PREPARED FOR
JACK ST. CLAIR, INC.

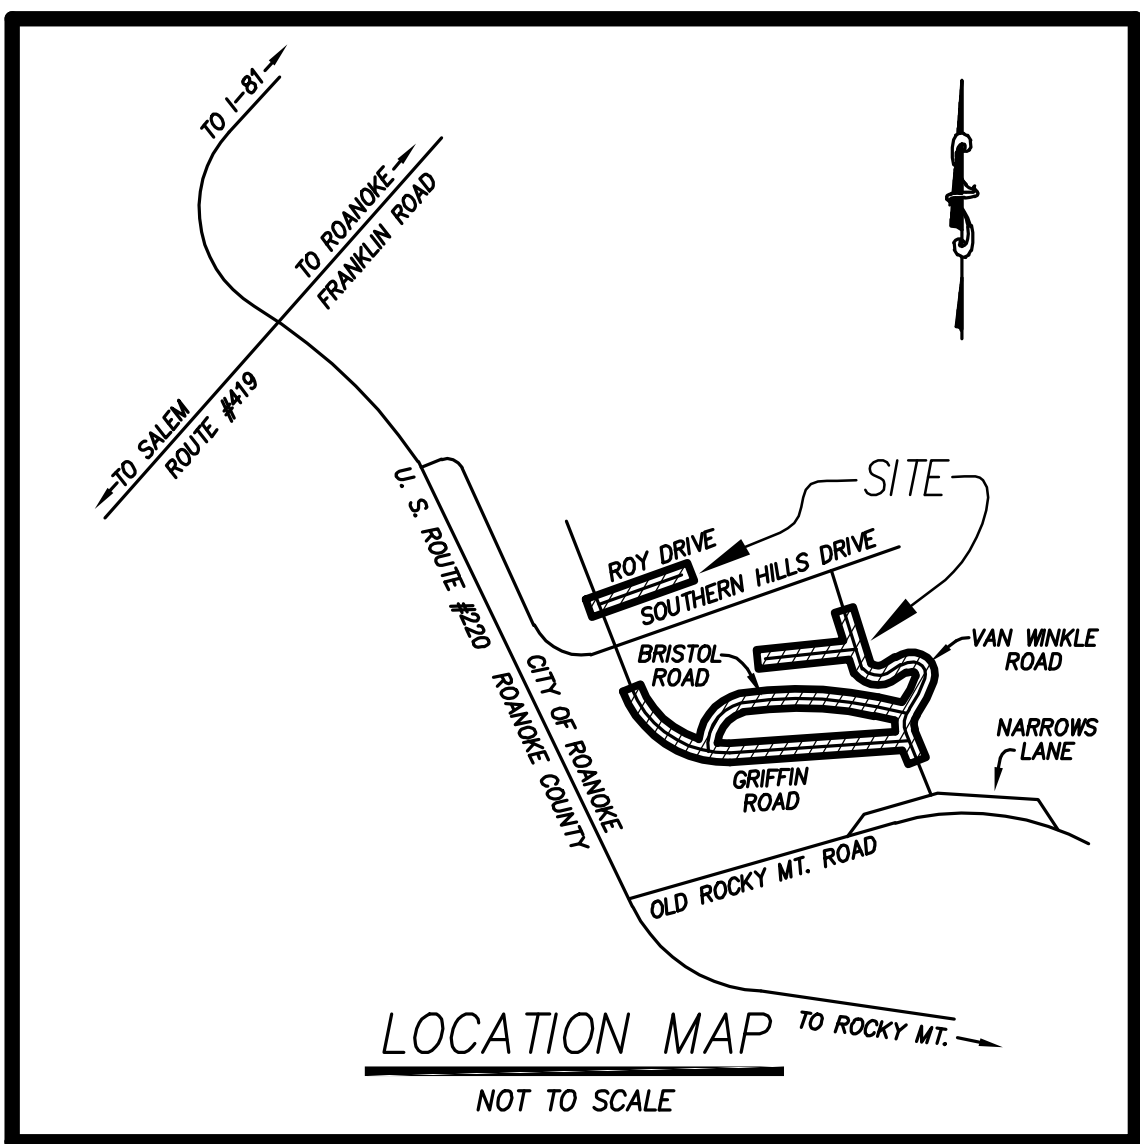

--INDEX OF DRAWINGS--


SHEET No.	DESCRIPTION
1.	LUMSDEN ASSOCIATES COVER SHEET
2.	SHEET LAYOUT & PROJECT OVERVIEW
3.	PLAN & PROFILE EASTERN GRIFFIN ROAD
4.	PLAN & PROFILE WESTERN GRIFFIN ROAD
5.	PLAN & PROFILE BRISTOL ROAD
6.	PLAN & PROFILE SOUTHERN VAN WINKLE ROAD
7.	PLAN & PROFILE NORTHERN VAN WINKLE ROAD
8.	PLAN & PROFILE JOPLIN ROAD
9.	PLAN & PROFILE ROY DRIVE

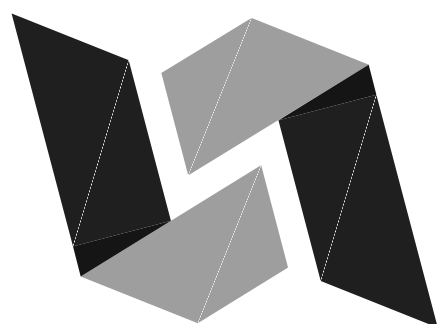

Lumsden Associates, P.C.
ENGINEERS | SURVEYORS | PLANNERS

4664 BRAMBLETON AVENUE, SW
P.O. BOX 20669
ROANOKE, VIRGINIA 24018

PHONE: (540) 774-4411
FAX: (540) 772-9445
WWW.LUMSDENPC.COM

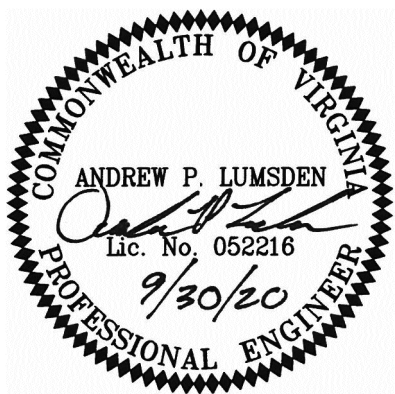

AS-BUILT
AS-BUILT INFORMATION SHOWN ON
THIS PLAN IS THE RESULT OF A
FIELD SURVEY PERFORMED
BY LUMSDEN ASSOCIATES, P.C. OR
AS SUPPLIED BY JACK ST. CLAIR
(CONTRACTOR) FIELD MARKUPS.

REVISIONS	
DATE	SHEETS
COMMISSION NO. 19-034 & 20-191	
SHEET 1 OF 9	