


NOTE:
CONTRACTOR AS-BUILT FIELD MARKUPS AS SUPPLIED BY JACK ST. CLAIR
INDICATED NO VERTICAL DEVIATIONS FROM THE ORIGINAL PLANS. SEE SHEET 2
FOR FIELD SURVEYED INDIVIDUAL WATERLINE APPURTENANCE ELEVATIONS.

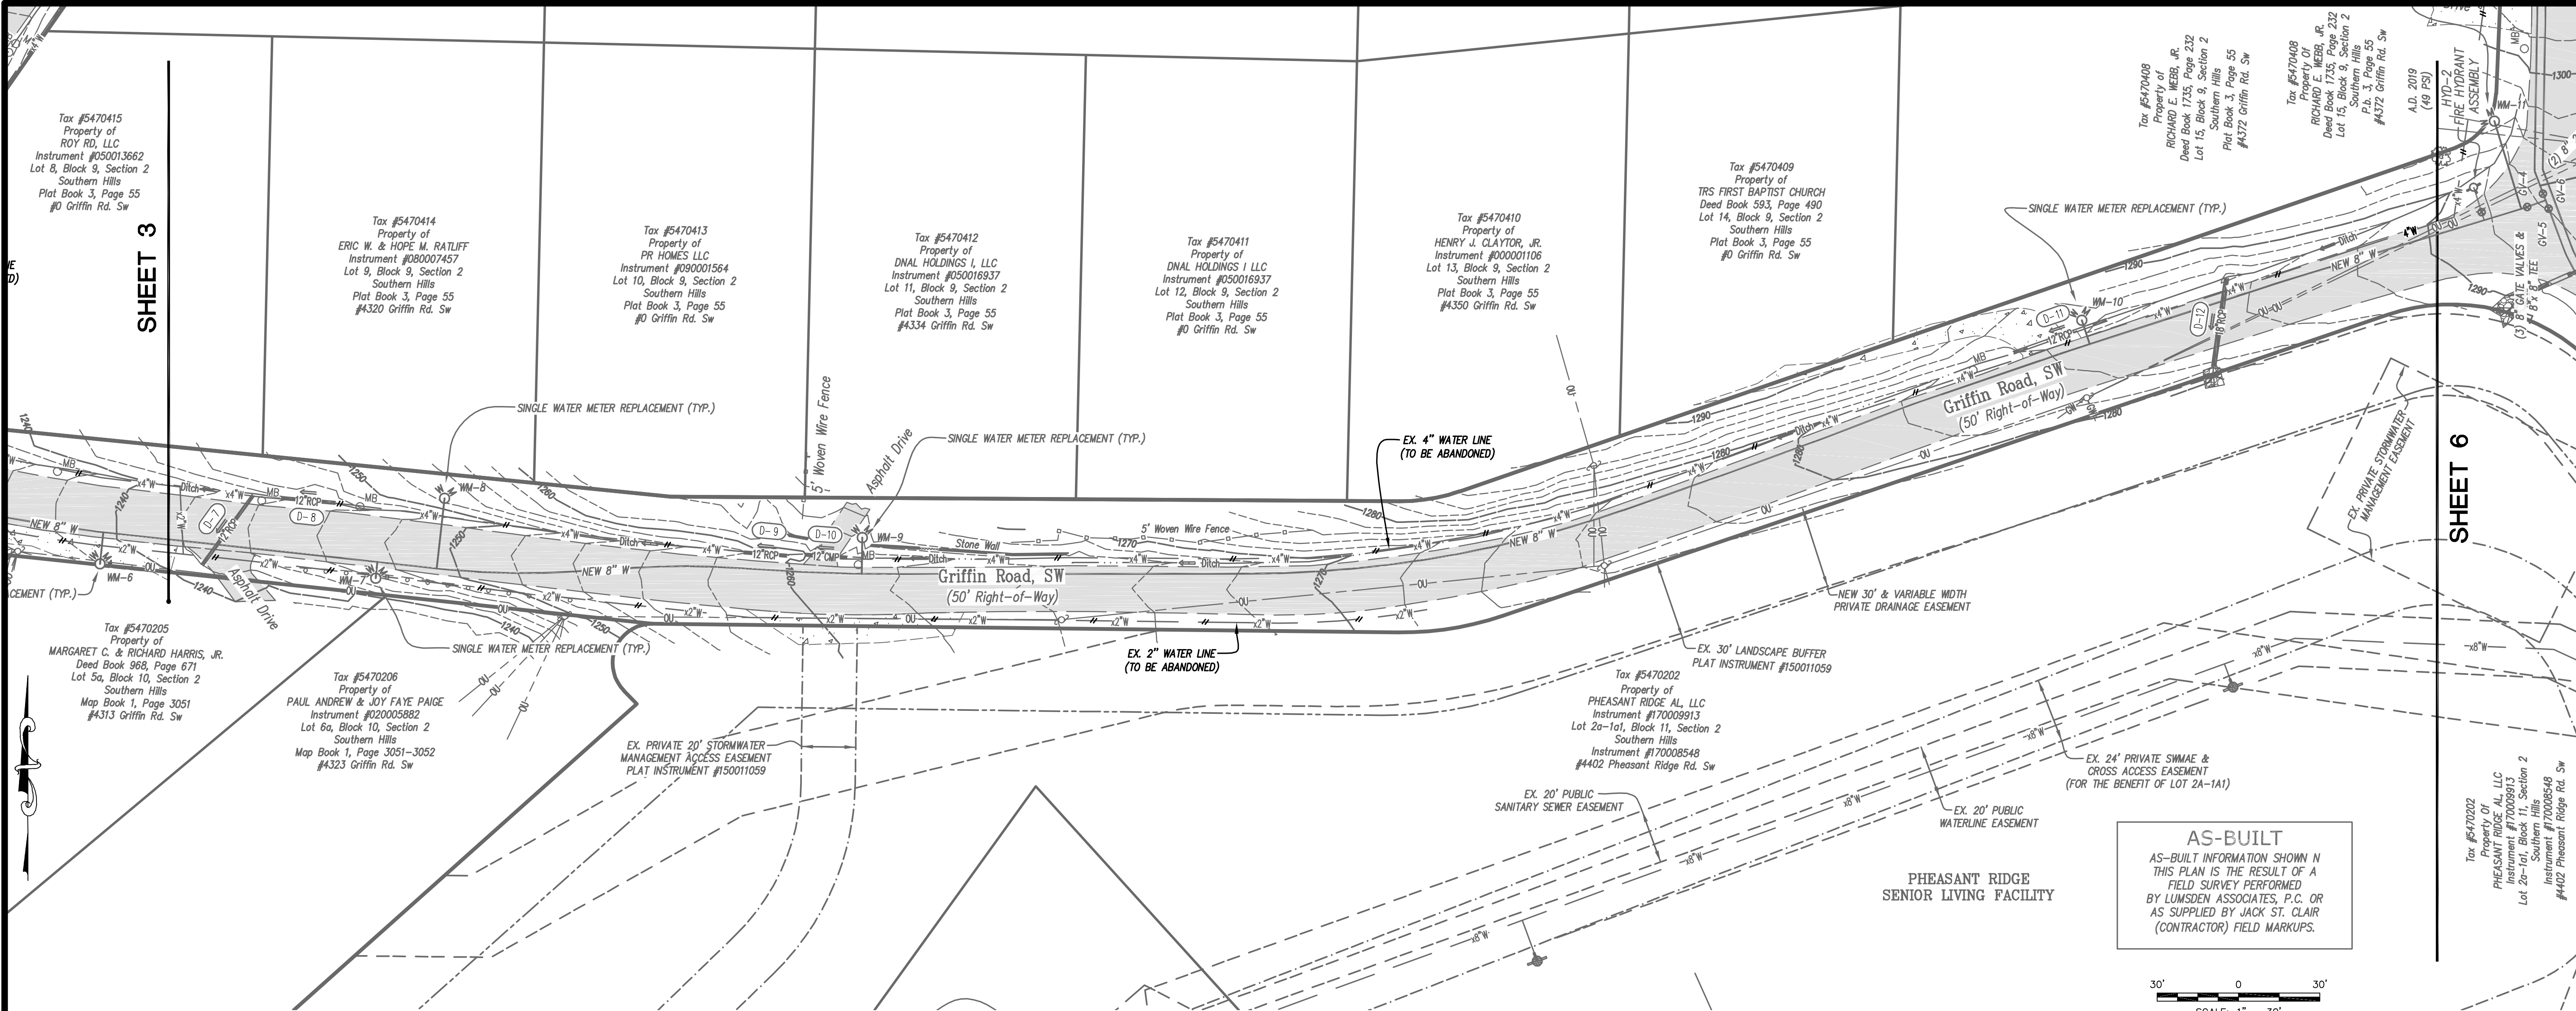


SHEET 3

SHEET 6

GRIFFIN / VAN WINKLE
WATERLINE REPLACEMENTS
PREPARED FOR
JACK ST. CLAIR, INC.
SITUATED IN
THE CITY OF ROANOKE, VIRGINIA

AS-BUILT
PLAN & PROFILE
WESTERN GRIFFIN ROAD

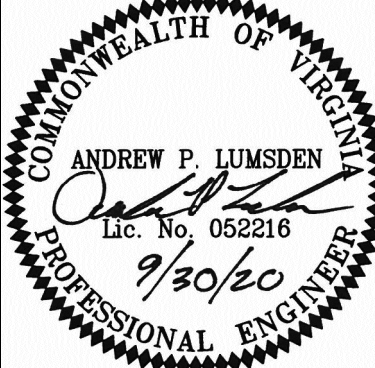

Lumsden Associates, P.C.
ENGINEERS | SURVEYORS | PLANNERS

4664 BRAHMBLETON AVENUE
P.O. BOX 20669
ROANOKE, VIRGINIA 24018

PHONE: (540) 774-4411
FAX: (540) 772-9445
WWW.LUMSDENPC.COM

REVISIONS		DESCRIPTION
NO.	DATE	
1		
2		
3		
4		
5		

DATE: September 30, 2020
SCALE: 1" = 30'
COMMISSION NO: 19-034 & 20-191
SHEET 4 OF 9