


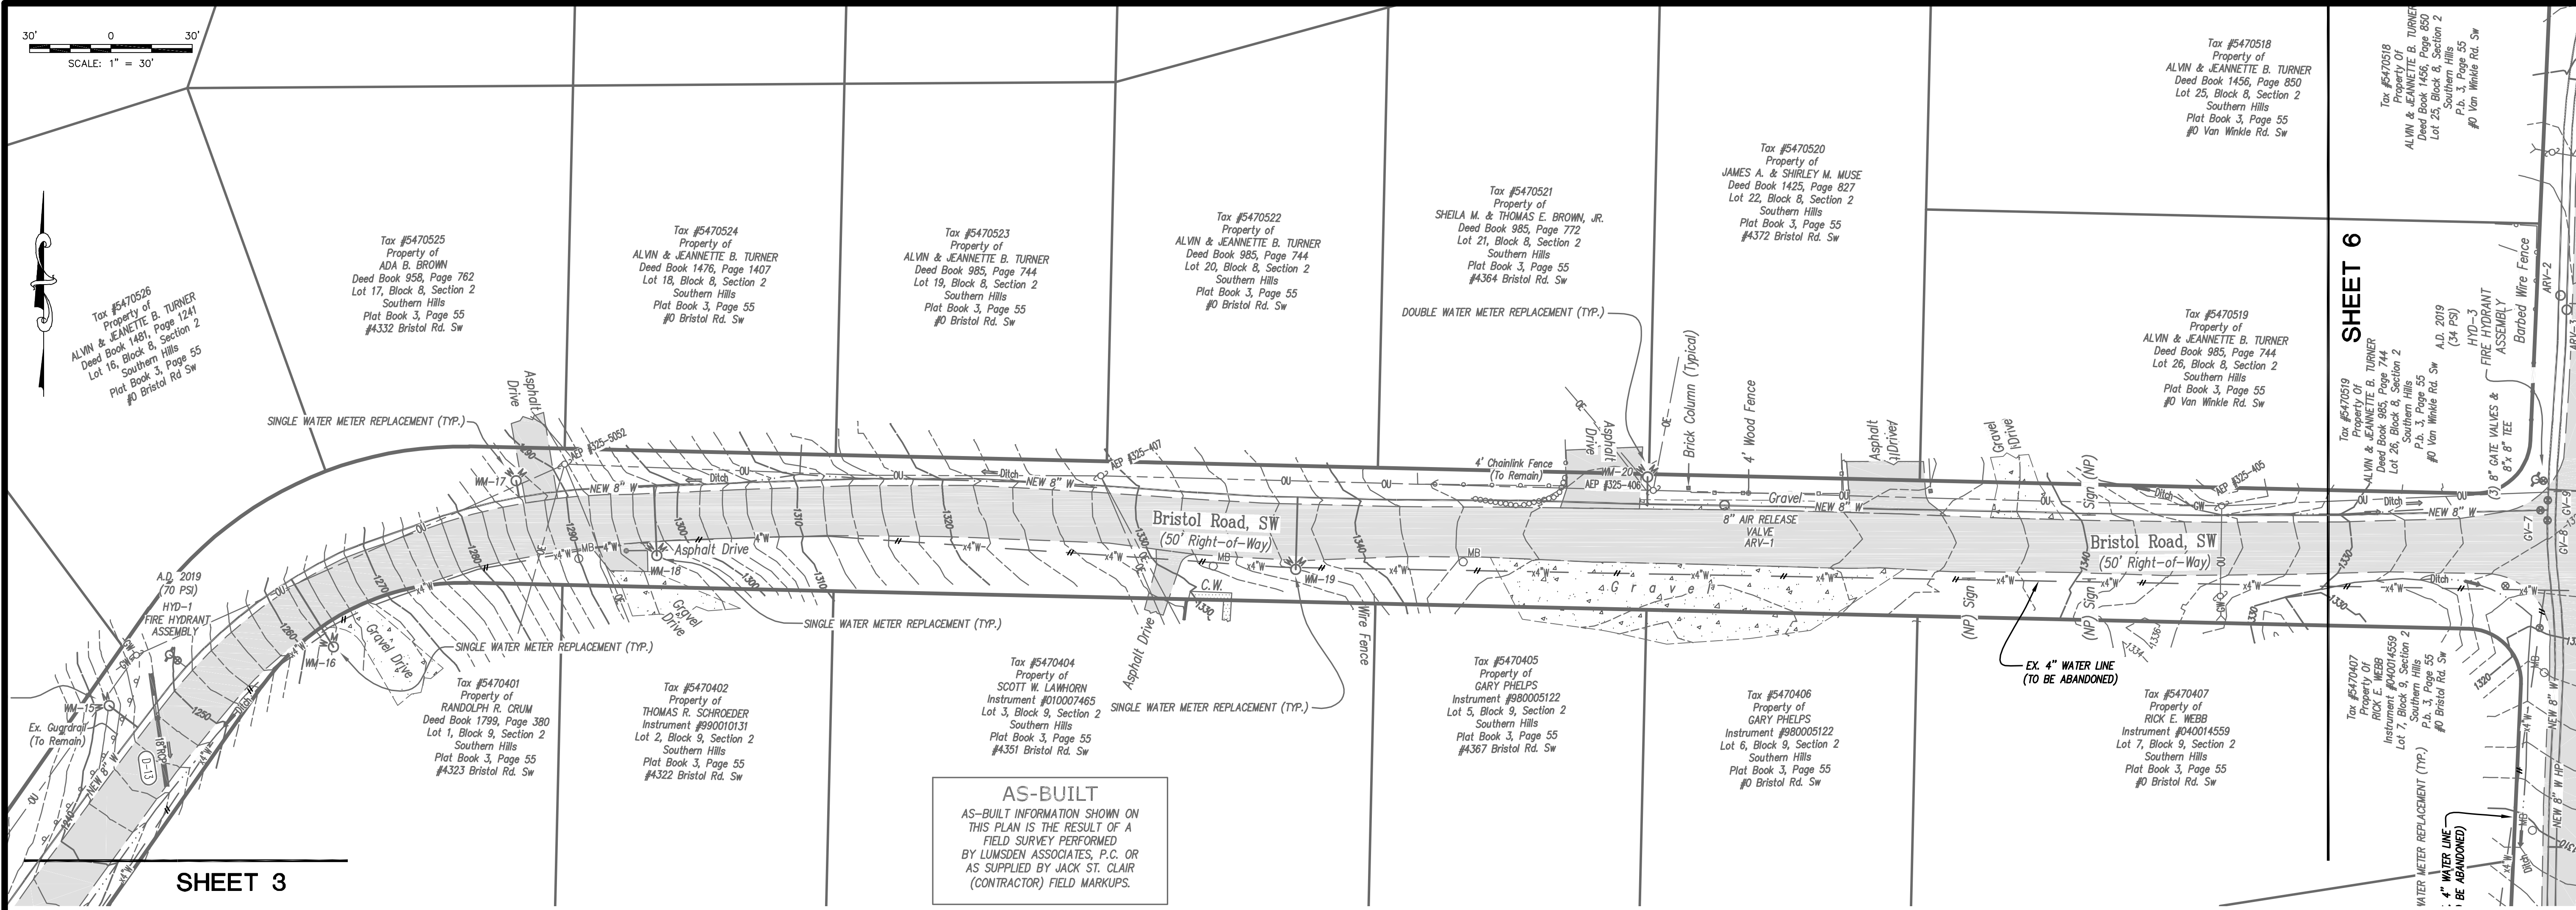

NOTE:
CONTRACTOR AS-BUILT FIELD MARKUPS AS SUPPLIED BY JACK ST. CLAIR
INDICATED NO VERTICAL DEVIATIONS FROM THE ORIGINAL PLANS. SEE SHEET 2
FOR FIELD SURVEYED INDIVIDUAL WATERLINE APPURTENANCE ELEVATIONS.

REVISIONS

NO.	DATE	DESCRIPTION
1		
2		
3		
4		
5		

DATE:

September 30, 2020

SCALE:

1" = 30'

COMMISSION NO:

19-034 & 20-191

SHEET 5 OF 9

GRIFFIN / VAN WINKLE
WATERLINE REPLACEMENTS

PREPARED FOR
JACK ST. CLAIR, INC.
SITUATED IN
THE CITY OF ROANOKE, VIRGINIA

AS-BUILT
PLAN & PROFILE
BRISTOL ROAD

COMMONWEALTH OF VIRGINIA
ANDREW P. LUMSDEN
Lic. No. 052216
9/30/20
PROFESSIONAL ENGINEER

Lumsden Associates, P.C.

ENGINEERS | SURVEYORS | PLANNERS

4664 BRAHMBLETON AVENUE
P.O. BOX 20669
ROANOKE, VIRGINIA 24018

PHONE: (540) 774-4411
FAX: (540) 772-9445
WWW.LUMSDENPC.COM