


19034-comp-as-built-06-pp04.plt

w:\drawings\2019\2019-03\401-cad\01-engineering\02-design\as-built\19034-comp-as-built.dwg

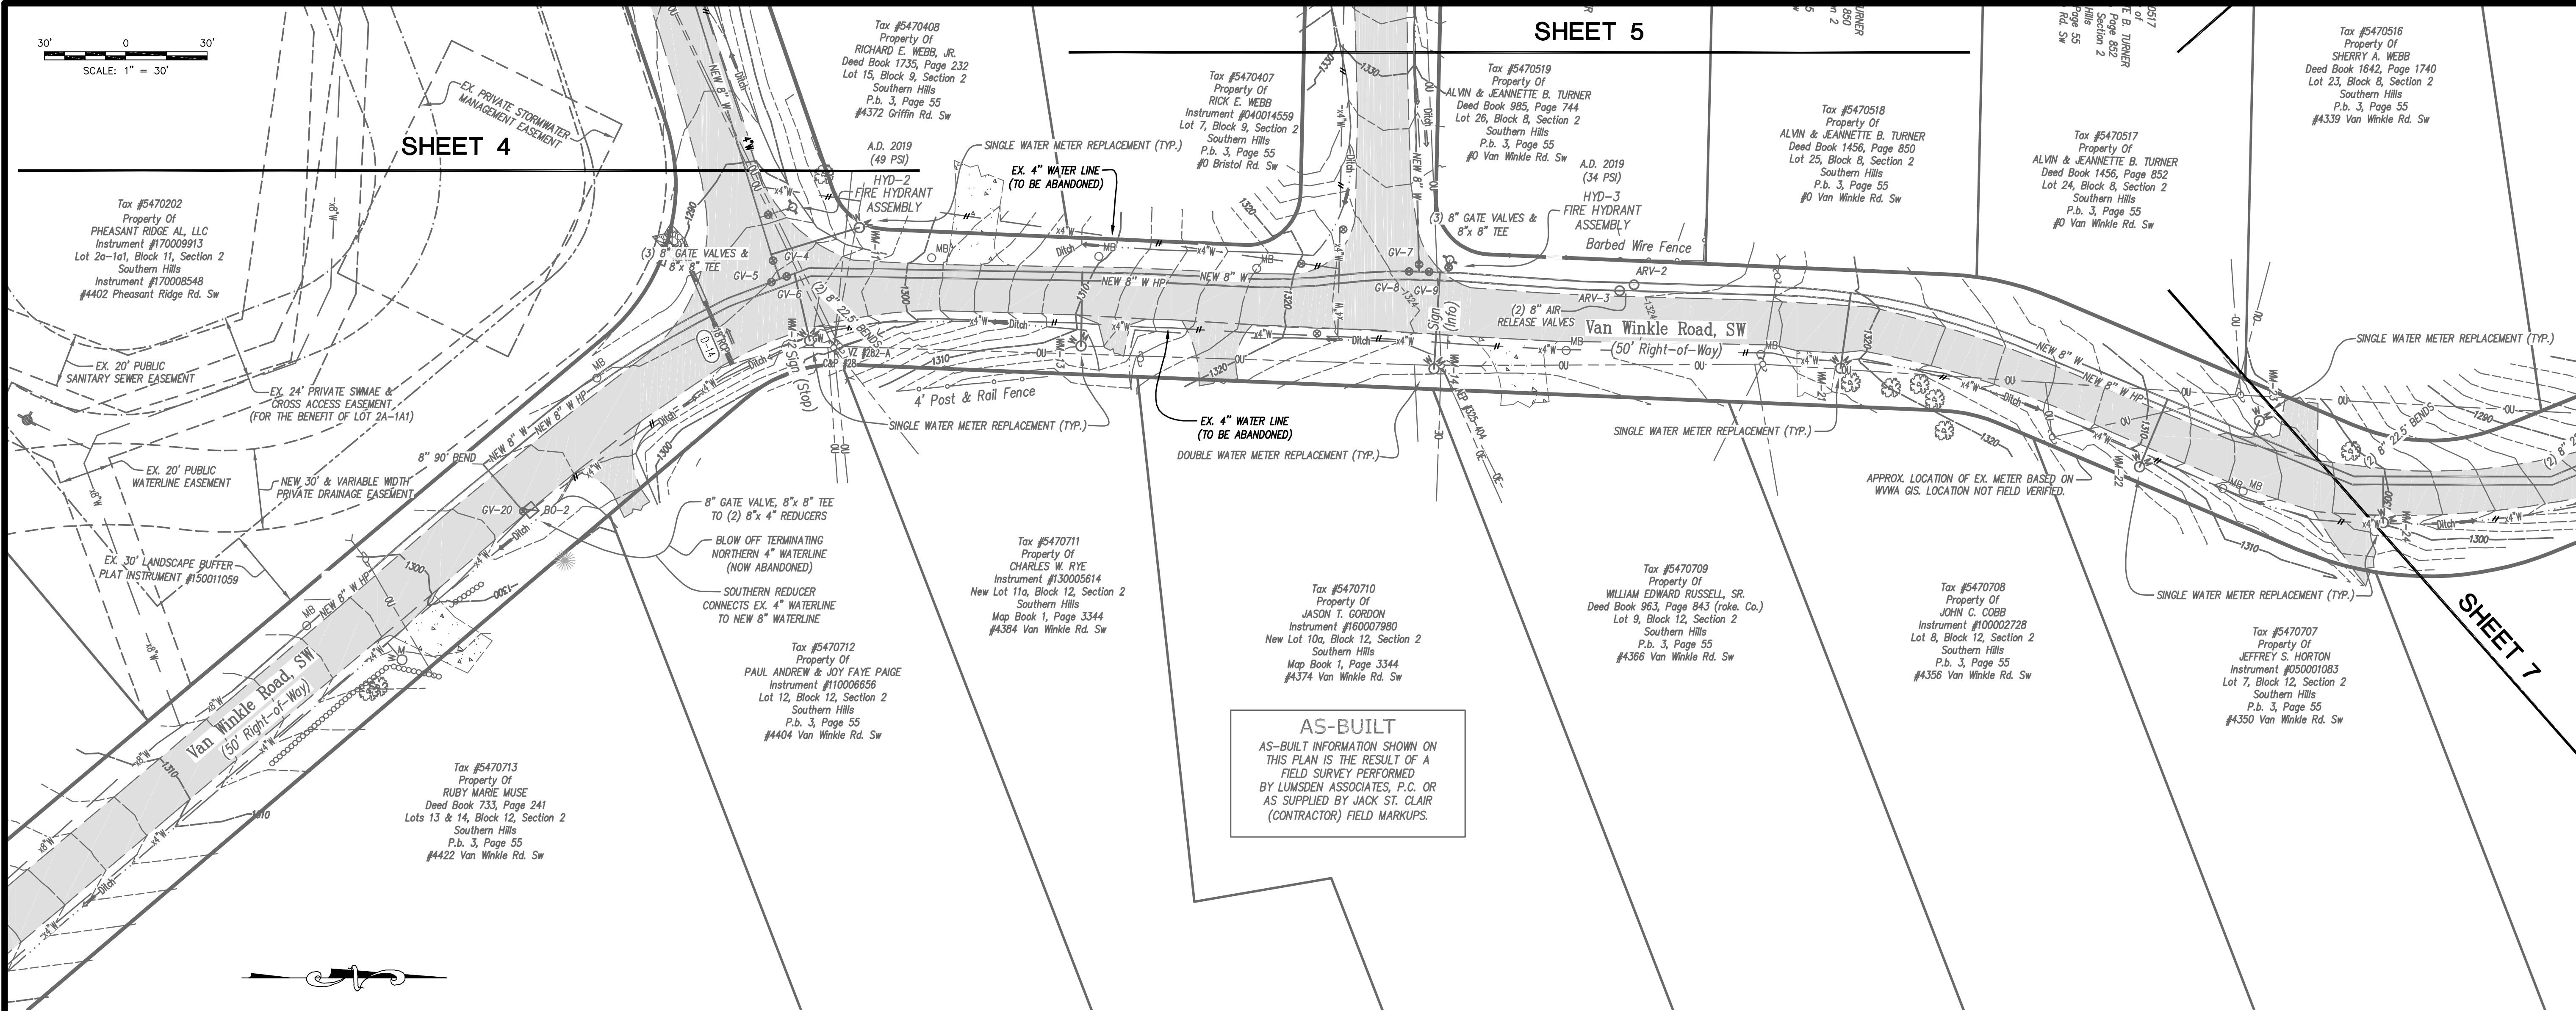

NOTE:
CONTRACTOR AS-BUILT FIELD MARKUPS AS SUPPLIED BY JACK ST. CLAIR
INDICATED NO VERTICAL DEVIATIONS FROM THE ORIGINAL PLANS. SEE SHEET 2
FOR FIELD SURVEYED INDIVIDUAL WATERLINE APPURTENANCE ELEVATIONS.

REVISIONS

NO.	DATE	DESCRIPTION
1		
2		
3		
4		
5		

DATE:
September 30, 2020

SCALE:
1" = 30'

COMMISSION NO:
19-034 & 20-191


SHEET 6 OF 9

GRIFFIN / VAN WINKLE
WATERLINE REPLACEMENTS


PREPARED FOR
JACK ST. CLAIR, INC.
SITUATED IN
THE CITY OF ROANOKE, VIRGINIA

AS-BUILT
PLAN & PROFILE
SOUTHERN
VAN WINKLE ROAD

Lumsden Associates, P.C.
ENGINEERS | SURVEYORS | PLANNERS

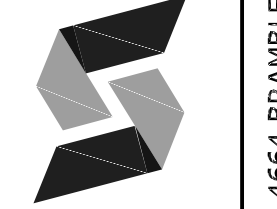

4664 BRAHMBLETON AVENUE
P.O. BOX 20669
ROANOKE, VIRGINIA 24018

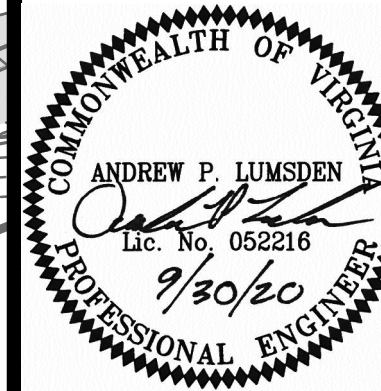

PHONE: (540) 774-4411
FAX: (540) 772-9445
WWW.LUMSDENPC.COM