



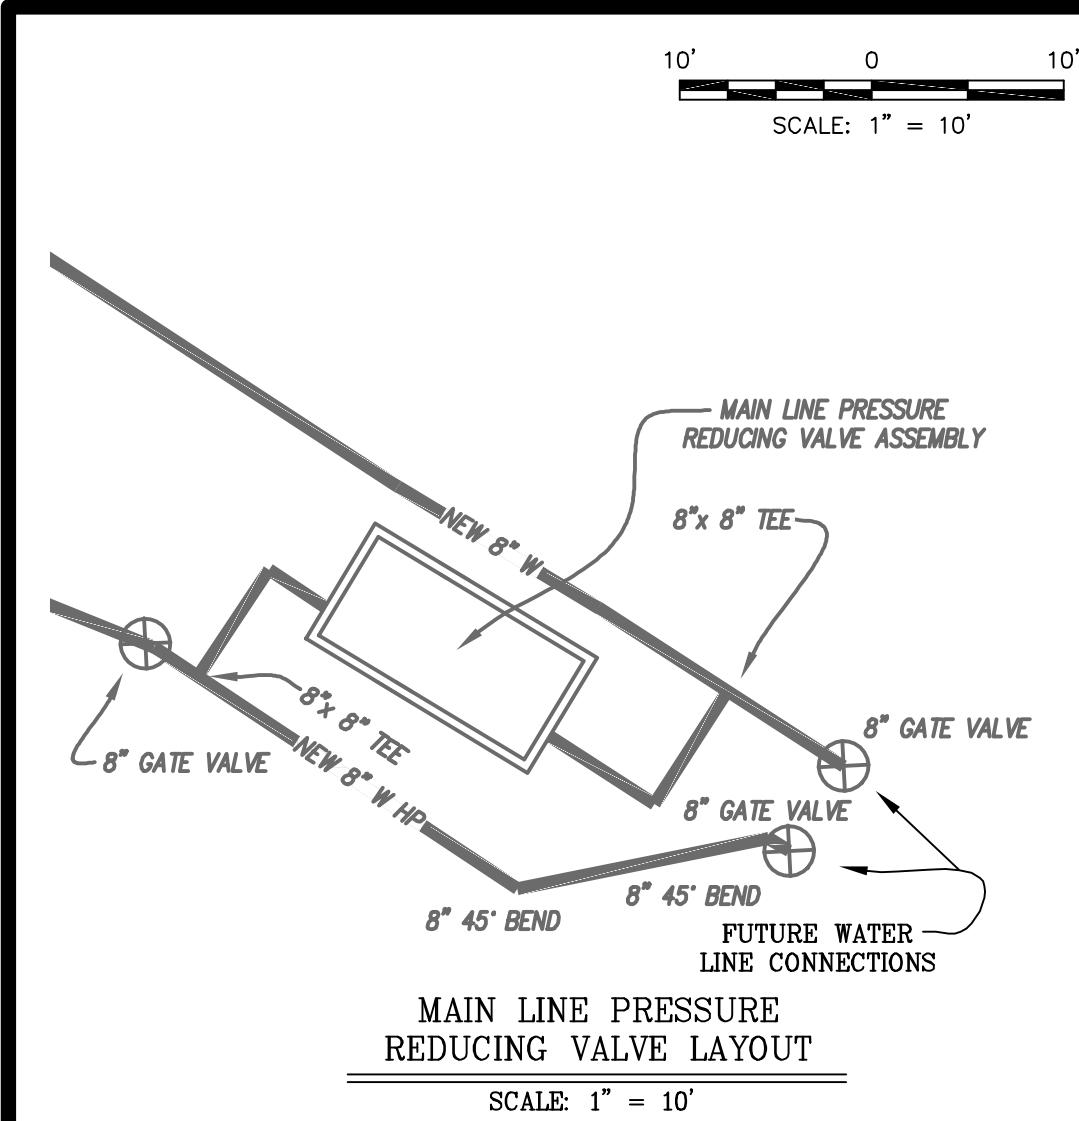

NOTE:
CONTRACTOR AS-BUILT FIELD MARKUPS AS SUPPLIED BY JACK ST. CLAIR
INDICATED NO VERTICAL DEVIATIONS FROM THE ORIGINAL PLANS. SEE SHEET 2
FOR FIELD SURVEYED INDIVIDUAL WATERLINE APPURTENANCE ELEVATIONS.

REVISIONS		
NO.	DATE	DESCRIPTION
1		
2		
3		
4		
5		

DATE:	September 30, 2020
SCALE:	1" = 30'
COMMISSION NO:	19-034 & 20-191
SHEET	7 OF 9

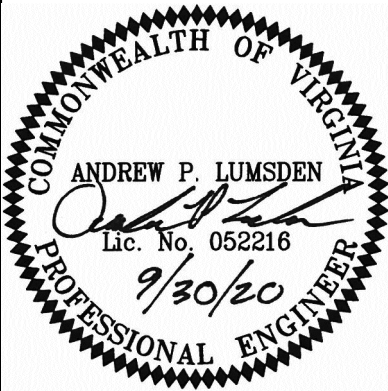

**AS-BUILT
PLAN & PROFILE
NORTHERN
VAN WINKLE ROAD**

**GRIFFIN / VAN WINKLE
WATERLINE REPLACEMENTS**

PREPARED FOR
JACK ST. CLAIR, INC.
SITUATED IN
THE CITY OF ROANOKE, VIRGINIA