



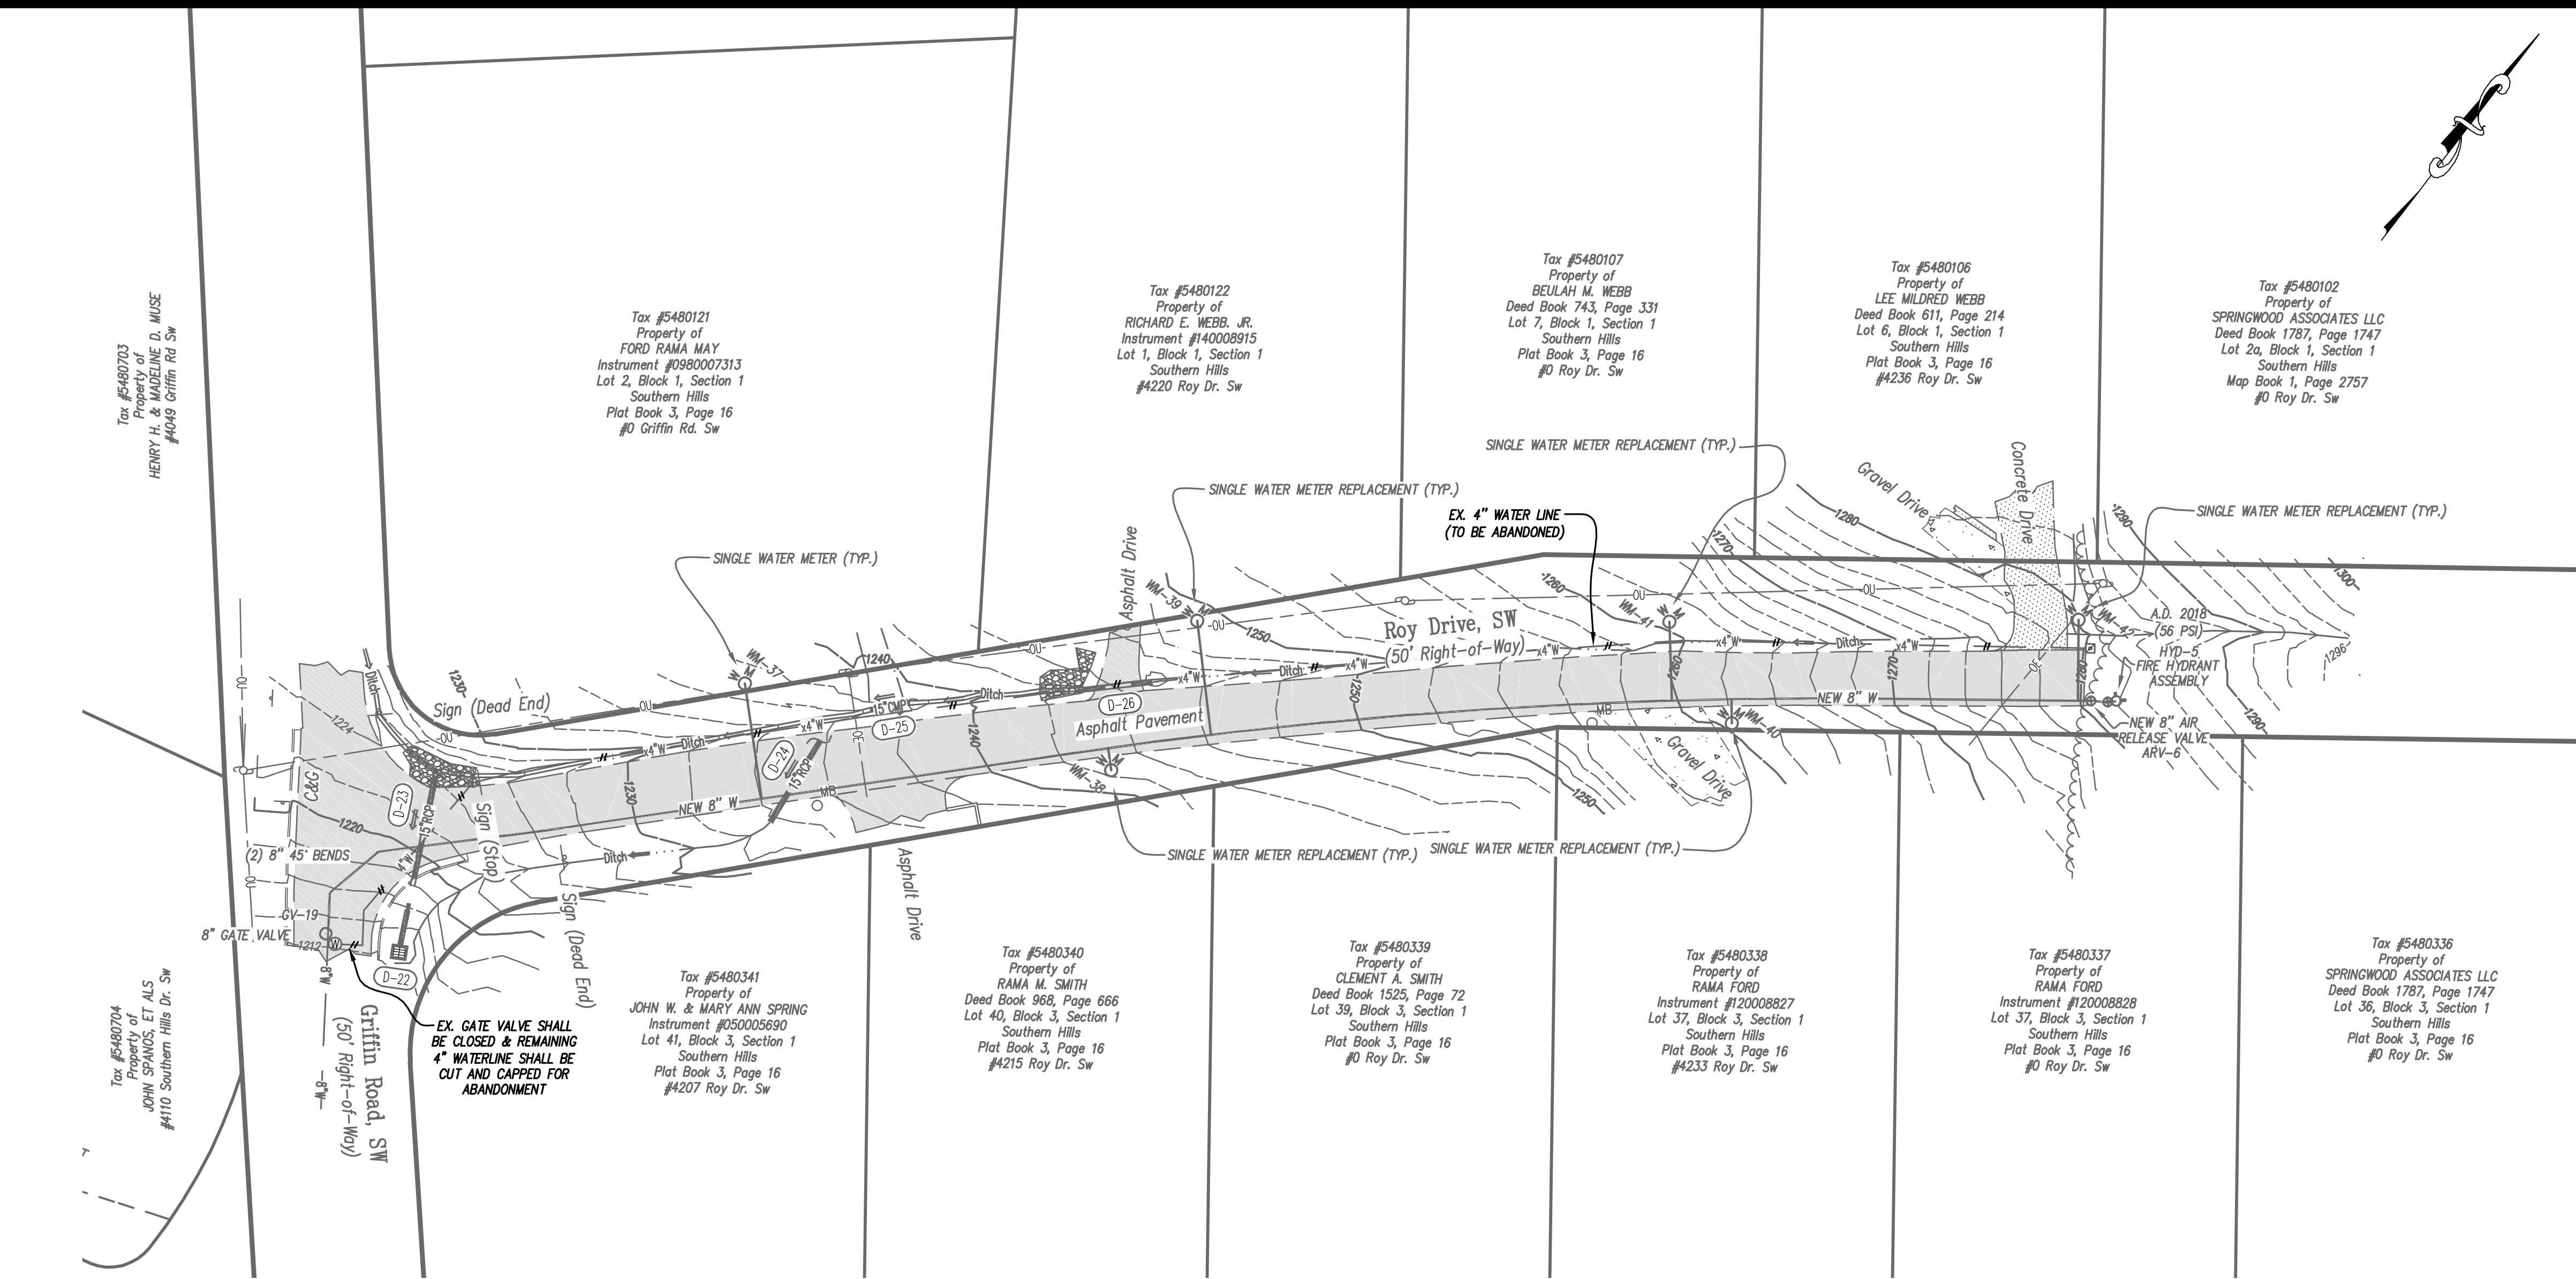

AS-BUILT
AS-BUILT INFORMATION SHOWN ON THIS PLAN IS THE RESULT OF A FIELD SURVEY PERFORMED BY LUMSDEN ASSOCIATES, P.C. OR AS SUPPLIED BY JACK ST. CLAIR (CONTRACTOR) FIELD MARKUPS.

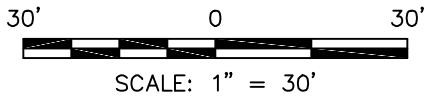


NOTE:
CONTRACTOR AS-BUILT FIELD MARKUPS AS SUPPLIED BY JACK ST. CLAIR INDICATED NO VERTICAL DEVIATIONS FROM THE ORIGINAL PLANS. SEE SHEET 2 FOR FIELD SURVEYED INDIVIDUAL WATERLINE APPURTENANCE ELEVATIONS.

REVISIONS		DATE		DESCRIPTION	
NO.					
1					
2					
3					
4					
5					

DATE: September 30, 2020
SCALE: 1" = 30'
COMMISSION NO: 19-034 & 20-191
SHEET 9 OF 9

GRIFFIN / VAN WINKLE
WATERLINE REPLACEMENTS
PREPARED FOR
JACK ST. CLAIR, INC.
SITUATED IN
THE CITY OF ROANOKE, VIRGINIA

AS-BUILT
PLAN & PROFILE
ROY DRIVE

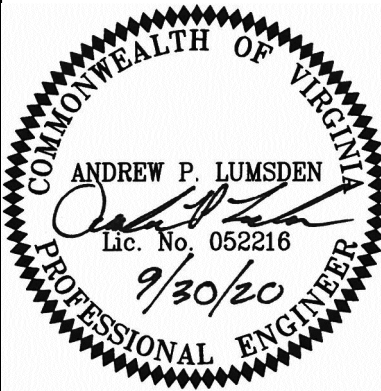

Lumsden Associates, P.C.
ENGINEERS | SURVEYORS | PLANNERS
4664 BRAMBLETON AVENUE
P.O. BOX 20669
ROANOKE, VIRGINIA 24018
PHONE: (540) 774-4411
FAX: (540) 772-9445
WWW.LUMSDENPC.COM