


19034-comp-as-built-01-cv01.plt

w:\drawings\2019\2019-03\401-cad\01-engineering\02-design\as-built\19034-comp-as-built.dwg

AS-BUILT GRIFFIN / VAN WINKLE WATERLINE REPLACEMENTS


SITUATED IN
THE CITY OF ROANOKE, VIRGINIA
DATE: SEPTEMBER 30, 2020
PREPARED FOR
JACK ST. CLAIR, INC.

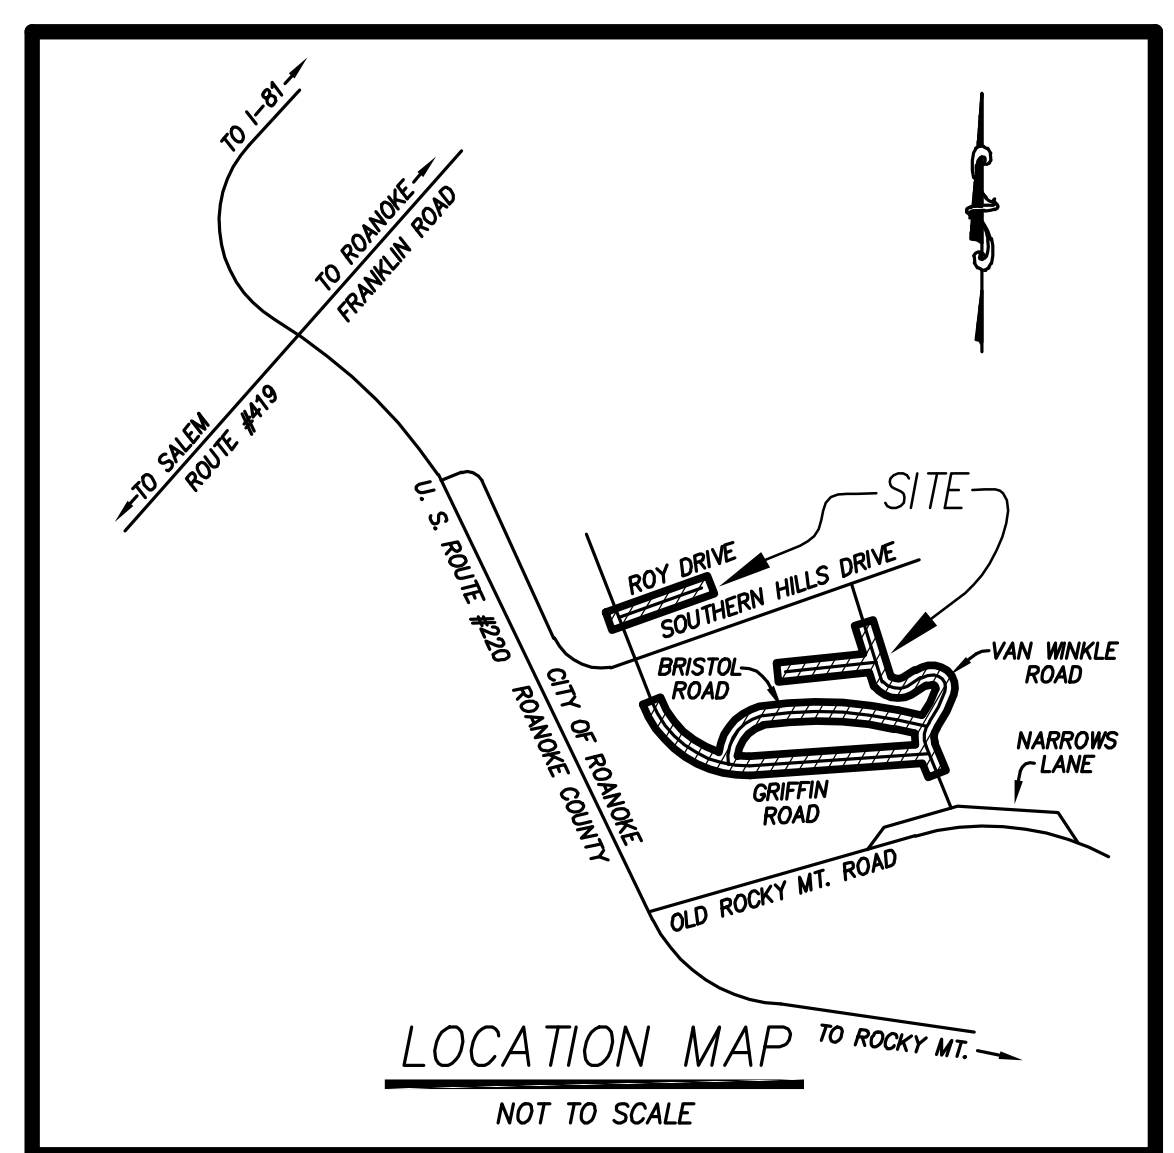

--INDEX OF DRAWINGS--

SHEET No.	DESCRIPTION
1	LUMSDEN ASSOCIATES COVER SHEET
2	SHEET LAYOUT & PROJECT OVERVIEW
3	PLAN & PROFILE EASTERN GRIFFIN ROAD
4	PLAN & PROFILE WESTERN GRIFFIN ROAD
5	PLAN & PROFILE BRISTOL ROAD
6	PLAN & PROFILE SOUTHERN VAN WINKLE ROAD
7	PLAN & PROFILE NORTHERN VAN WINKLE ROAD
8	PLAN & PROFILE JOPLIN ROAD
9	PLAN & PROFILE ROY DRIVE


AS-BUILT
AS-BUILT INFORMATION SHOWN ON
THIS PLAN IS THE RESULT OF A
FIELD SURVEY PERFORMED
BY LUMSDEN ASSOCIATES, P.C. OR
AS SUPPLIED BY JACK ST. CLAIR
(CONTRACTOR) FIELD MARKUPS.

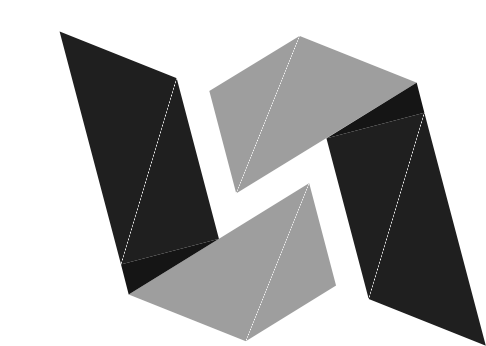

Lumsden Associates, P.C.
ENGINEERS | SURVEYORS | PLANNERS

4664 BRAMBLETON AVENUE, SW
P.O. BOX 20669
ROANOKE, VIRGINIA 24018


PHONE: (540) 774-4411
FAX: (540) 772-9445
WWW.LUMSDENPC.COM

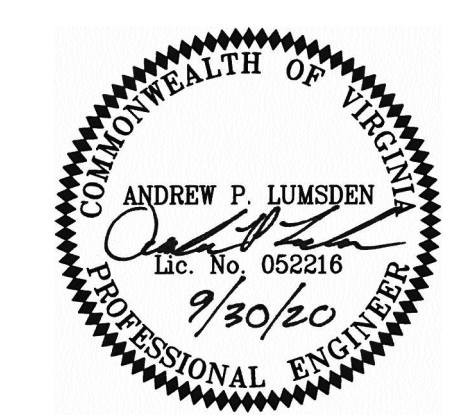

REVISIONS	
DATE	SHEETS
COMMISSION NO. 19-034 & 20-191	
SHEET 1 OF 9	

w:\drawings\19034-comp-as-built\19034-comp-as-built.dwg

19034-comp-as-built-03-pp01.plt

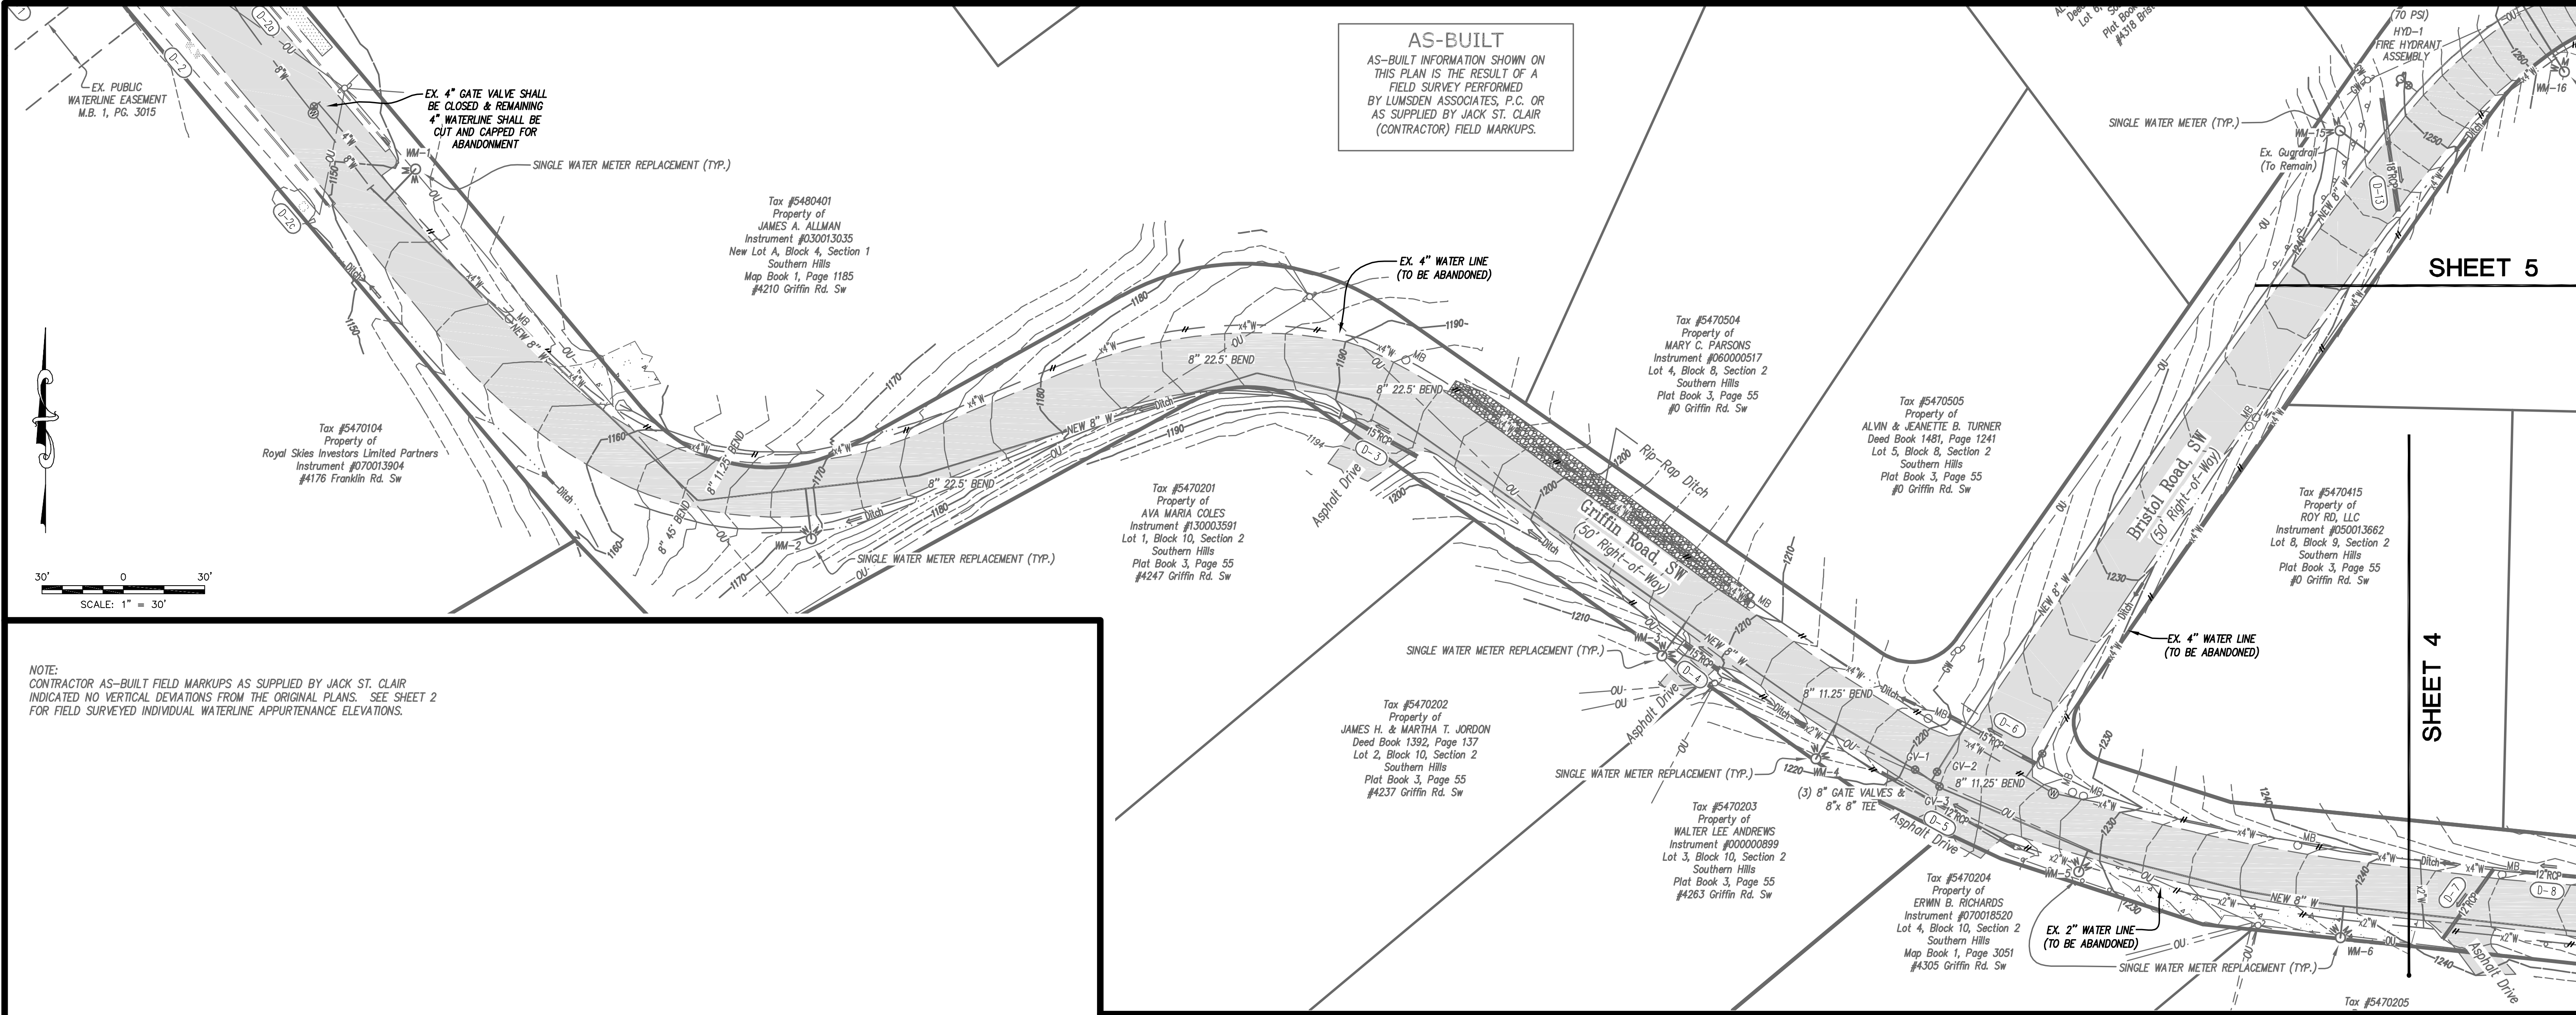

NOTE:
CONTRACTOR AS-BUILT FIELD MARKUPS AS SUPPLIED BY JACK ST. CLAIR
INDICATED NO VERTICAL DEVIATIONS FROM THE ORIGINAL PLANS. SEE SHEET 2
FOR FIELD SURVEYED INDIVIDUAL WATERLINE APPURTENANCE ELEVATIONS.

REVISIONS

NO.	DATE	DESCRIPTION
1		
2		
3		
4		
5		

DATE:

September 30, 2020

SCALE:

1" = 30'

COMMISSION NO:

19-034 & 20-191

SHEET 3 OF 9

GRIFFIN / VAN WINKLE
WATERLINE REPLACEMENTS

PREPARED FOR
JACK ST. CLAIR, INC.
SITUATED IN
THE CITY OF ROANOKE, VIRGINIA

AS-BUILT
PLAN & PROFILE
EASTERN GRIFFIN ROAD


COMMONWEALTH OF VIRGINIA
ANDREW P. LUMSDEN
Lic. No. 052216
9/30/20
PROFESSIONAL ENGINEER

Lumsden Associates, P.C.

ENGINEERS | SURVEYORS | PLANNERS

4664 BRAHMBLETON AVENUE
P.O. BOX 20669
ROANOKE, VIRGINIA 24018

PHONE: (540) 774-4411
FAX: (540) 772-9445
WWW.LUMSDENPC.COM

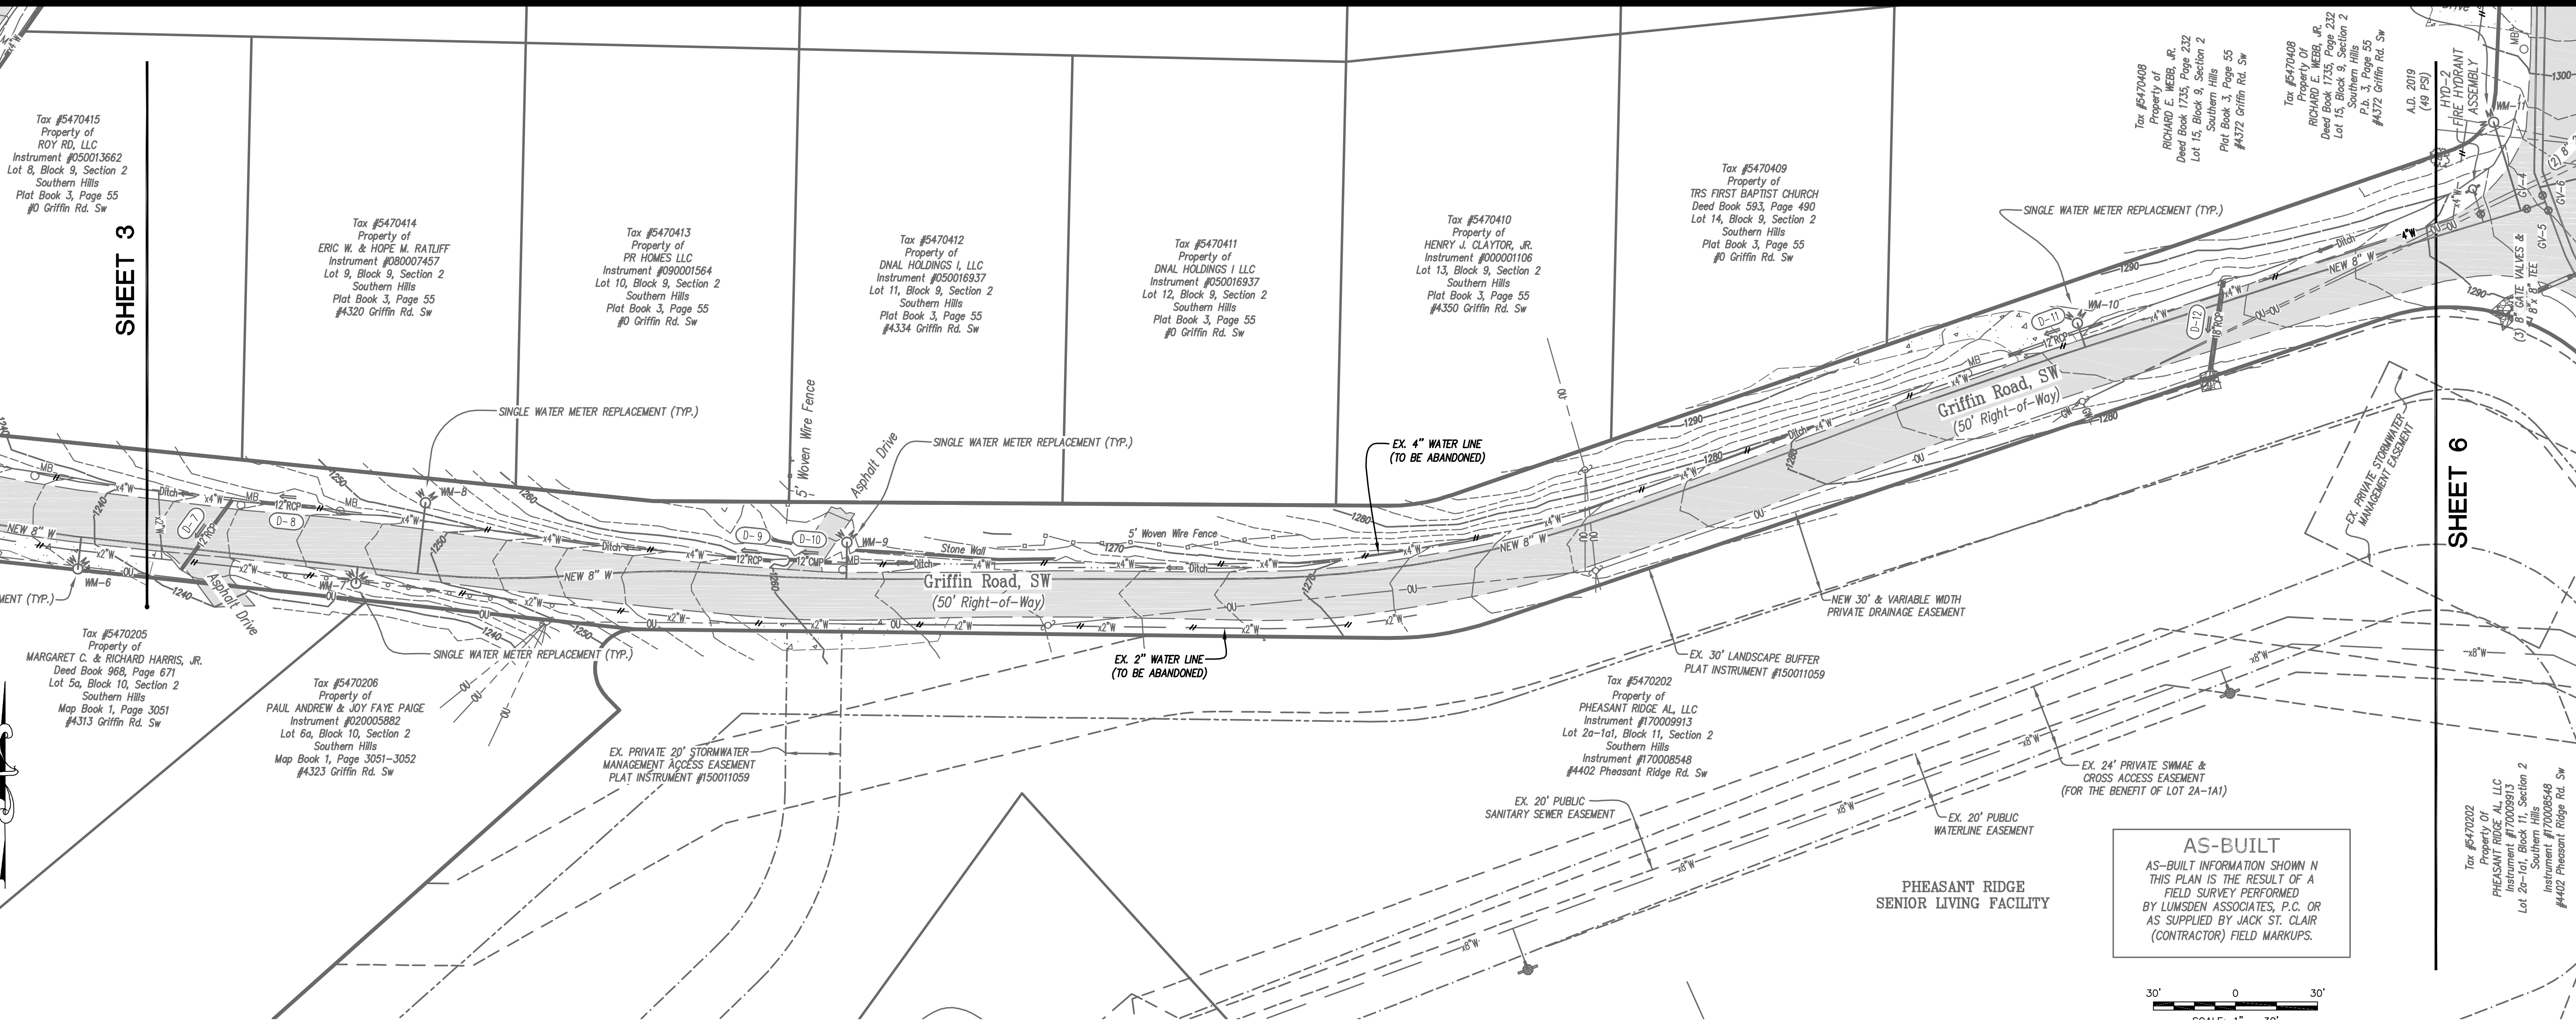

NOTE:
CONTRACTOR AS-BUILT FIELD MARKUPS AS SUPPLIED BY JACK ST. CLAIR
INDICATED NO VERTICAL DEVIATIONS FROM THE ORIGINAL PLANS. SEE SHEET 2
FOR FIELD SURVEYED INDIVIDUAL WATERLINE APPURTENANCE ELEVATIONS.

SHEET 3


SHEET 6


AS-BUILT
AS-BUILT INFORMATION SHOWN IN
THIS PLAN IS THE RESULT OF A
FIELD SURVEY PERFORMED
BY LUMSDEN ASSOCIATES, P.C. OR
AS SUPPLIED BY JACK ST. CLAIR
(CONTRACTOR) FIELD MARKUPS.

30' 0 30'
SCALE: 1" = 30'

**GRIFFIN / VAN WINKLE
WATERLINE REPLACEMENTS**
PREPARED FOR
JACK ST. CLAIR, INC.
SITUATED IN
THE CITY OF ROANOKE, VIRGINIA


**AS-BUILT
PLAN & PROFILE
WESTERN GRIFFIN ROAD**

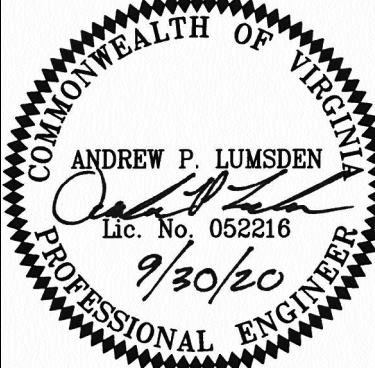

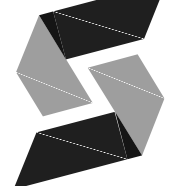Lumsden Associates, P.C.
ENGINEERS | SURVEYORS | PLANNERS

4664 BRAHMBLETON AVENUE
P.O. BOX 20669
ROANOKE, VIRGINIA 24018
PHONE: (540) 774-4411
FAX: (540) 772-9445
WWW.LUMSDENPC.COM

REVISIONS		DATE		DESCRIPTION	
NO.					
1					
2					
3					
4					
5					

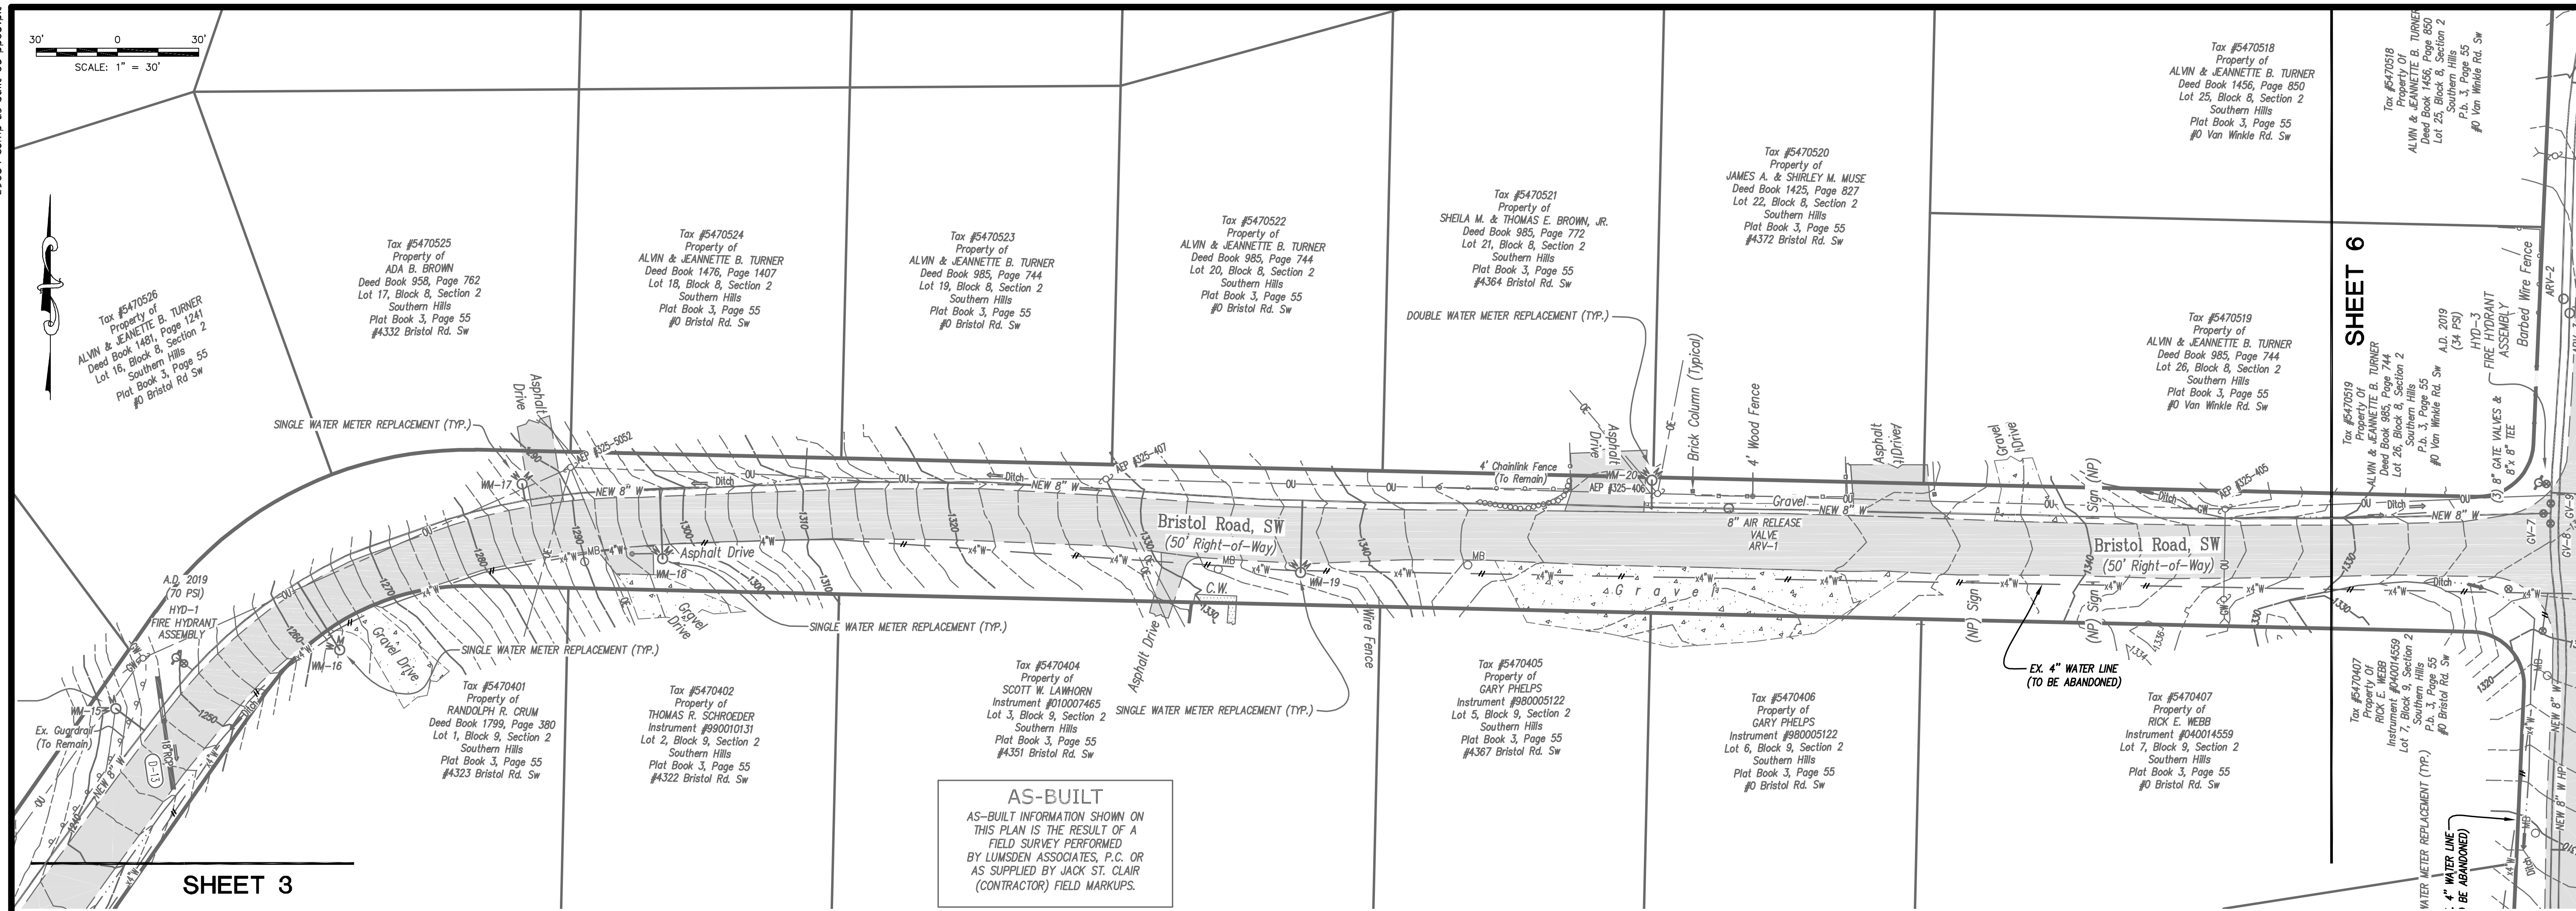DATE:
September 30, 2020
SCALE:
1" = 30'
COMMISSION NO:
19-034 & 20-191
SHEET 4 OF 9



NOTE:
CONTRACTOR AS-BUILT FIELD MARKUPS AS SUPPLIED BY JACK ST. CLAIR
INDICATED NO VERTICAL DEVIATIONS FROM THE ORIGINAL PLANS. SEE SHEET 2
FOR FIELD SURVEYED INDIVIDUAL WATERLINE APPURTENANCE ELEVATIONS.


REVISIONS		
NO.	DATE	DESCRIPTION
1		
2		
3		
4		
5		

DATE:	September 30, 2020
SCALE:	1" = 30'
COMMISSION NO:	19-034 & 20-191
SHEET 5 OF 9	

**GRIFFIN / VAN WINKLE
WATERLINE REPLACEMENTS**

PREPARED FOR
JACK ST. CLAIR, INC.
SITUATED IN
THE CITY OF ROANOKE, VIRGINIA

**AS-BUILT
PLAN & PROFILE
BRISTOL ROAD**

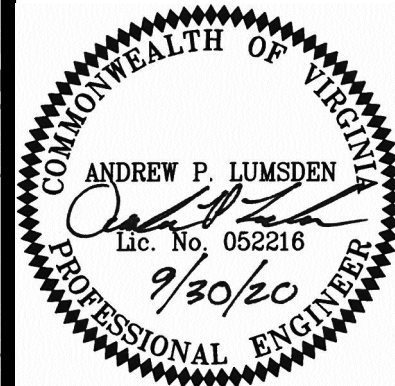


Lumsden Associates, P.C.
ENGINEERS | SURVEYORS | PLANNERS

4664 BRAMBLETON AVENUE
P.O. BOX 20669
ROANOKE, VIRGINIA 24018

PHONE: (540) 774-4411
FAX: (540) 772-9445
WWW.LUMSDENPC.COM

19034-comp-as-built-06-pp04.plt

w:\drawings\2019\2019-03\401-cad\01-engineering\02-design\as-built\19034-comp-as-built.dwg

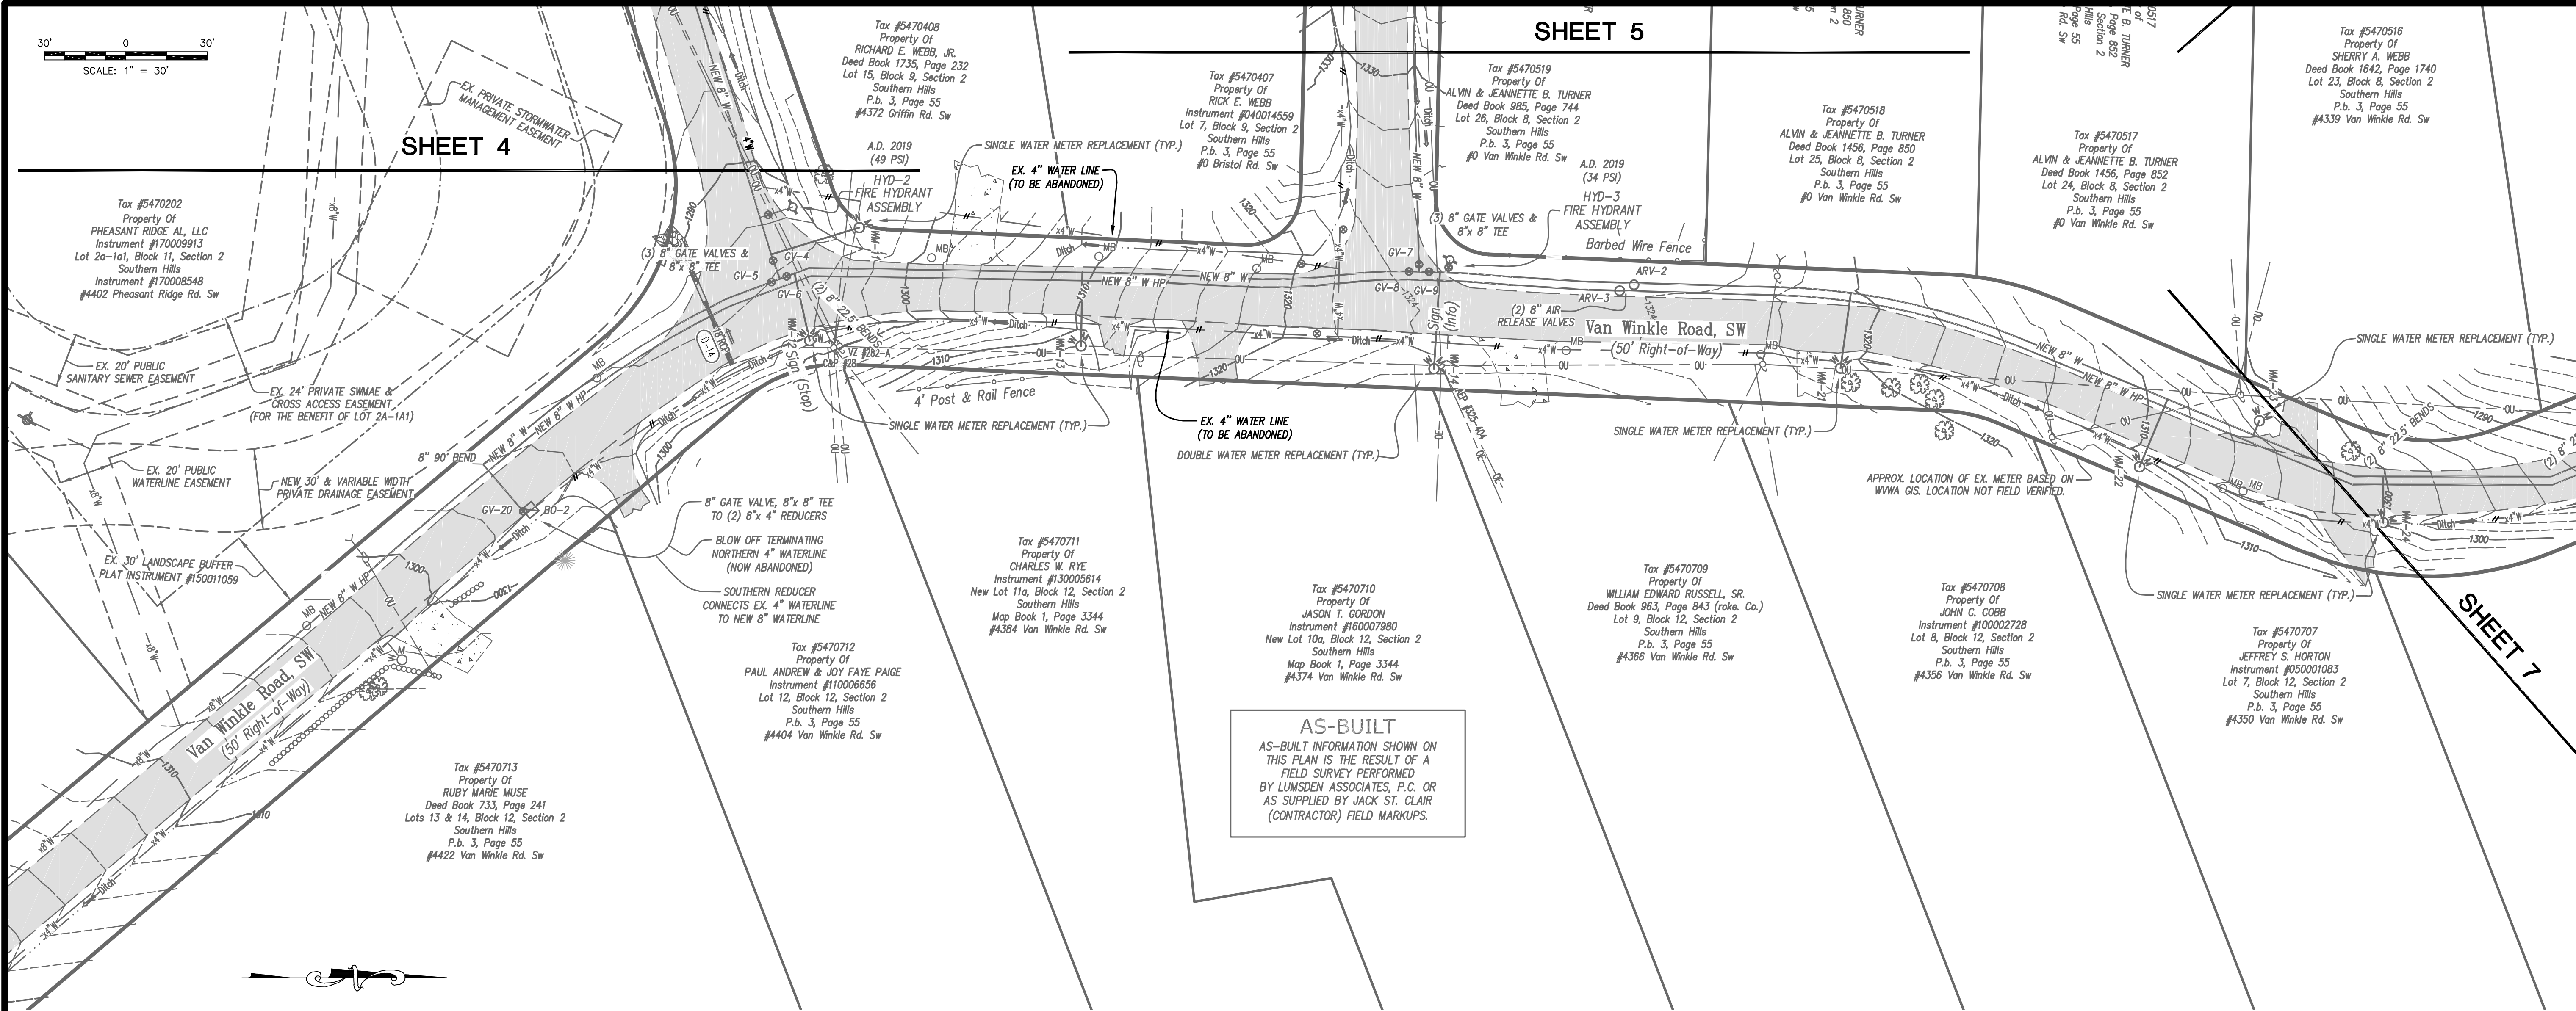

NOTE:
CONTRACTOR AS-BUILT FIELD MARKUPS AS SUPPLIED BY JACK ST. CLAIR
INDICATED NO VERTICAL DEVIATIONS FROM THE ORIGINAL PLANS. SEE SHEET 2
FOR FIELD SURVEYED INDIVIDUAL WATERLINE APPURTENANCE ELEVATIONS.

REVISIONS

NO.	DATE	DESCRIPTION
1		
2		
3		
4		
5		

DATE:
September 30, 2020

SCALE:
1" = 30'

COMMISSION NO:
19-034 & 20-191

SHEET 6 OF 9

GRIFFIN / VAN WINKLE
WATERLINE REPLACEMENTS

PREPARED FOR
JACK ST. CLAIR, INC.
SITUATED IN
THE CITY OF ROANOKE, VIRGINIA

AS-BUILT
PLAN & PROFILE
SOUTHERN
VAN WINKLE ROAD


COMMONWEALTH OF VIRGINIA
ANDREW P. LUMSDEN
Lic. No. 052216
9/30/20
PROFESSIONAL ENGINEER

Lumsden Associates, P.C.


ENGINEERS | SURVEYORS | PLANNERS

4664 BRAHMBLETON AVENUE
P.O. BOX 20669
ROANOKE, VIRGINIA 24018

PHONE: (540) 774-4411
FAX: (540) 772-9445
WWW.LUMSDENPC.COM

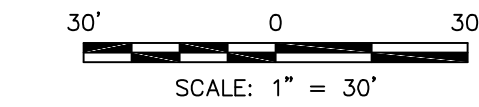


NOTE:
CONTRACTOR AS-BUILT FIELD MARKUPS AS SUPPLIED BY JACK ST. CLAIR
INDICATED NO VERTICAL DEVIATIONS FROM THE ORIGINAL PLANS. SEE SHEET 2
FOR FIELD SURVEYED INDIVIDUAL WATERLINE APPURTENANCE ELEVATIONS.

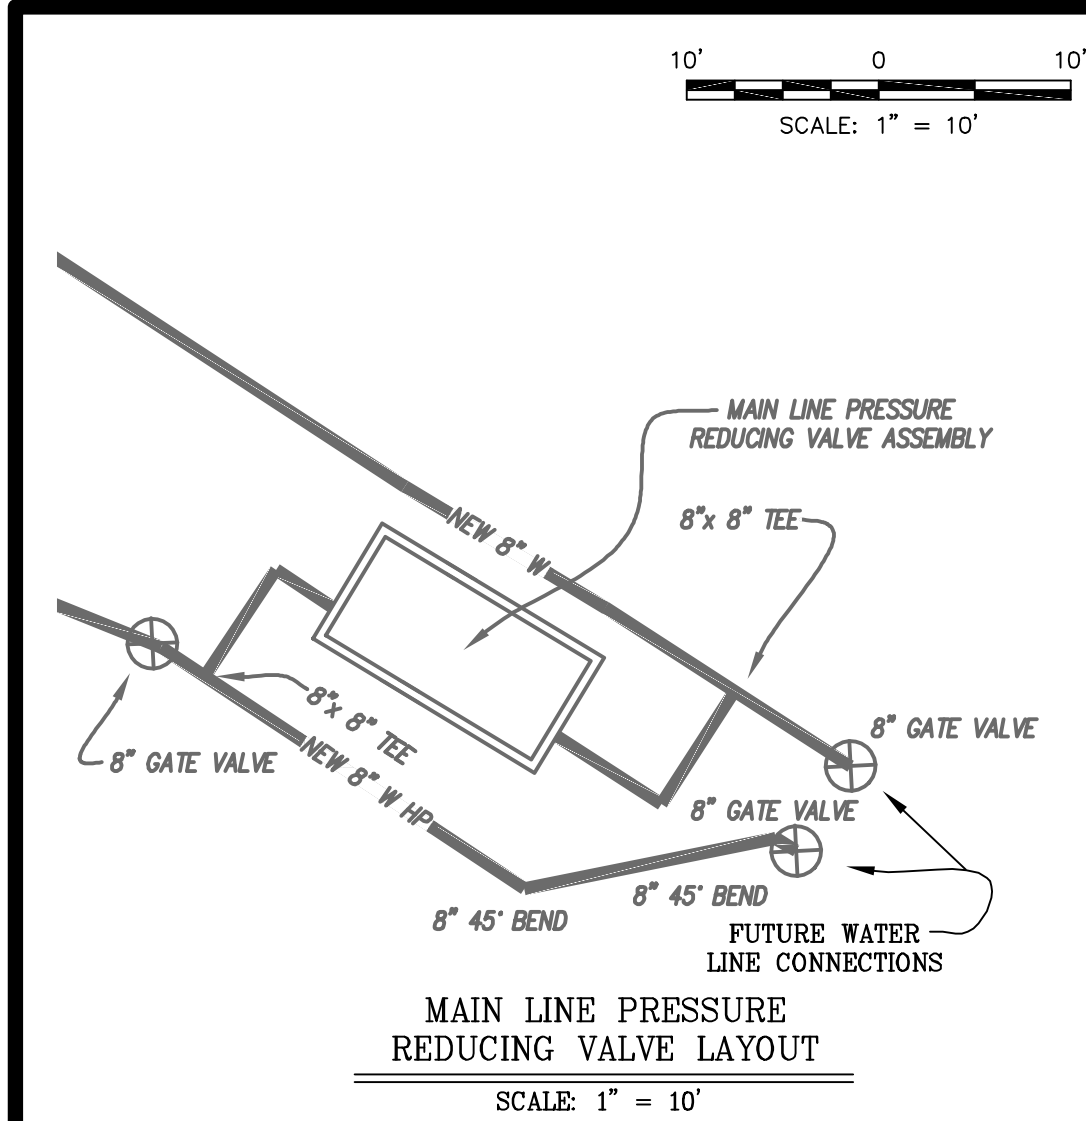

Lumsden Associates, P.C.
ENGINEERS | SURVEYORS | PLANNERS

 4664 BRAMBLETON AVENUE
P.O. BOX 20669
ROANOKE, VIRGINIA 24018

PHONE: (540) 774-4411
FAX: (540) 772-9445
WWW.LUMSDENPC.COM

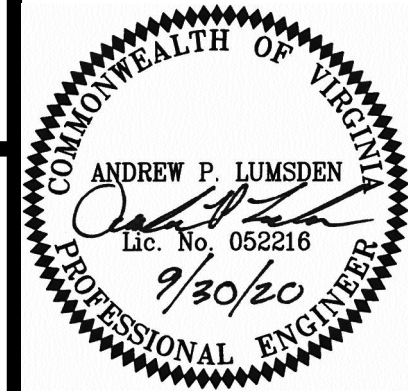

**AS-BUILT
PLAN & PROFILE
NORTHERN
VAN WINKLE ROAD**


**GRIFFIN / VAN WINKLE
WATERLINE REPLACEMENTS**

PREPARED FOR
JACK ST. CLAIR, INC.
SITUATED IN
THE CITY OF ROANOKE, VIRGINIA

REVISONS		
NO.	DATE	DESCRIPTION
1		
2		
3		
4		
5		

DATE:	September 30, 2020
SCALE:	1" = 30'
COMMISSION NO:	19-034 & 20-191
SHEET	7 OF 9


NOTE:
CONTRACTOR AS-BUILT FIELD MARKUPS AS SUPPLIED BY JACK ST. CLAIR
INDICATED NO VERTICAL DEVIATIONS FROM THE ORIGINAL PLANS. SEE SHEET 2
FOR FIELD SURVEYED INDIVIDUAL WATERLINE APPURTENANCE ELEVATIONS.

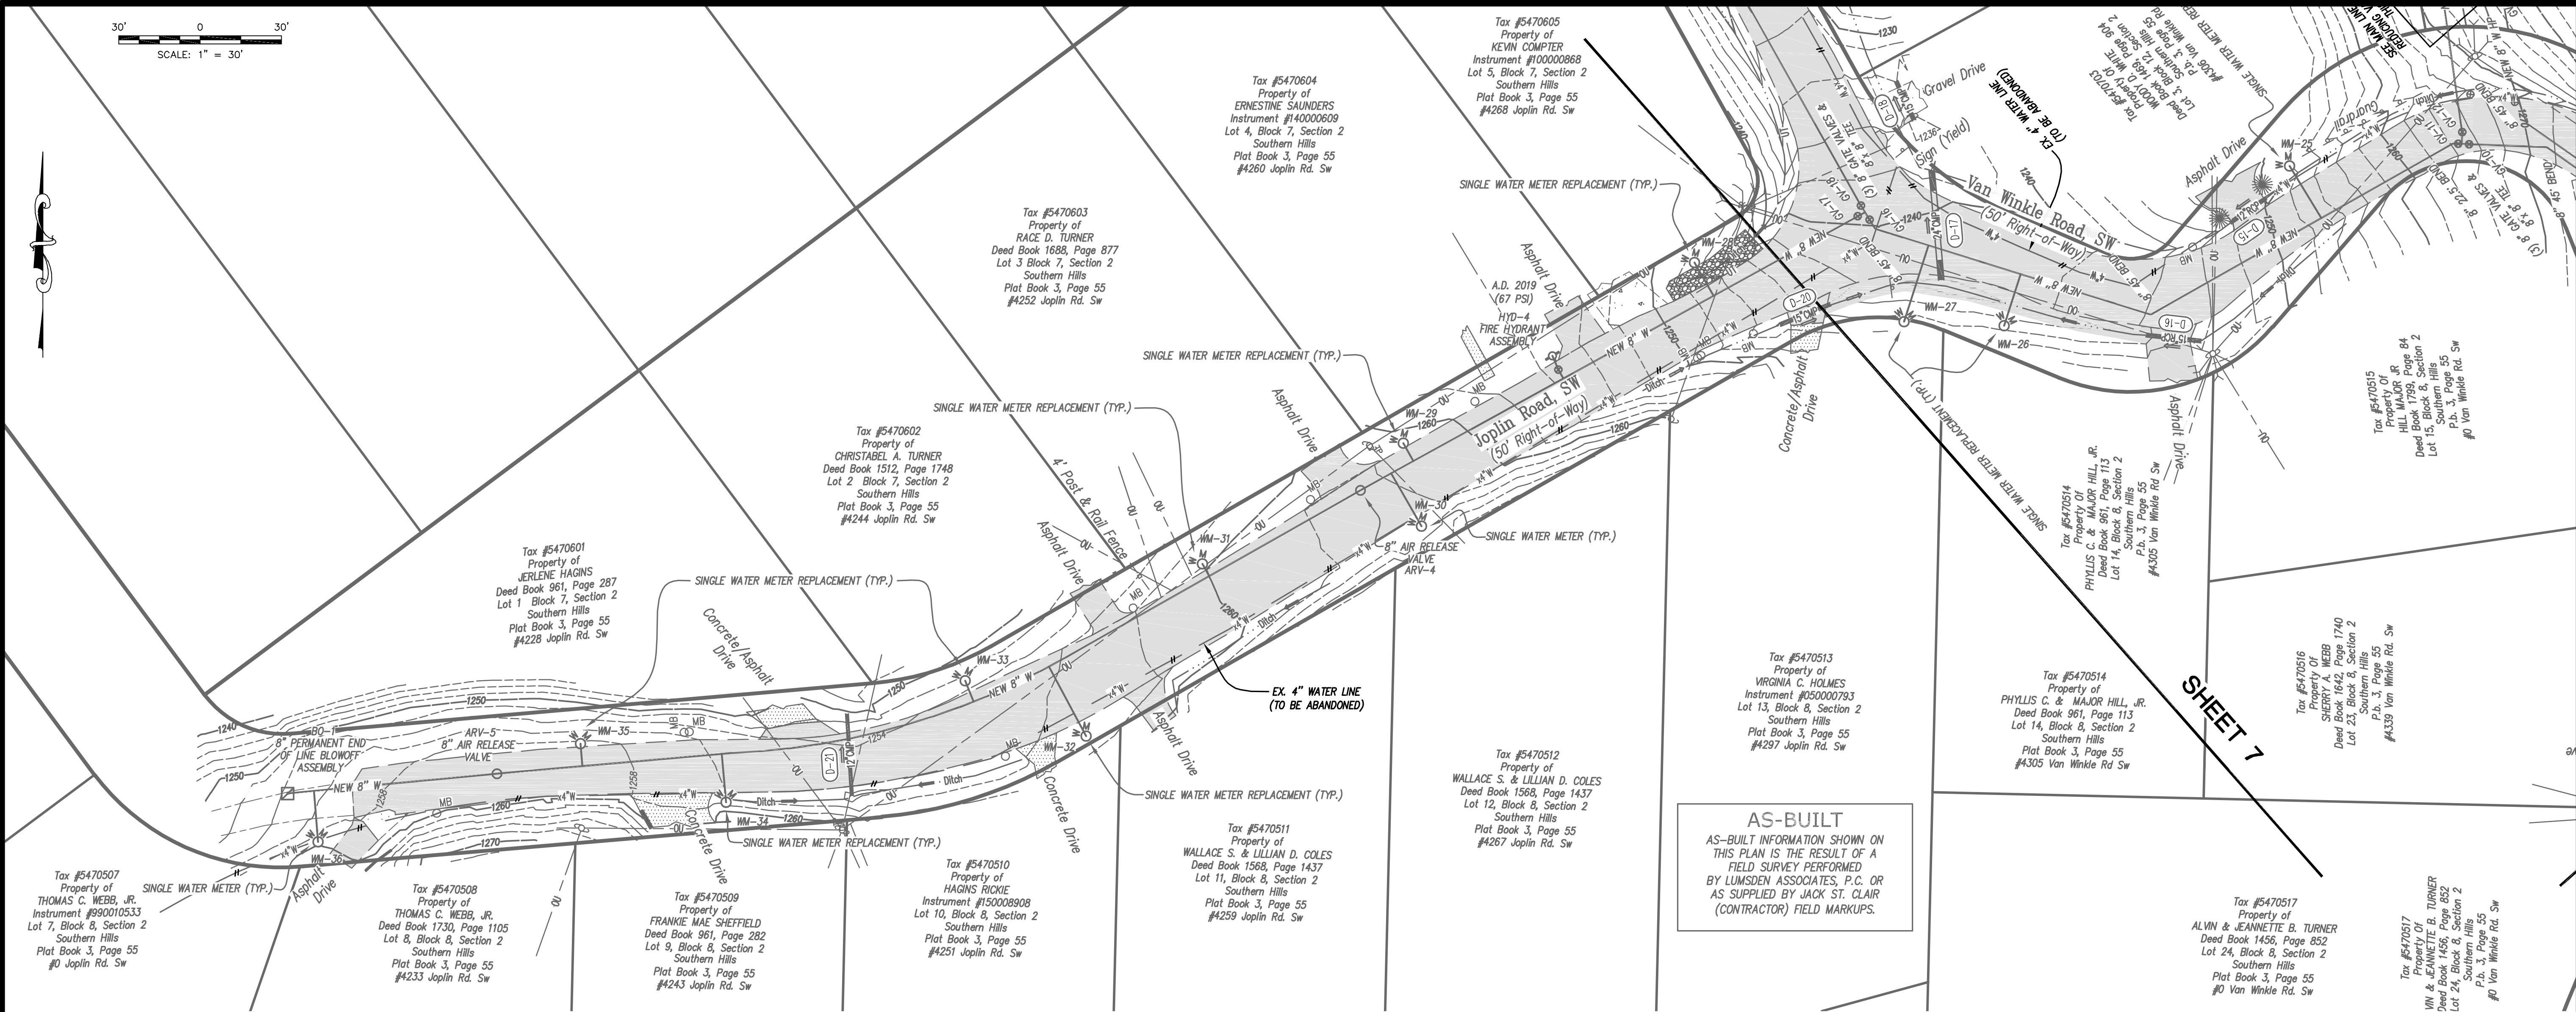

GRIFFIN / VAN WINKLE
WATERLINE REPLACEMENTS

PREPARED FOR
JACK ST. CLAIR, INC.
SITUATED IN
THE CITY OF ROANOKE, VIRGINIA


AS-BUILT
PLAN & PROFILE
JOPLIN ROAD

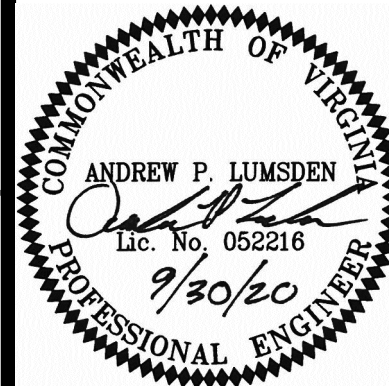



Lumsden Associates, P.C.
ENGINEERS | SURVEYORS | PLANNERS
4664 BRAHMBLETON AVENUE
P.O. BOX 20669
ROANOKE, VIRGINIA 24018
PHONE: (540) 774-4411
FAX: (540) 772-9445
WWW.LUMSDENPC.COM

REVISIONS		DESCRIPTION
NO.	DATE	
1		
2		
3		
4		
5		

DATE: September 30, 2020
SCALE: 1" = 30'
COMMISSION NO: 19-034 & 20-191
SHEET 8 OF 9

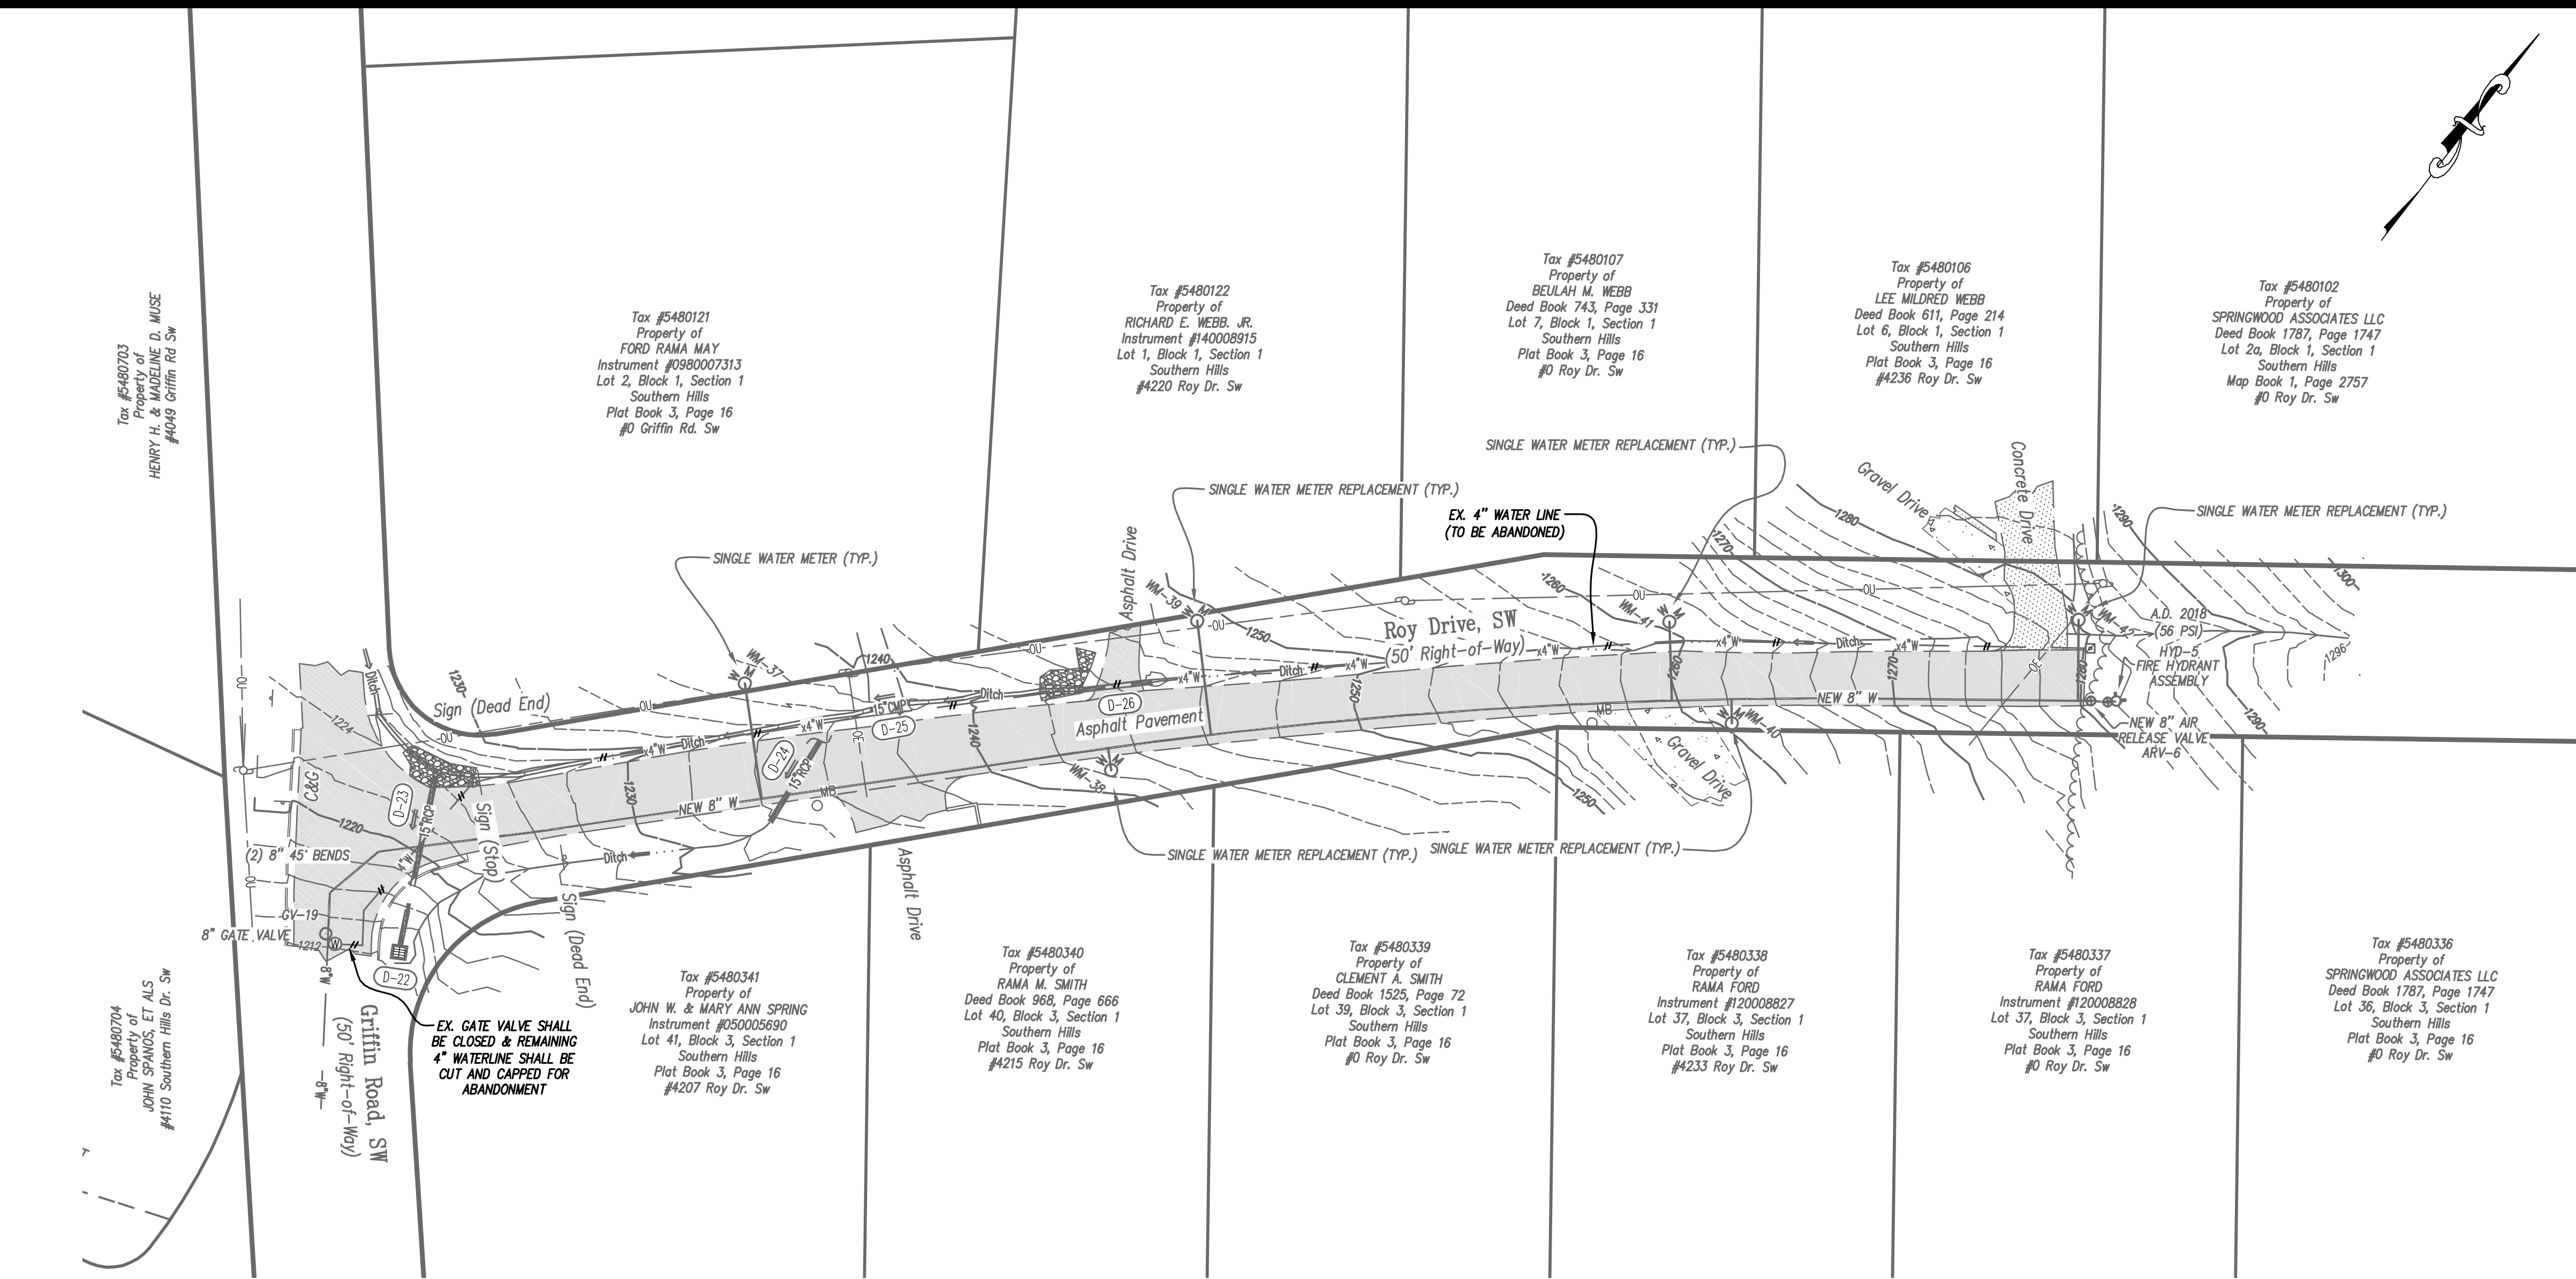

AS-BUILT
AS-BUILT INFORMATION SHOWN ON THIS PLAN IS THE RESULT OF A FIELD SURVEY PERFORMED BY LUMSDEN ASSOCIATES, P.C. OR AS SUPPLIED BY JACK ST. CLAIR (CONTRACTOR) FIELD MARKUPS.

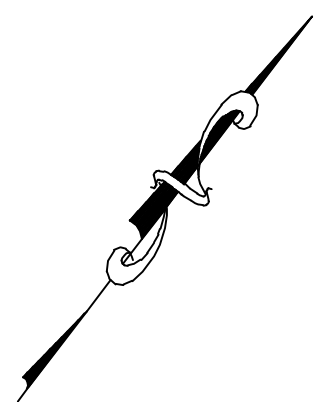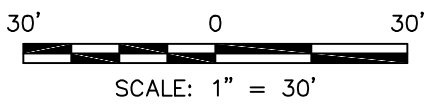


NOTE:
CONTRACTOR AS-BUILT FIELD MARKUPS AS SUPPLIED BY JACK ST. CLAIR INDICATED NO VERTICAL DEVIATIONS FROM THE ORIGINAL PLANS. SEE SHEET 2 FOR FIELD SURVEYED INDIVIDUAL WATERLINE APPURTENANCE ELEVATIONS.

Lumsden Associates, P.C.
ENGINEERS | SURVEYORS | PLANNERS

4664 BRAMBLETON AVENUE
P.O. BOX 20669
ROANOKE, VIRGINIA 24018

PHONE: (540) 774-4411
FAX: (540) 772-9445
WWW.LUMSDENPC.COM

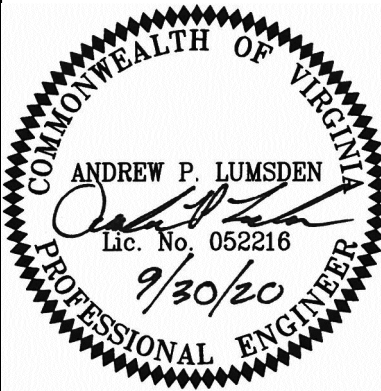

**AS-BUILT
PLAN & PROFILE
ROY DRIVE**

**GRIFFIN / VAN WINKLE
WATERLINE REPLACEMENTS**

PREPARED FOR
JACK ST. CLAIR, INC.
SITUATED IN
THE CITY OF ROANOKE, VIRGINIA

REVISIONS		DATE		DESCRIPTION	
NO.					
1					
2					
3					
4					
5					

DATE: September 30, 2020
SCALE: 1" = 30'
COMMISSION NO: 19-034 & 20-191
SHEET 9 OF 9