


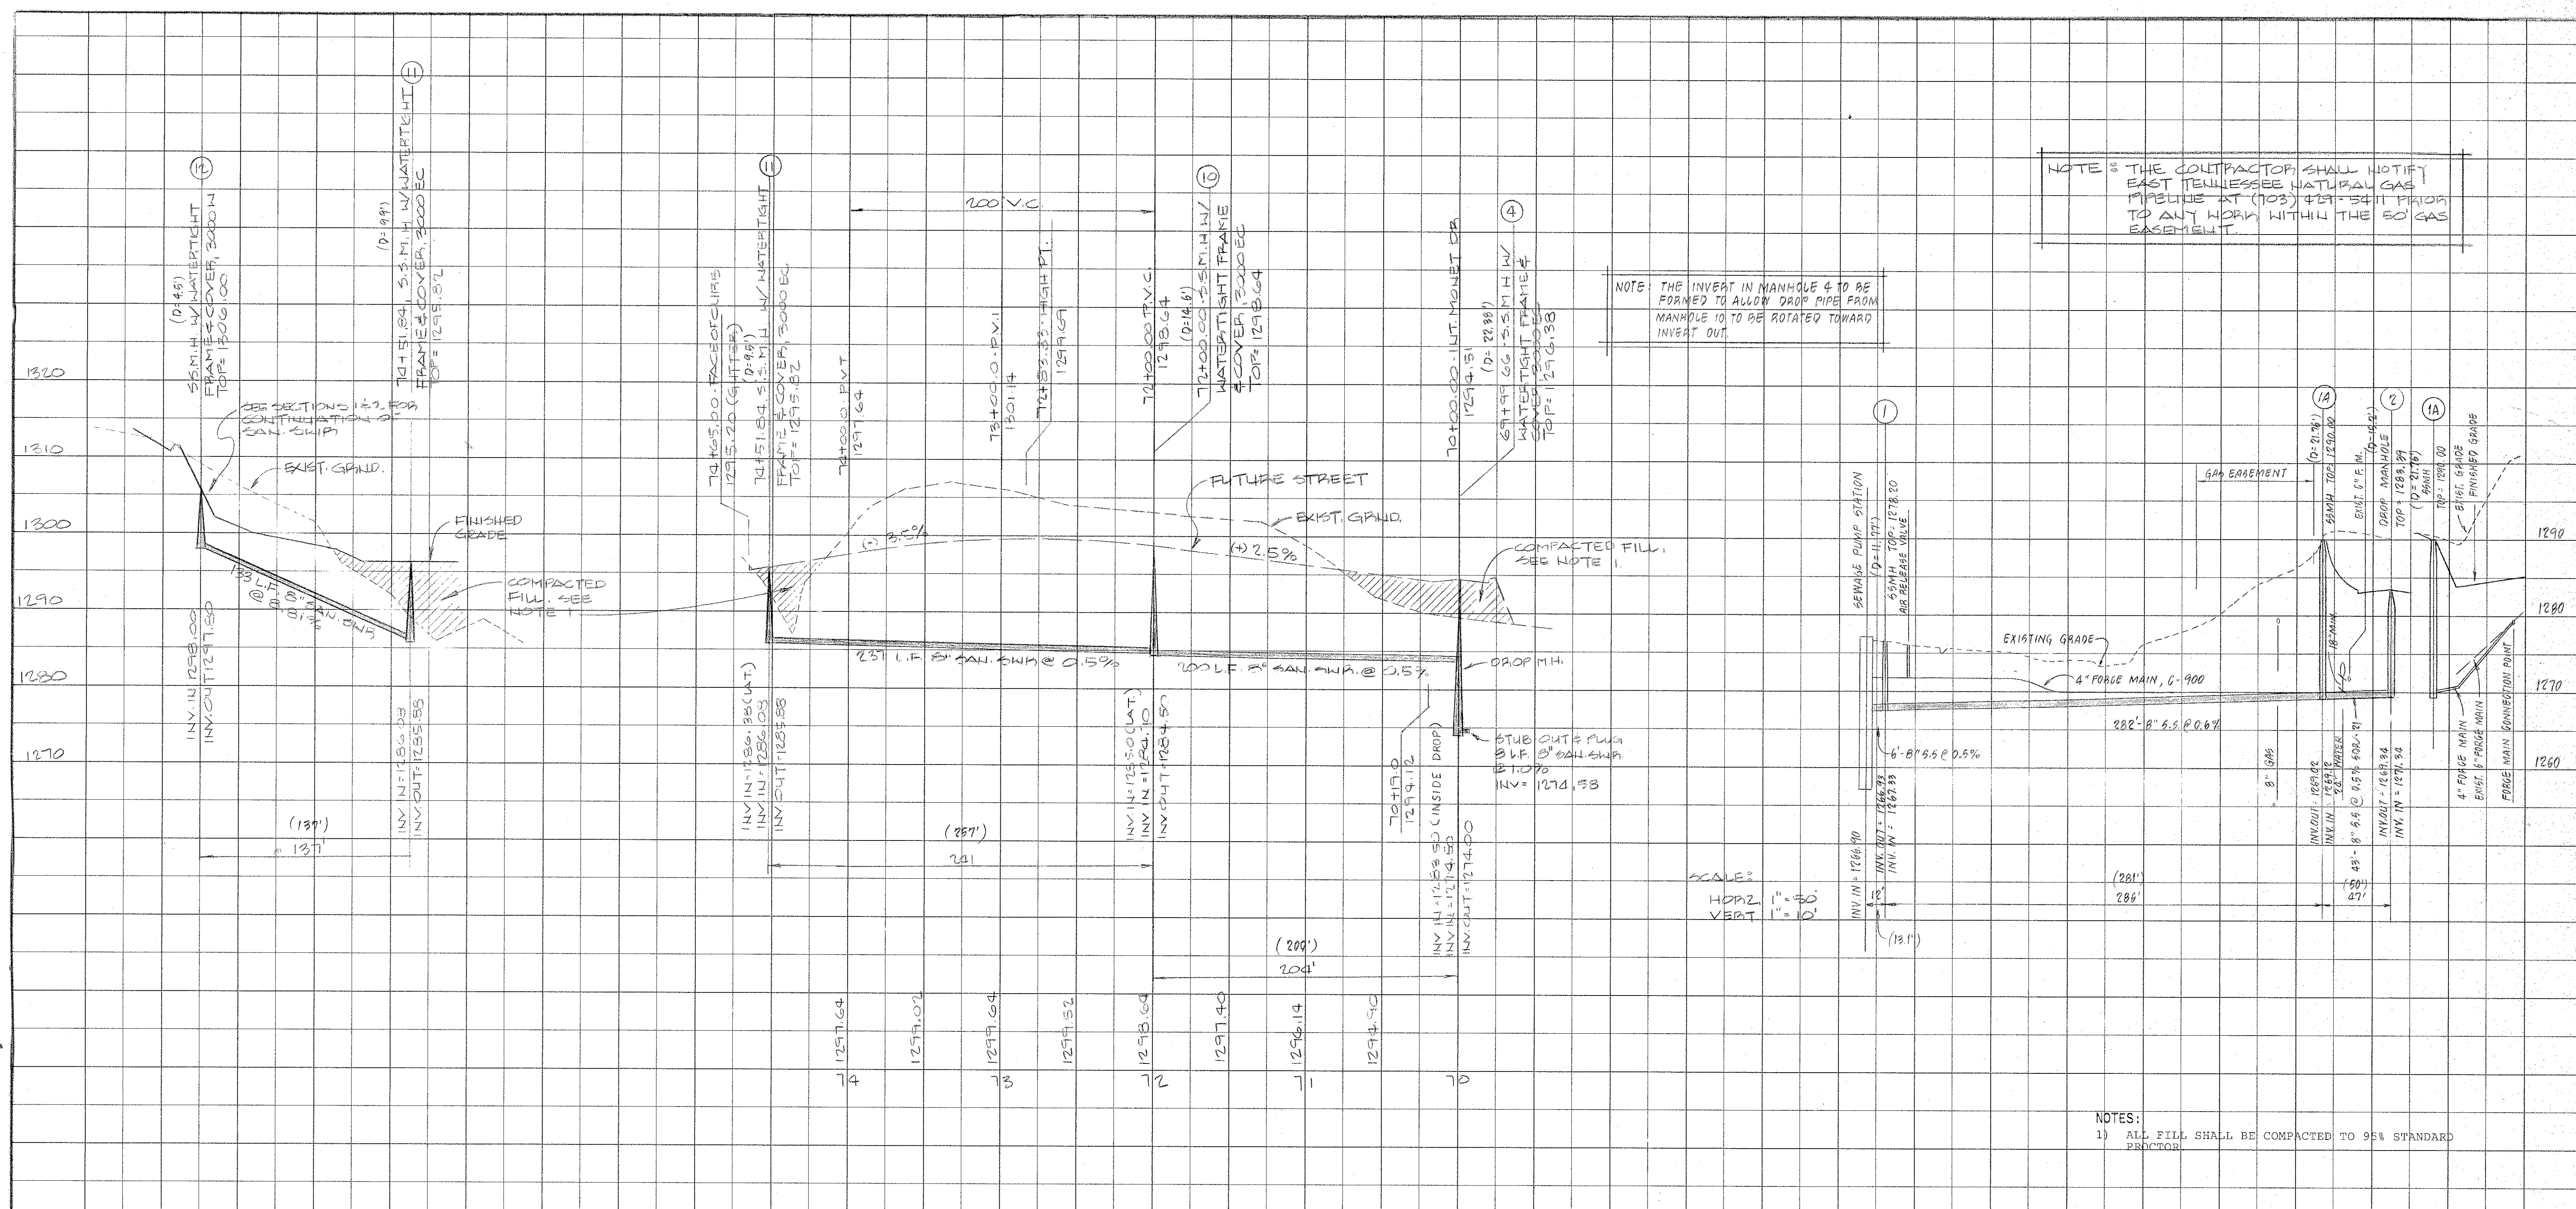


NOTE: THE CONTRACTOR SHALL NOTIFY EAST TENNESSEE NATURAL GAS PIPELINE AT (703) 474-5411 PRIOR TO ANY WORK WITHIN THE 50' GAS EASEMENT.


NOTE: THE INVERT IN MANHOLE 4 TO BE FORMED TO ALLOW DROP PIPE FROM MANHOLE 10 TO BE ROTATED TOWARD INVERT OUT.

SCALE:
HORIZ. 1" = 50'
VERT. 1" = 10'


NOTES:
1) ALL FILL SHALL BE COMPACTED TO 95% STANDARD PROCTOR.

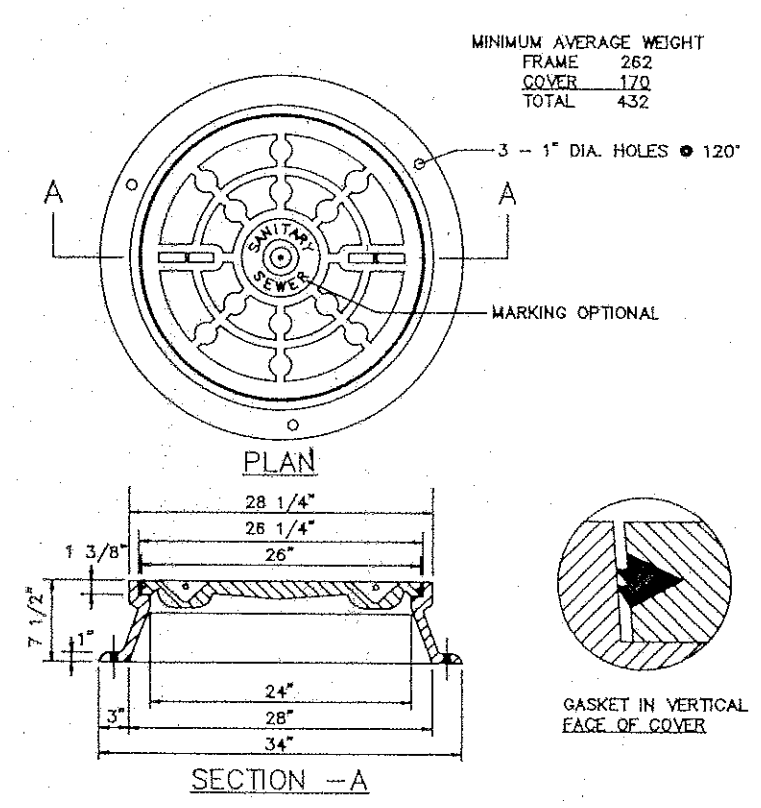

WATERTIGHT MANHOLE FRAME & COVER
INSTALLATION DETAIL
MH-RCR-3000W
PER DEWEY BROS., INC.

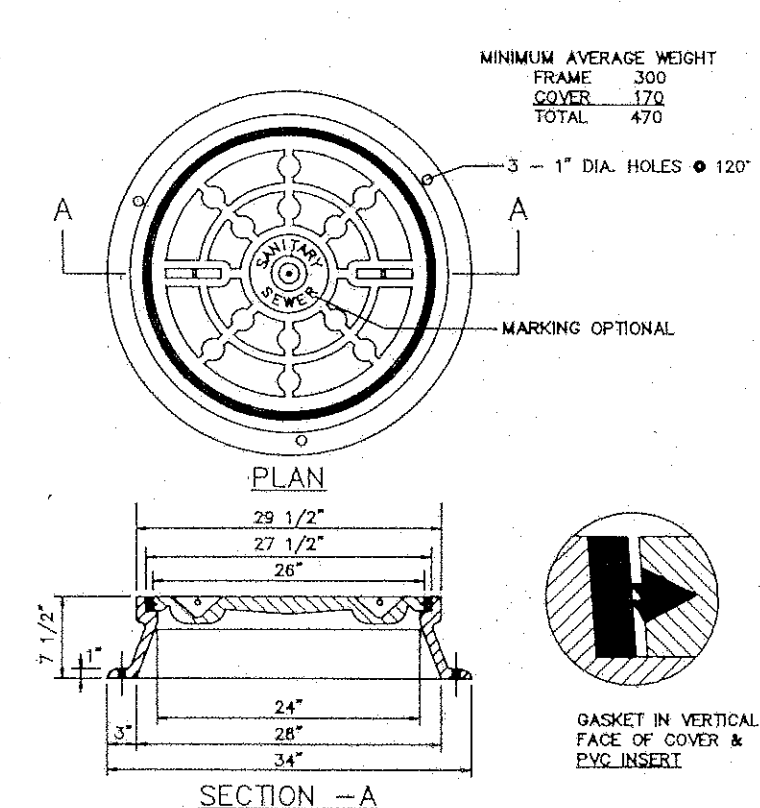

WATERTIGHT MANHOLE FRAME & COVER
MH-RCR-3000EC
PER DEWEY BROS., INC.

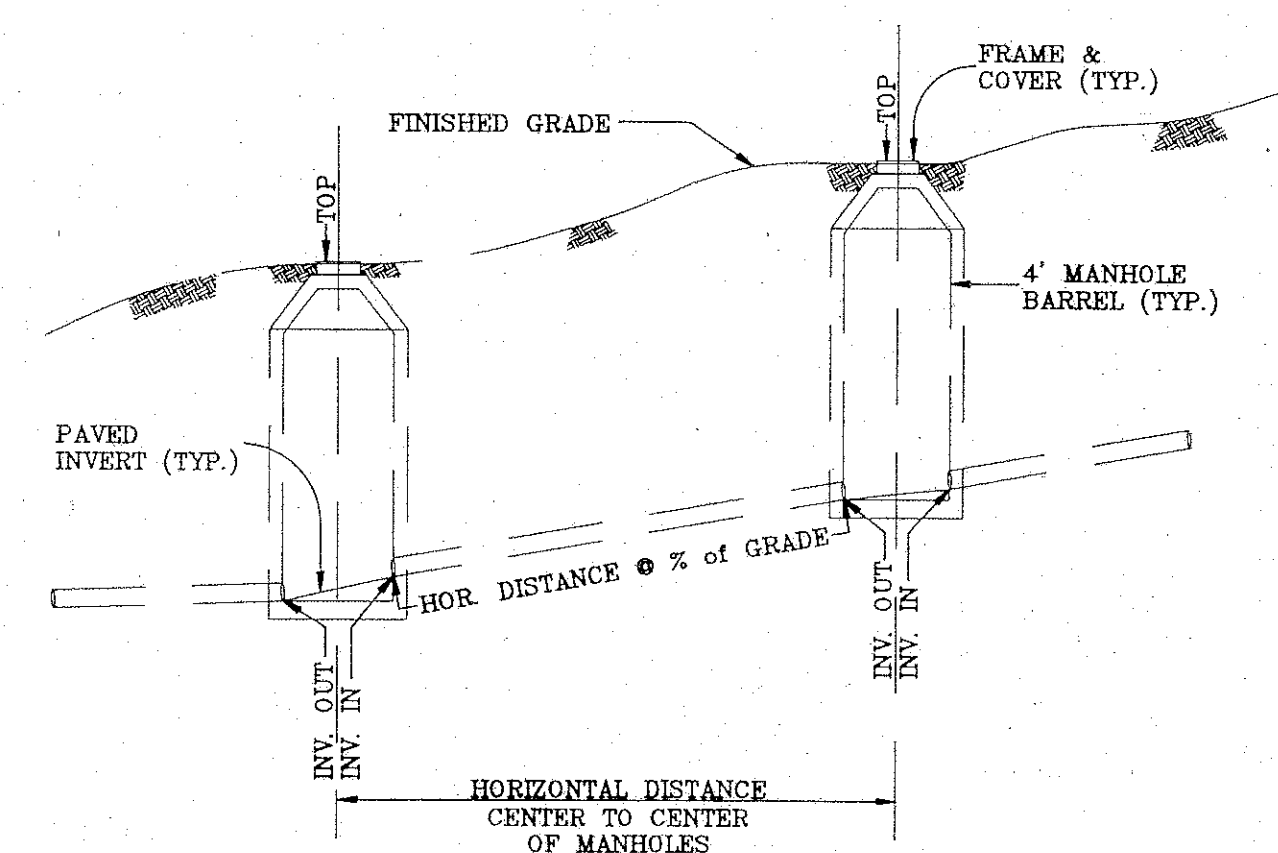

SANITARY SEWER
HORIZONTAL & SLOPE DISTANCE DETAIL

NOTE:
1. 'AS-BUILT' INFORMATION TAKEN FROM PLANS FURNISHED BY J. P. TURNER & BROTHERS, INC., CONTRACTOR.
2. 'AS-BUILT' DIMENSIONS SHOWN IN BRACKETS.

REVISION		DATE	DESCRIPTION
DESIGNED		MLP	SANITARY SEWER PROFILES
DRAWN		MS	FOR
CHECKED		MS14	"SECTION No. 1 & 2, BEASLEY NORTH"
			PREPARED FOR
			PALM LAND COMPANY, L.C.
			CAVE SPRING MAGISTERIAL DISTRICT
			ROANOKE COUNTY, VIRGINIA
			LUMSDEN ASSOCIATES, P.C.
			ENGINEERS-SURVEYORS-PLANNERS
			ROANOKE, VIRGINIA
			SCALE: AS NOTED
			COMM: 94-845
			DATE: 15 DEC. 1994
			SHEET 6 of 12

