

DEVELOPMENT PLAN
FOR
SECTION No. 1
"THE GROVES"

SITUATED IN
CAVE SPRING MAGISTERIAL DISTRICT
ROANOKE COUNTY, VIRGINIA

DATE: 18 OCTOBER 1994
"AS-BUILT" 15 JUNE 1995

PREPARED FOR
PALM LAND COMPANY, L.C.


"AS-BUILT"

NOTE:

1. "AS-BUILT" INFORMATION TAKEN FROM PLANS FURNISHED BY J.P. TURNER & BROTHERS, INC., CONTRACTOR.
2. "AS-BUILT" DIMENSIONS SHOWN IN BRACKETS.

INDEX OF DRAWINGS

SHEET No.	DESCRIPTION
1.	LUMSDEN ASSOCIATES COVER SHEET
2.	ROANOKE COUNTY STD. COVER SHEET
3.	RECORD PLAT
4.	NOTES & DETAILS
5.	DIMENSIONAL LAYOUT & UTILITIES PLAN
6.	GRADING & STORM DRAINAGE PLAN
7.	ROAD PROFILES
8.	SANITARY SEWER & STORM DRAIN PROFILES
9.	DETENTION POND DETAILS
10.	EROSION CONTROL PLAN
11.	EROSION CONTROL DETAIL SHEET
12.	ROANOKE CO. STD. WATER DETAIL SHEET
13.	ROANOKE CO. STD. SANITARY SEWER DETAIL SHEET

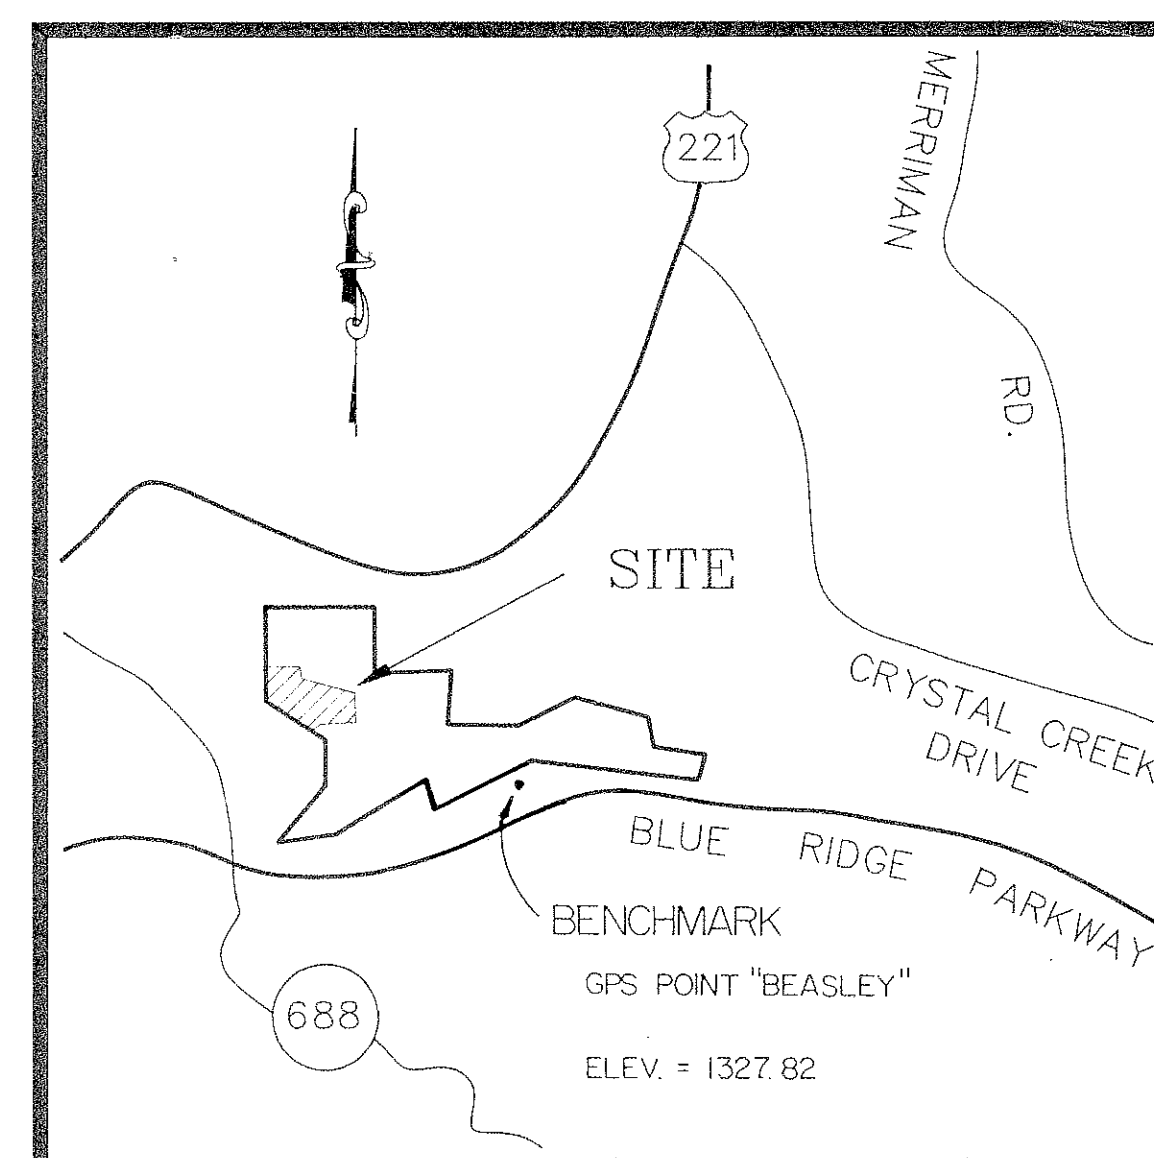

LUMSDEN ASSOCIATES, P.C.
ENGINEERS—SURVEYORS—PLANNERS
ROANOKE, VIRGINIA