

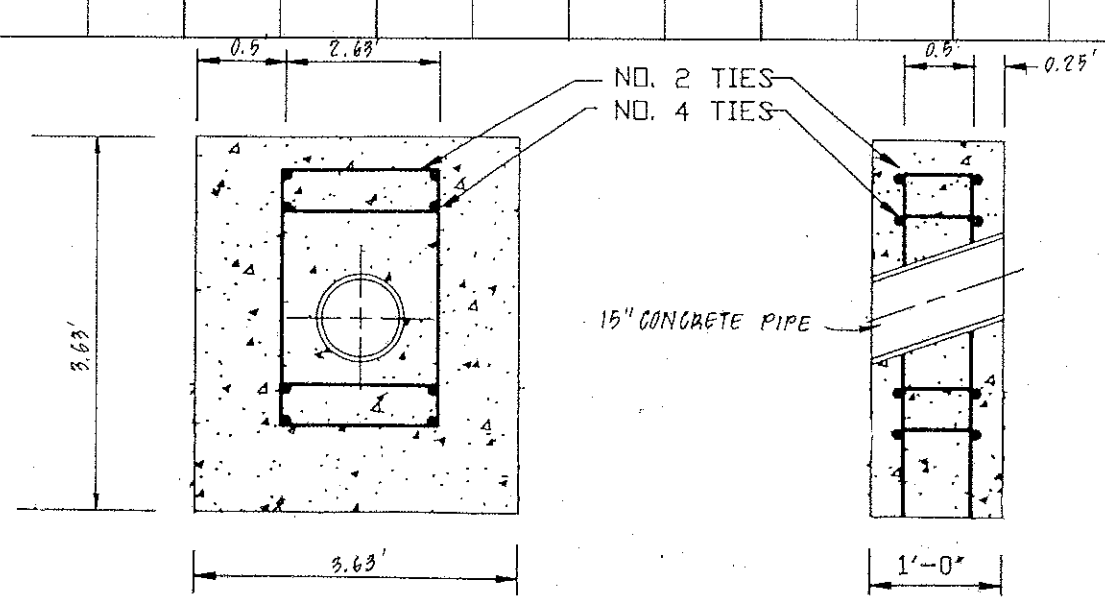
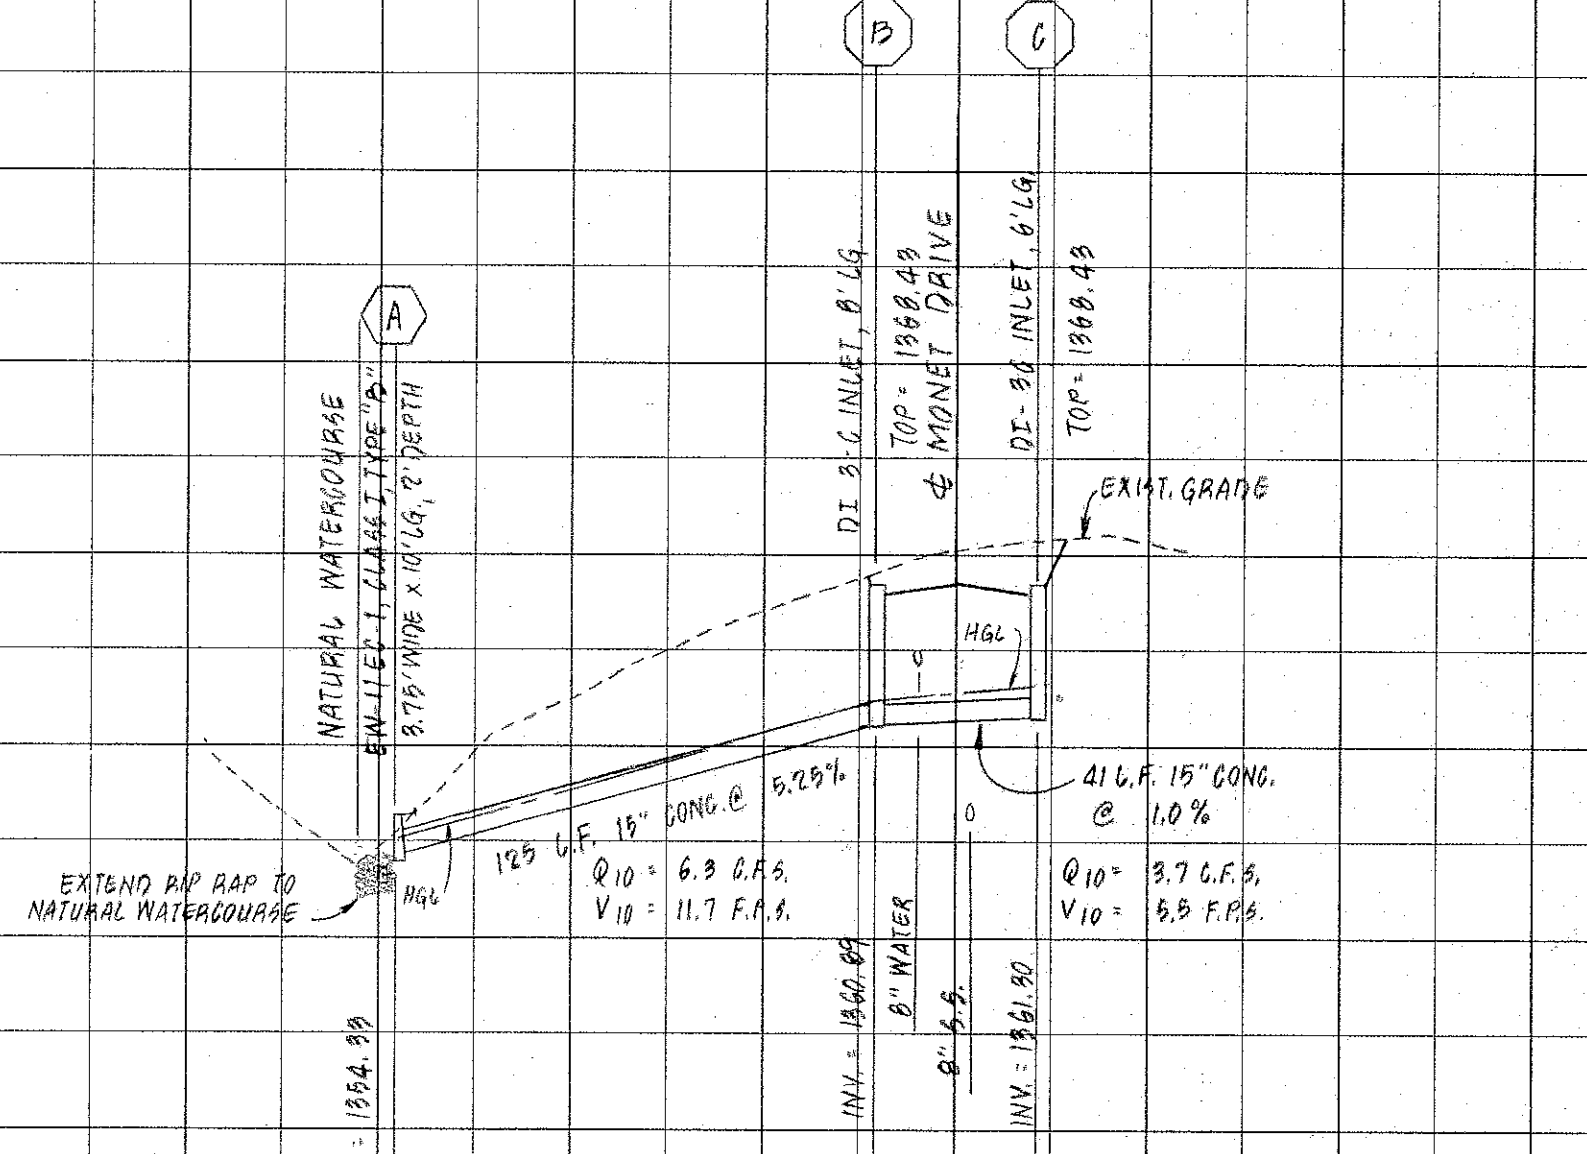
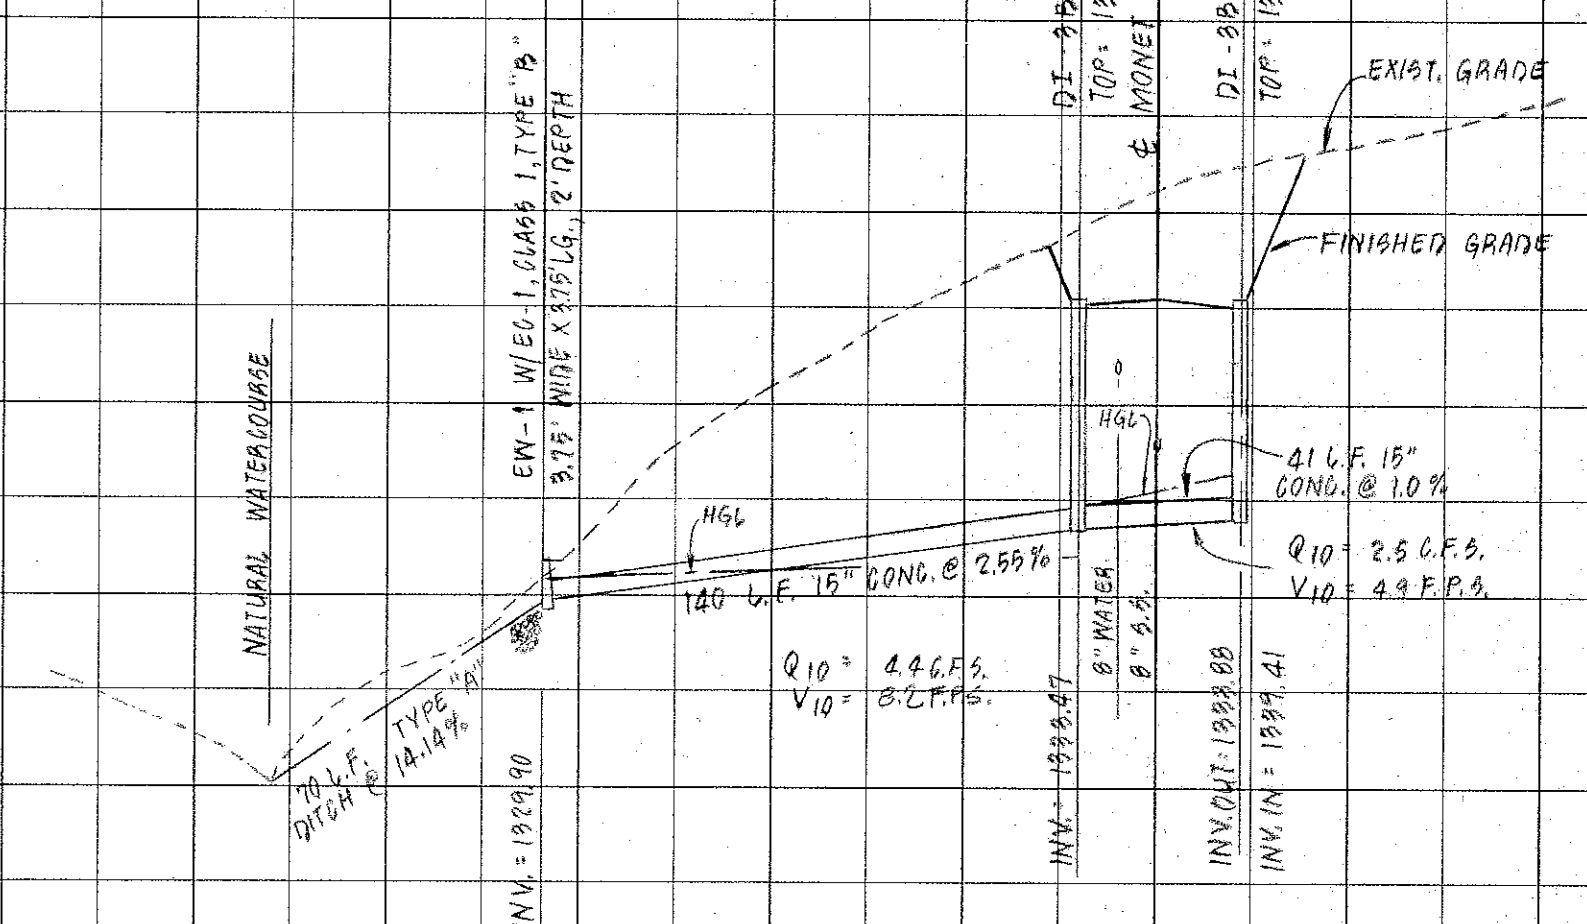
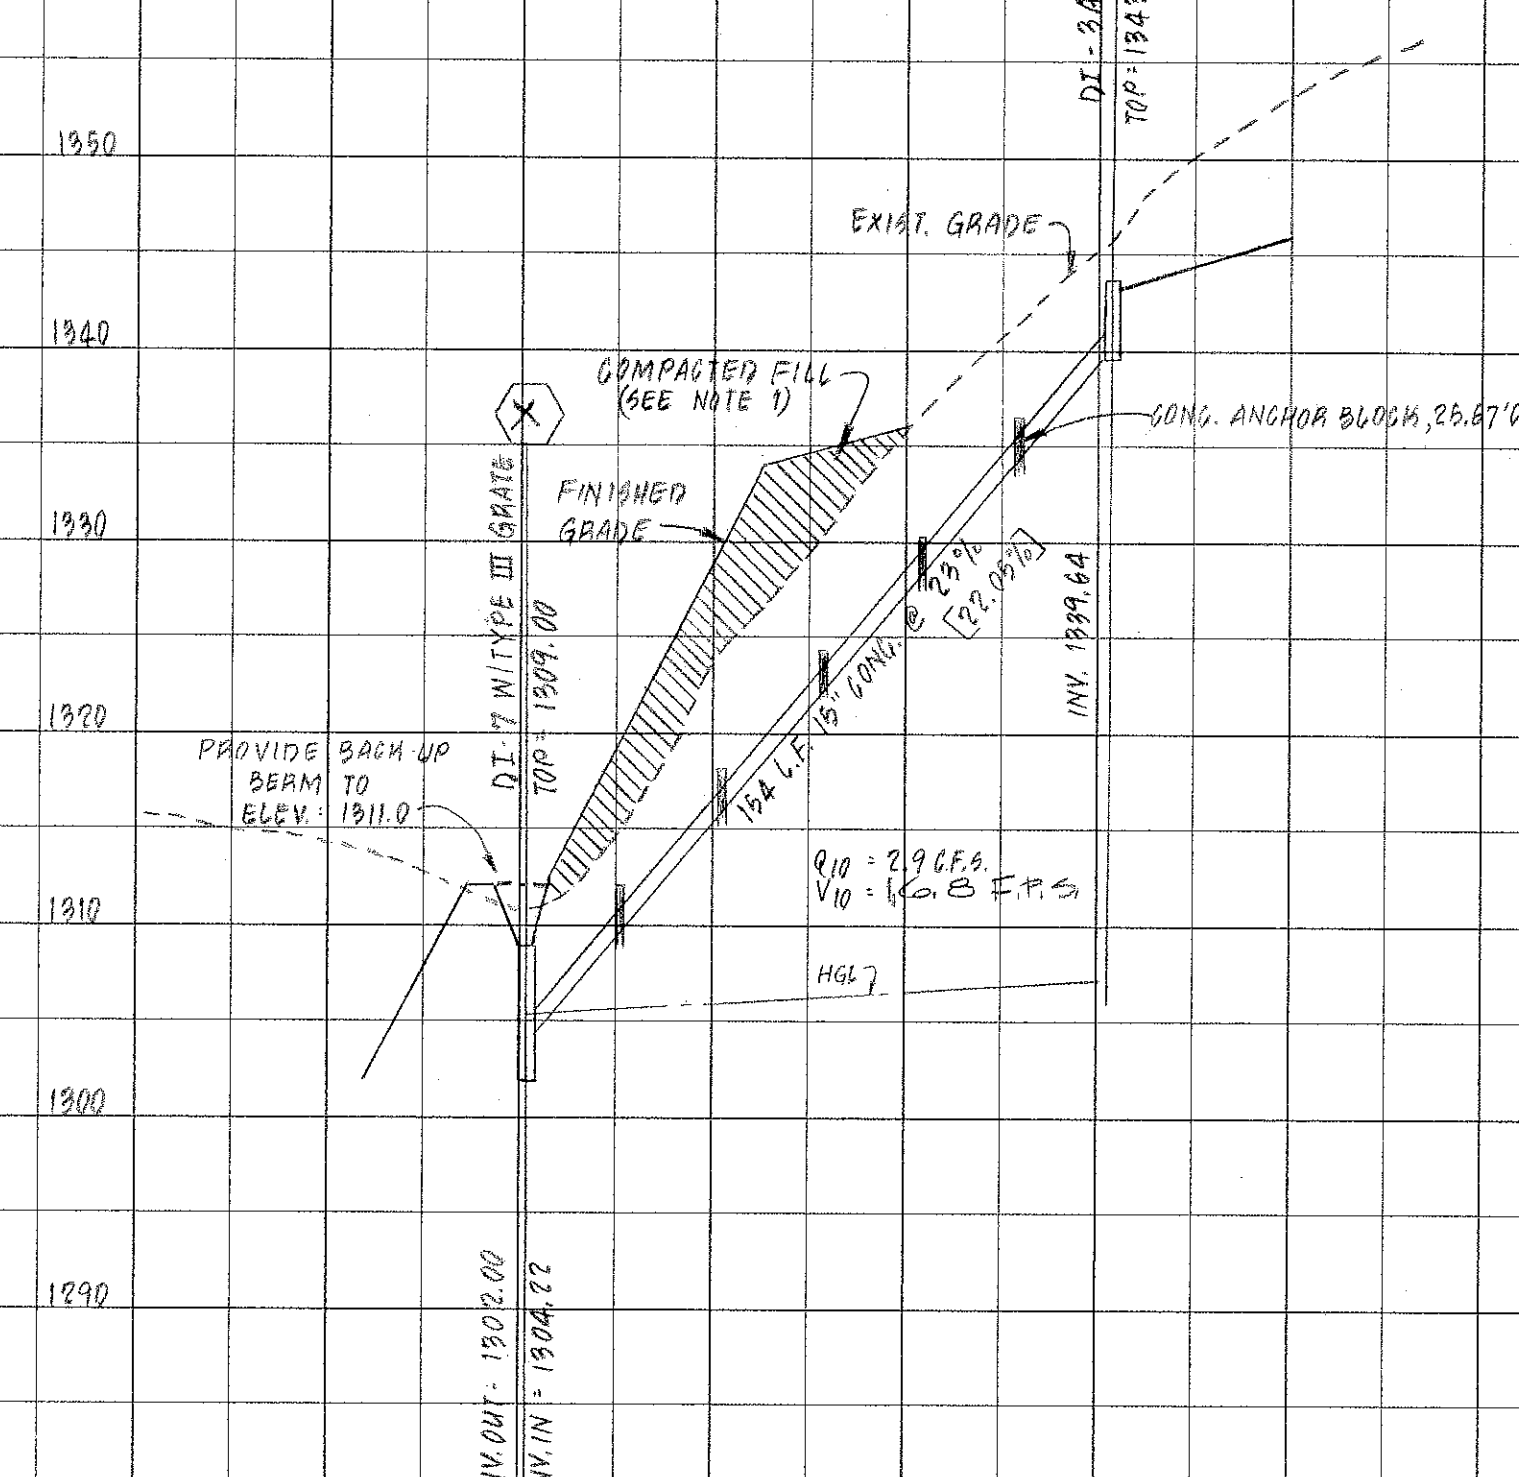


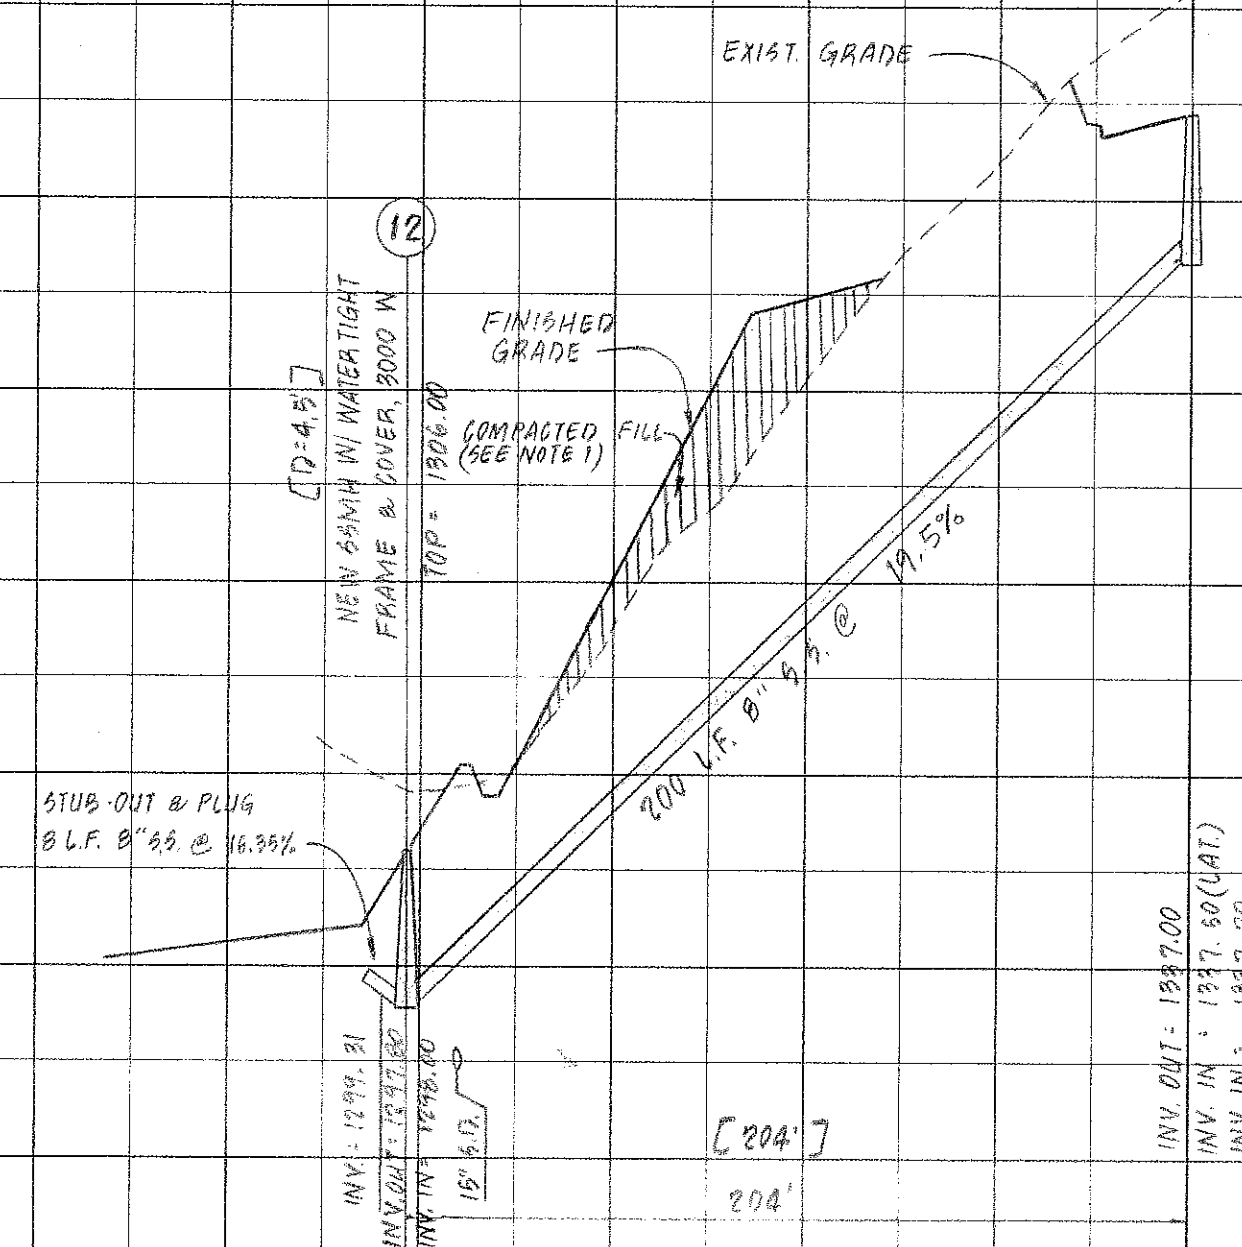

NOTES:
1) ALL FILL SHALL BE COMPACTED TO 95% STANDARD PROCTOR.

"AS-BUILT"

REVISION	DATE	DESCRIPTION
DESIGNED	MLR	SANITARY SEWER & STORM DRAIN PROFILES
DRAWN	VWB	FOR
CHECKED	MAW	SECTION No. 1
		"THE GROVES"
		PREPARED FOR
		PALM LAND COMPANY, L.C.
		CAVE SPRING MAGISTERIAL DISTRICT
		ROANOKE COUNTY, VIRGINIA
		SCALE: 1" = 50' HORIZ.
		DATE: 18 OCT 1994
		SHEET 8 of 13

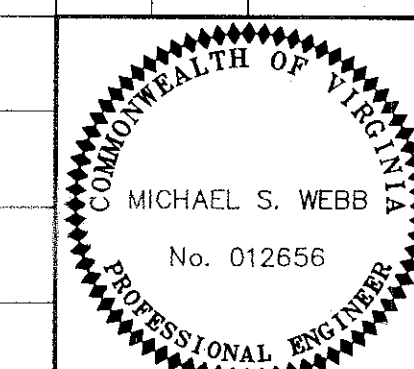

LUMSDEN ASSOCIATES, P.C.
ENGINEERS-SURVEYORS-PLANNERS
ROANOKE, VIRGINIA

RC-5688