


DEVELOPMENT PLAN
FOR
SECTION No. 11
"THE GROVES"

*SITUATED IN
CAVE SPRING MAGISTERIAL DISTRICT
ROANOKE COUNTY, VIRGINIA*

DATE: 28 JULY 2004
"AS-BUILT" - SEPTEMBER 22, 2005
PREPARED FOR

PALM LAND COMPANY, L.C.

DEVELOPMENT PLAN APPROVED FOR CONSTRUCTION BY ROANOKE COUNTY		
Department		Date
Development Review	WLS	9/10/09
Engineering	WLS	9/10/09
Water & Sewer	WLS	9-10-09
Planning & Zoning		

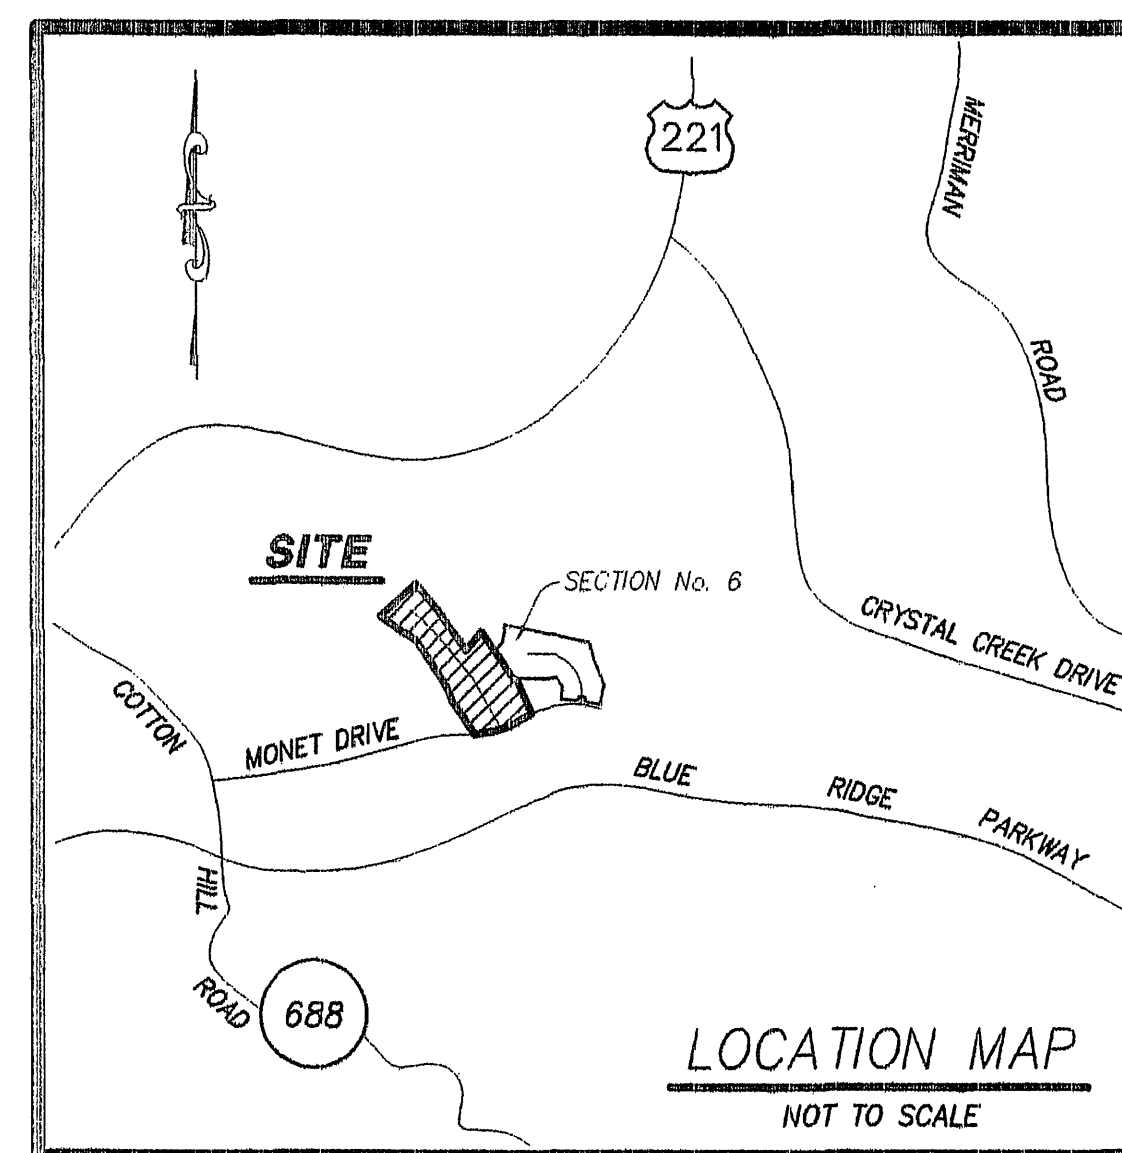


--INDEX OF DRAWINGS--

SHEET No.	DESCRIPTION
-----------	-------------

1. LUMSDEN ASSOCIATES COVER SHEET
2. ROANOKE COUNTY COVER SHEET
3. RECORD PLAT
4. NOTES & DETAILS
5. DIMENSIONAL LAYOUT
6. GRADING PLAN
7. PROFILES
8. EROSION AND SEDIMENT CONTROL PLAN
9. EROSION AND SEDIMENT CONTROL DETAILS

I AM CERTIFIED BY THE STATE OF VIRGINIA AS A "RESPONSIBLE LAND DISTURBER". I SHALL BE RESPONSIBLE FOR THE IMPLEMENTATION OF THE EROSION AND SEDIMENT CONTROL PLAN AS SHOWN.


SIGNATURE: . . . _____
 PRINTED NAME: . . . _____
 CERTIFICATE No.: . . . _____
 EXPIRATION DATE: . . . _____
 TELEPHONE No.: . . . _____
 ADDRESS: _____

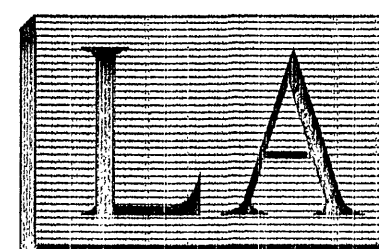

LUMSDEN ASSOCIATES, P.C.
ENGINEERS-SURVEYORS-PLANNERS

4664 BRAMBLETON AVENUE, SW
P.O. BOX 20669
ROANOKE, VIRGINIA 24018

PHONE: (540) 774-4411
FAX: (540) 772-9445
E-MAIL: MAIL@LUMSDENPC.COM

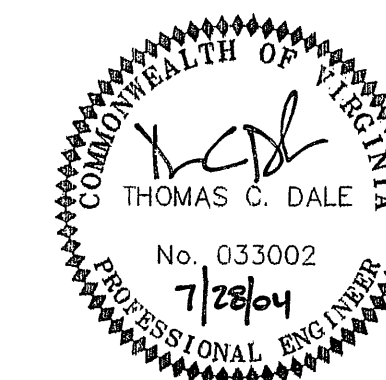

“AS-BUILT”

NOTE:

1. "AS BUILT" INFORMATION TAKEN FROM
PLAN FURNISHED BY J. P. TURNER &
BROTHERS, INC., GENERAL CONTRACTOR.
2. "AS-BUILT" DIMENSIONS SHOWN IN BRACKETS.

WWVA ID# 6GTKD6

REVISIONS	
DATE	SHEETS

COMMISSION No: 03-352

SHEET 1 OF 9