

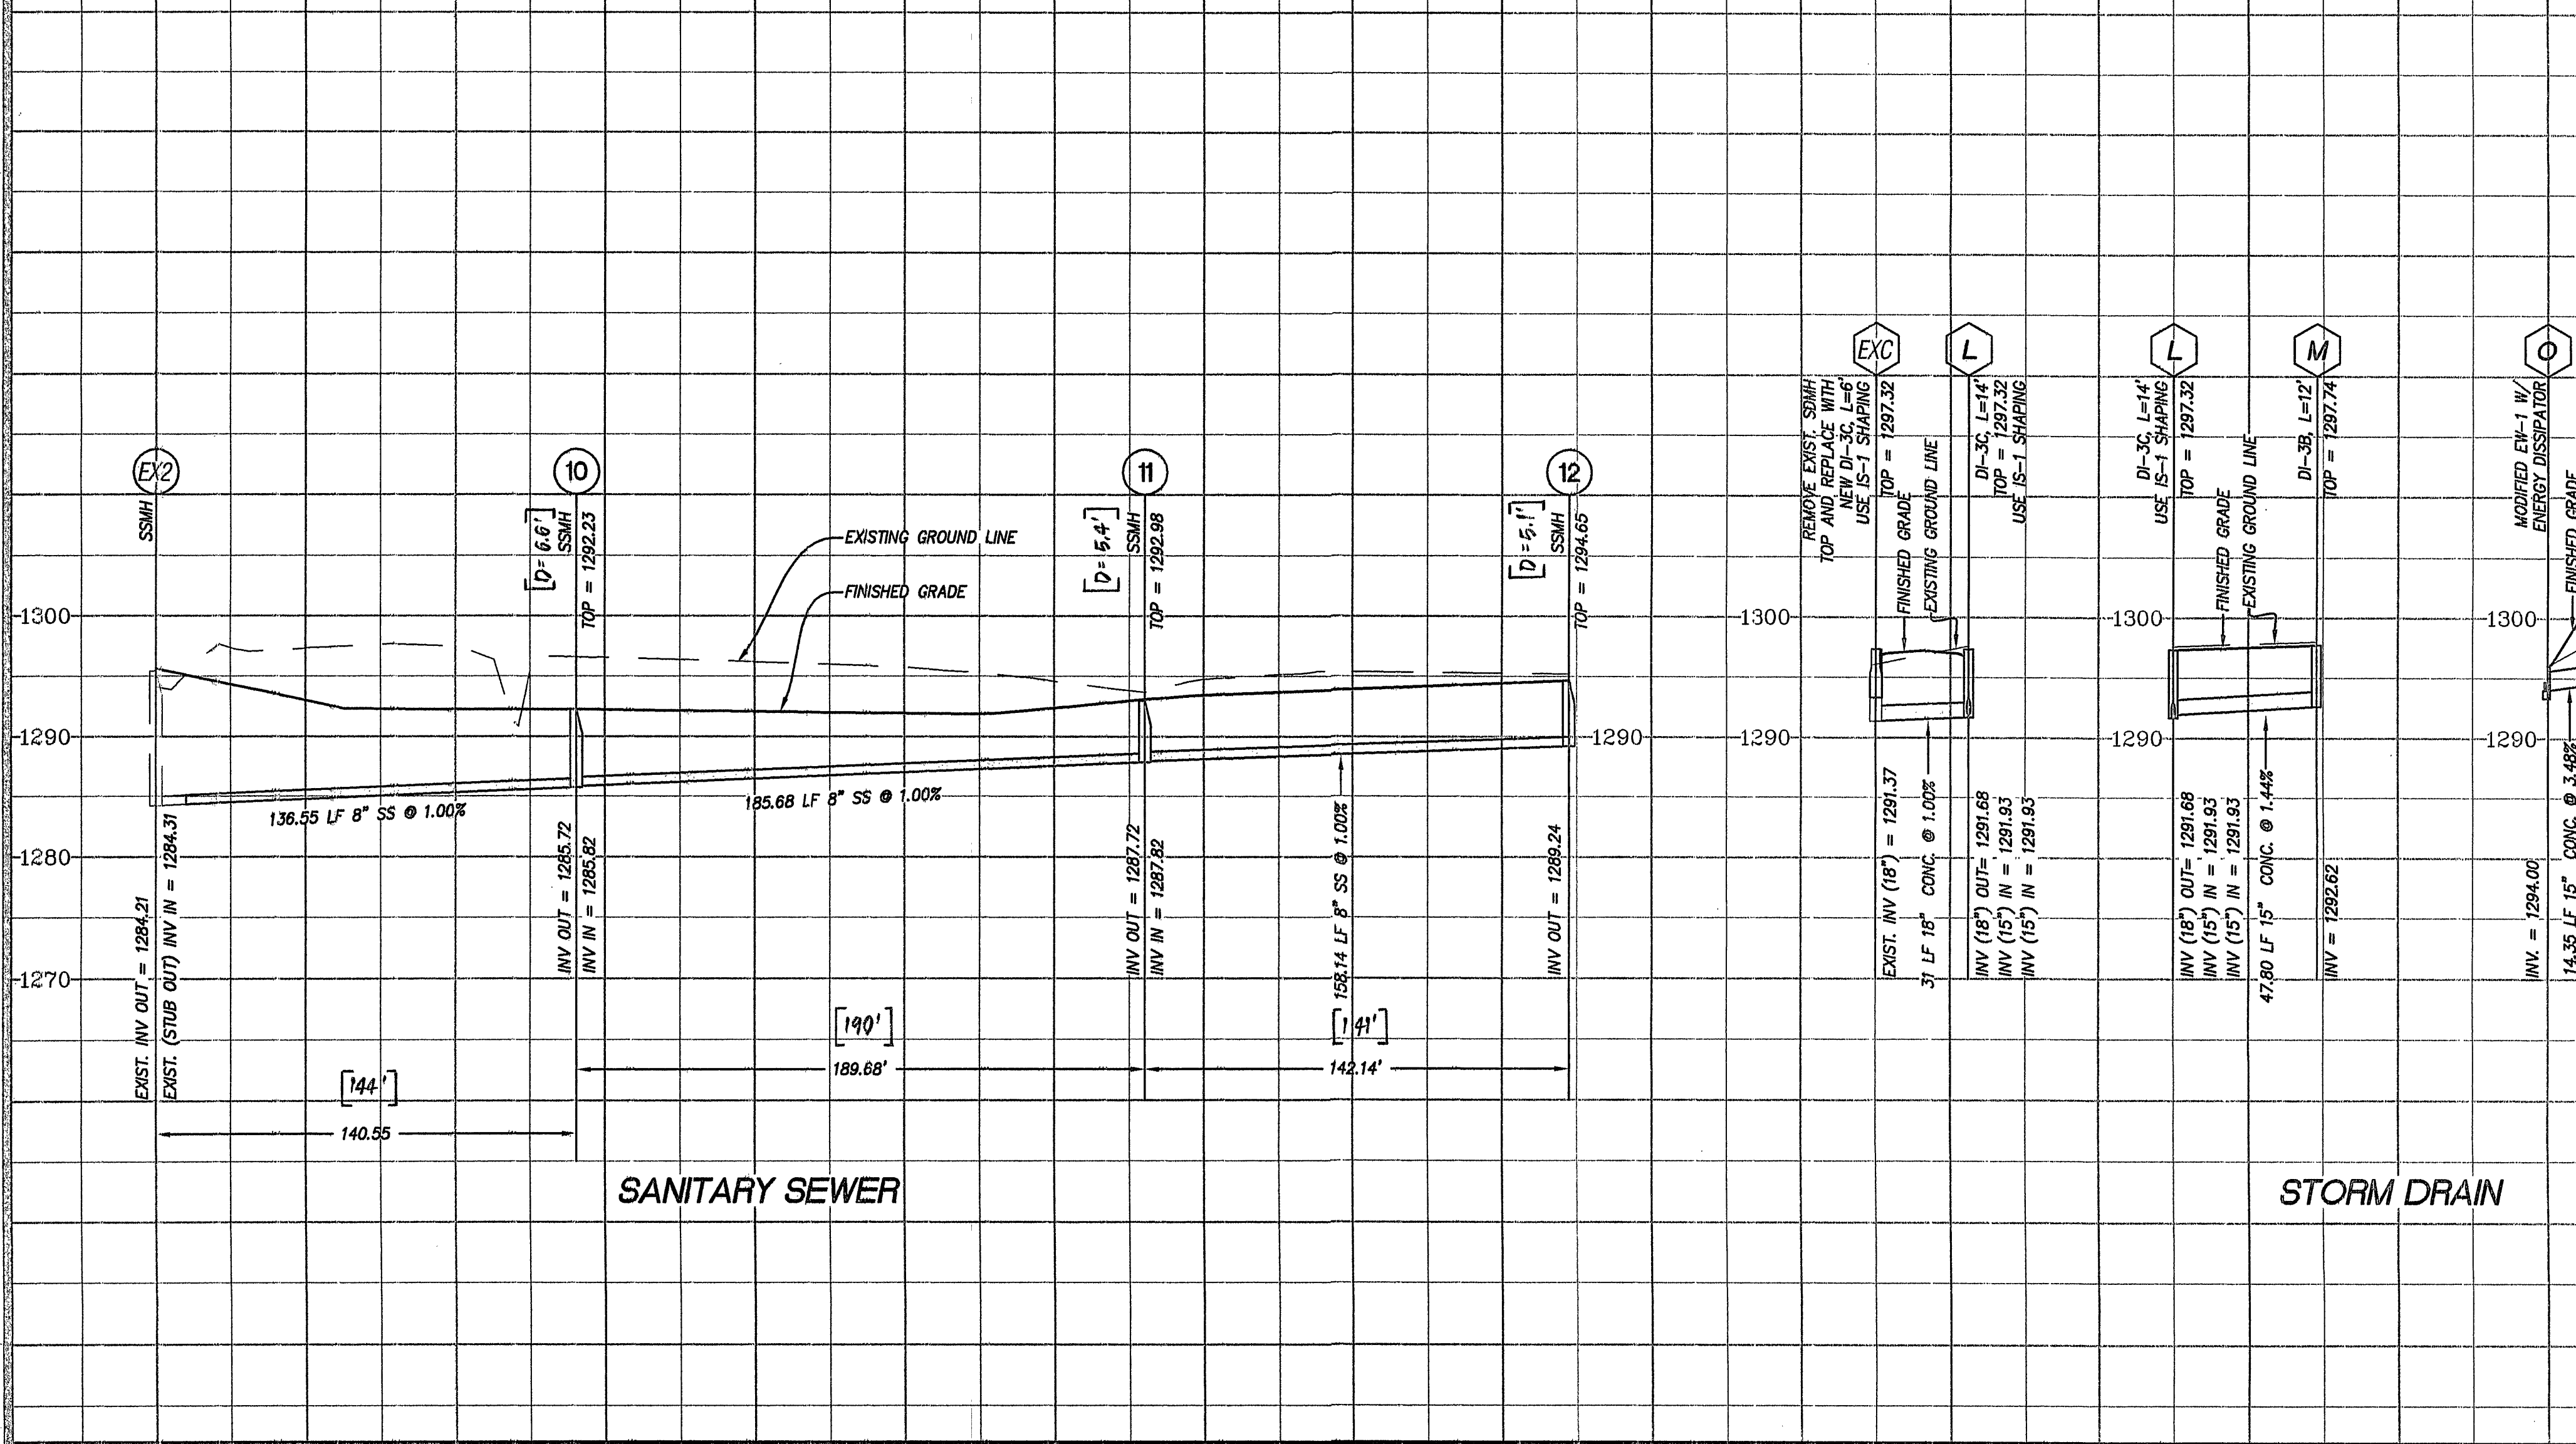


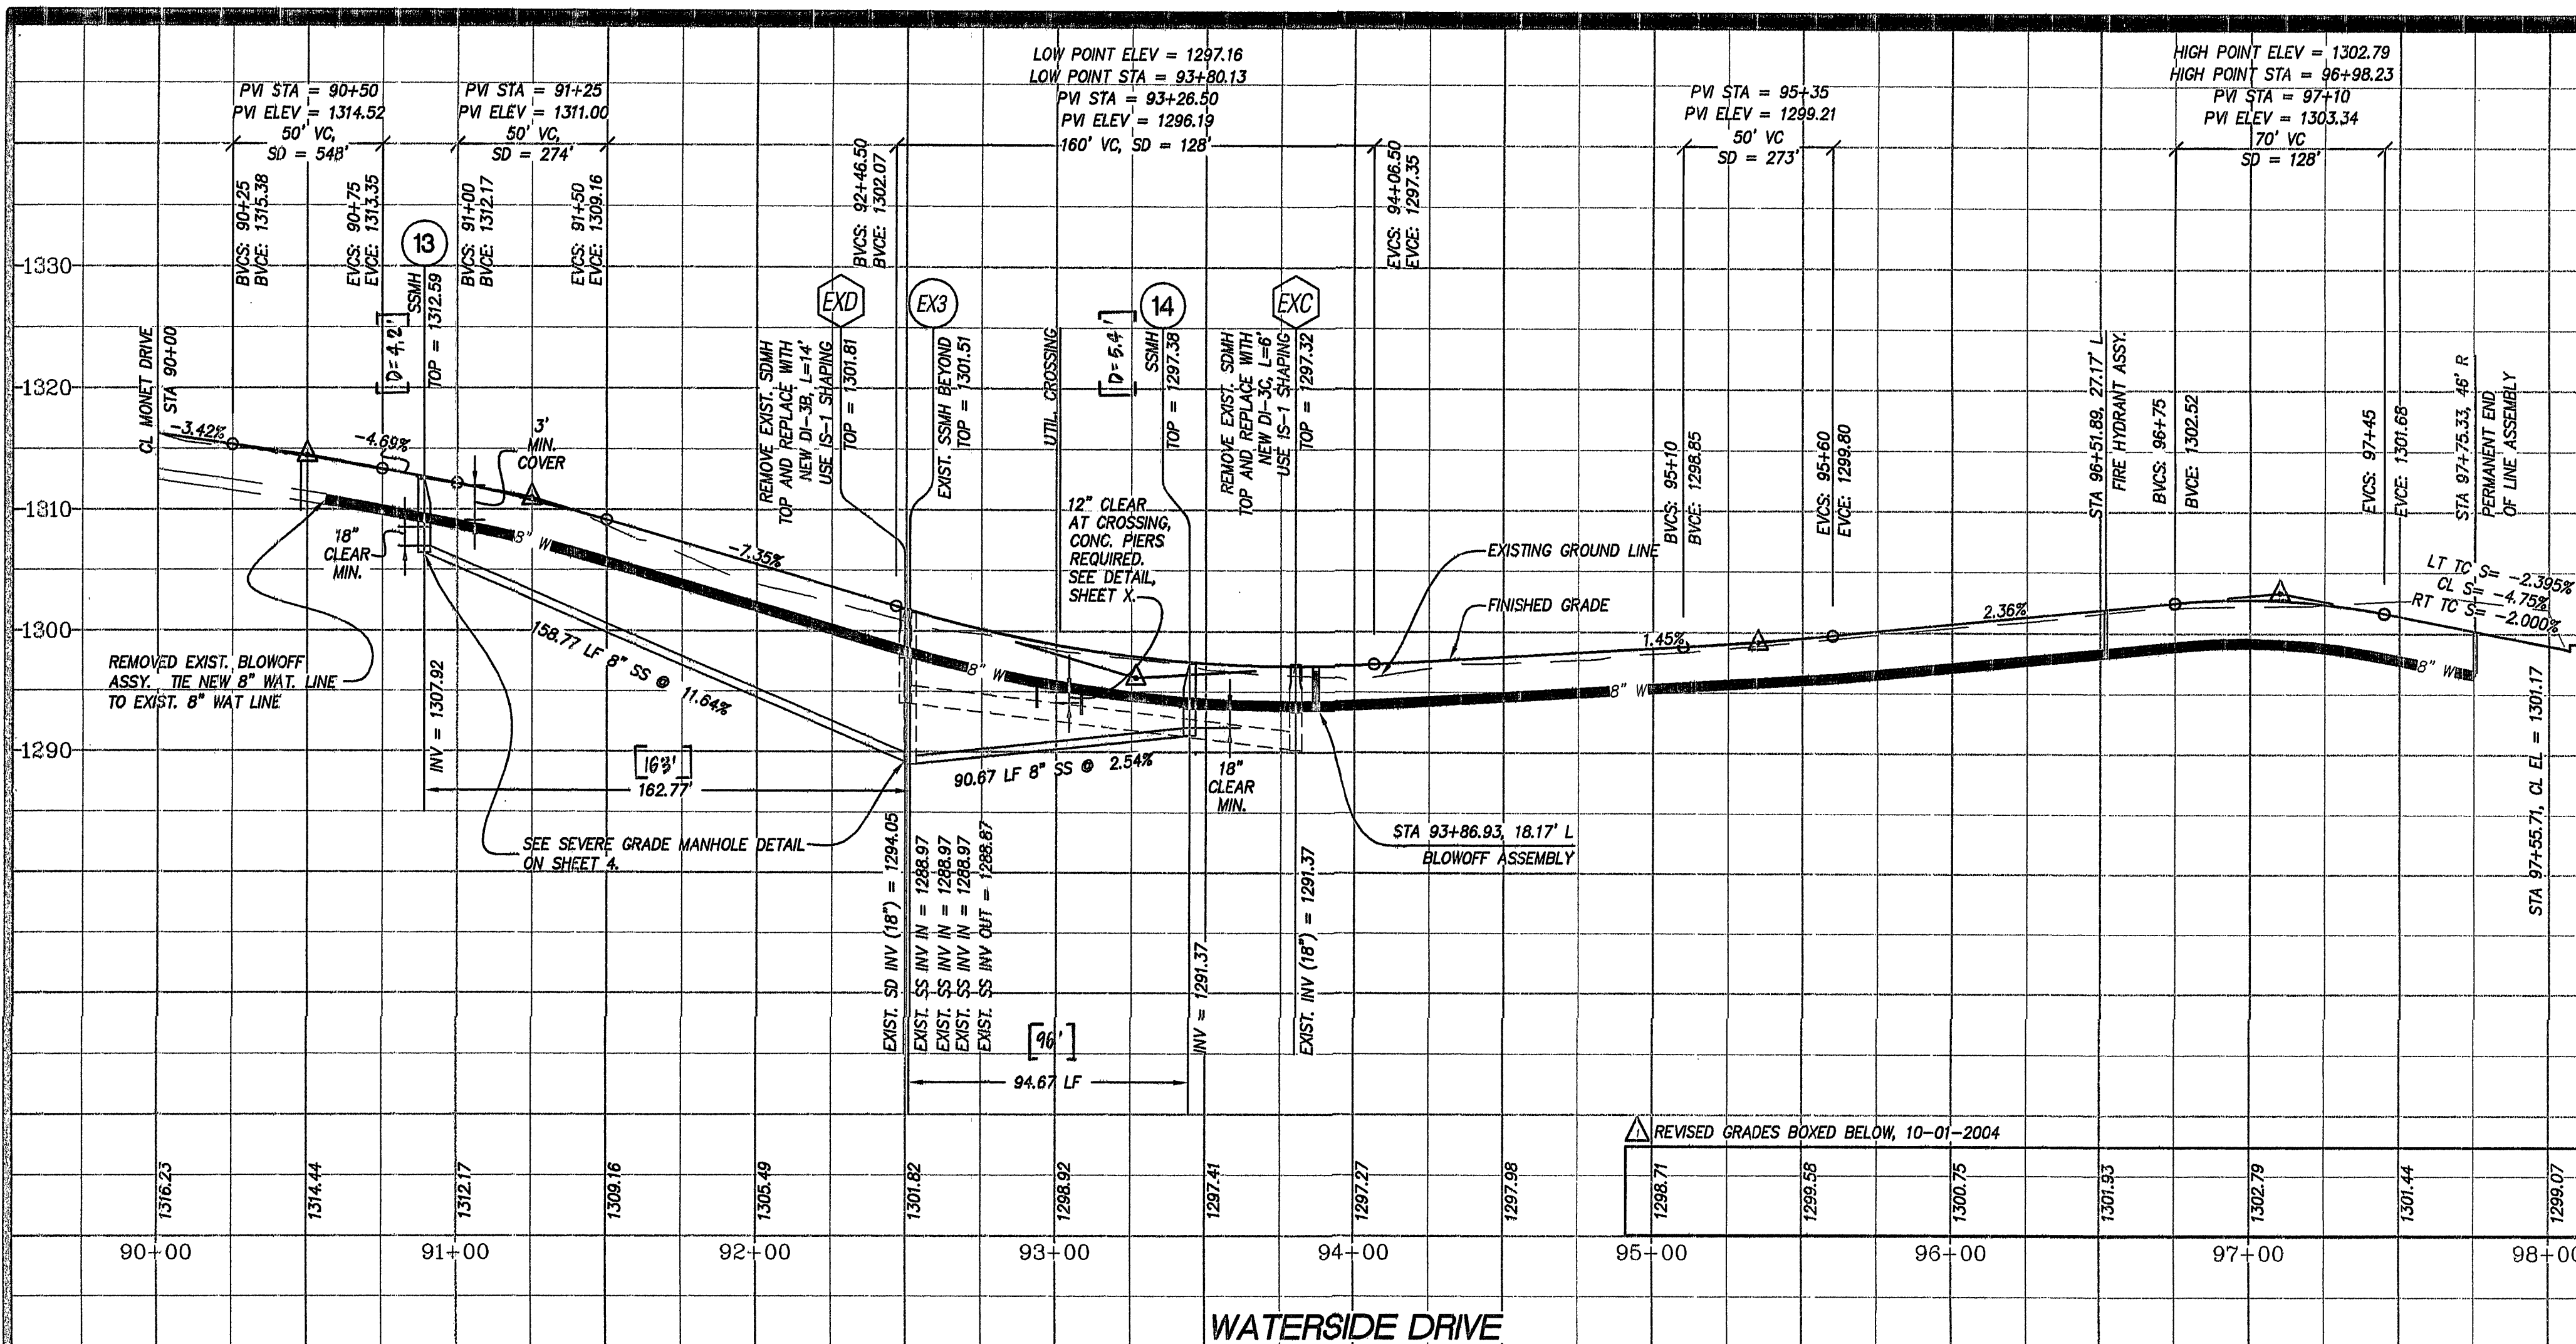

- NOTES:**
1. ALL WATER AND SANITARY SEWER LINES TO HAVE A MINIMUM OF 3.0 FEET OF COVER.
 2. MAINTAIN A MINIMUM OF 18" CLEARANCE FROM OUTSIDE OF PIPE TO OUTSIDE OF PIPE AT ALL WATER, SANITARY SEWER, AND STORM DRAIN CROSSINGS.
 3. A WESTERN VIRGINIA WATER AUTHORITY INSPECTOR MUST BE ON SITE DURING THE INSTALLATION OF ALL NEW MANHOLES.

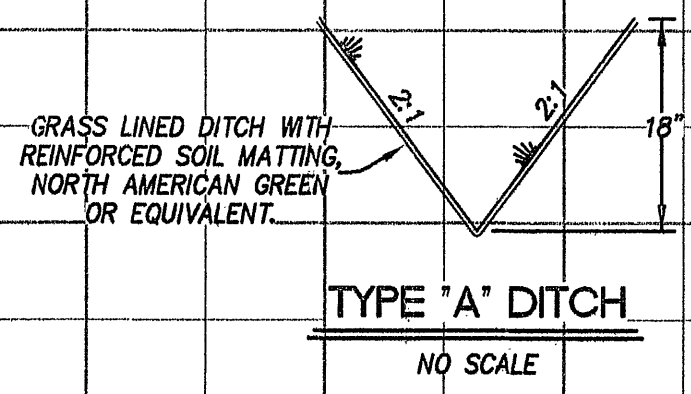


AS-BUILT

NO.	DATE	DESCRIPTION
1	10-01-04	REV. RDPY PROFILE GRADES
2	9/20/06	AS-BUILT SANITARY REVIEW
3		
4		
5		

DATE: JULY 28, 2004
SCALE: 1" = 40'
COMMISSION NO: 03-352
CADD FILE: 0305\03352\dwg\03352comp.dwg
SHEET 7 OF 9

SECTION No. 11
THE GROVES
PREPARED FOR
PALM LAND COMPANY, L.C.
CAVE SPRING MAGISTERIAL DISTRICT
ROANOKE COUNTY, VIRGINIA

PROFILES

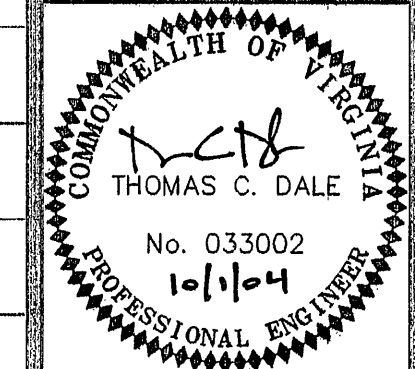

LUMSDEN ASSOCIATES, P.C.
ENGINEERS-SURVEYORS-PLANNERS
ROANOKE, VIRGINIA

4664 BRANBLETON AVENUE
P.O. BOX 20669
ROANOKE, VIRGINIA 24018
PHONE: (540) 774-4411
FAX: (540) 772-9445
E-MAIL: MAIL@LUMSDENPC.COM