
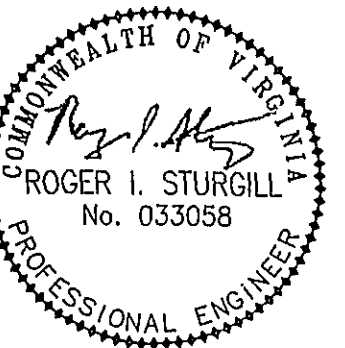
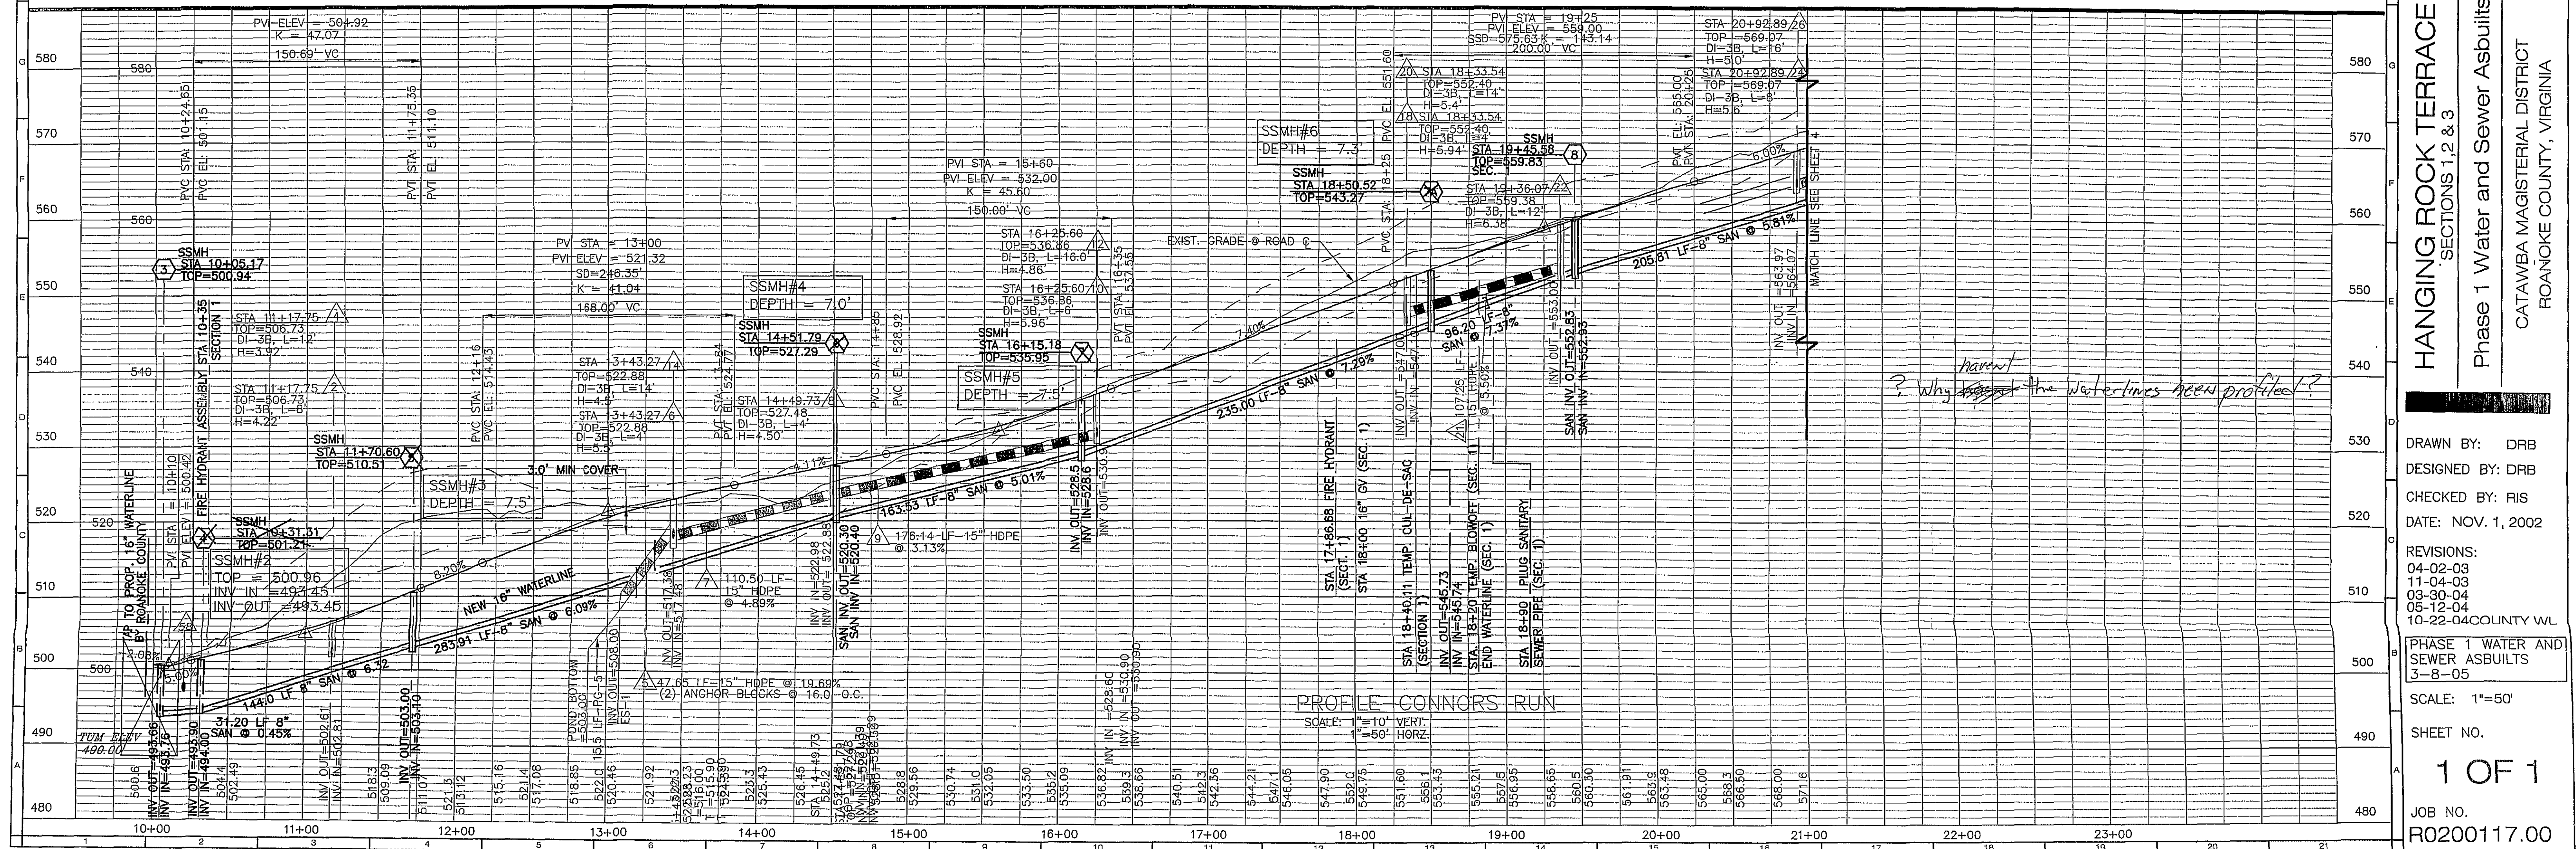


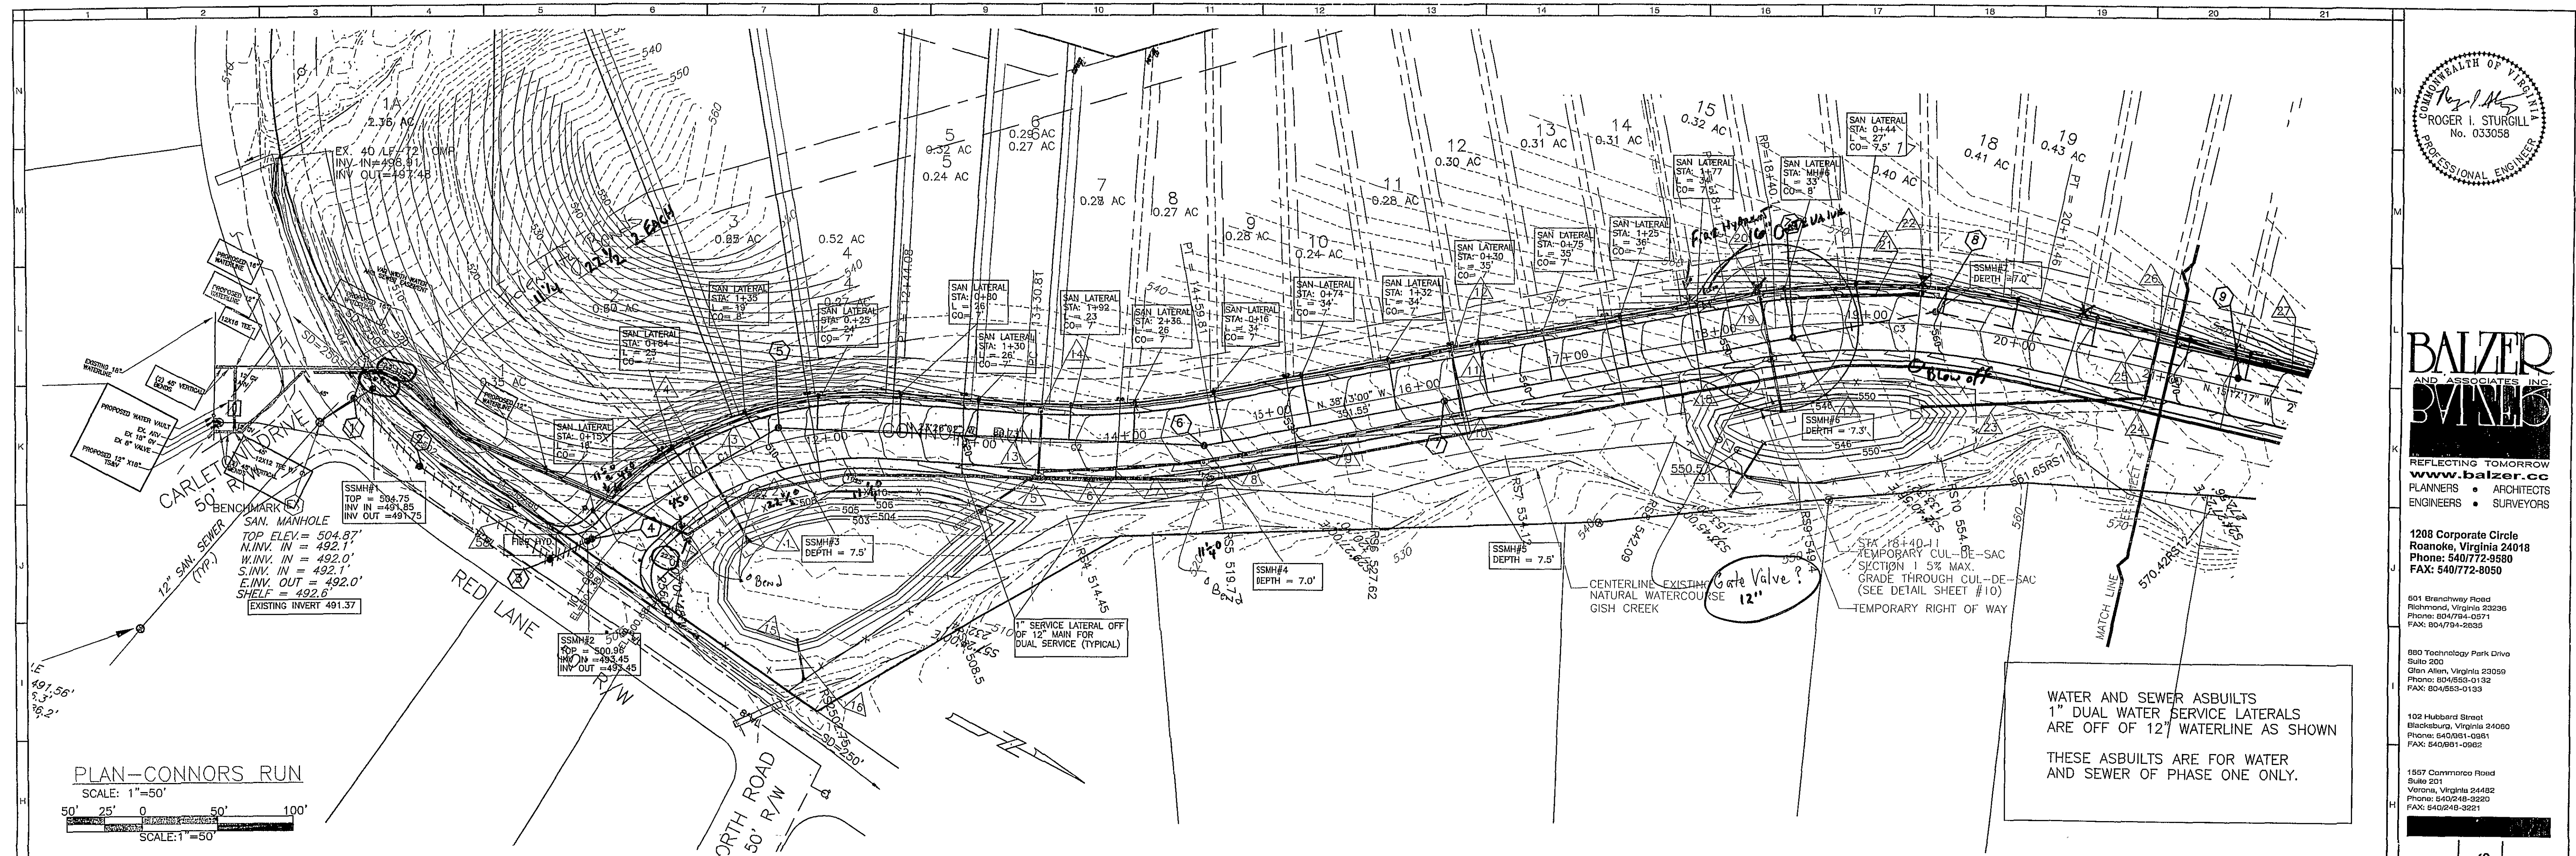

REFLECTING TOMORROW
www.balzer.cc
PLANNERS • ARCHITECTS
ENGINEERS • SURVEYORS

1208 Corporate Circle
Roanoke, Virginia 24018
Phone: 540/772-9580
FAX: 540/772-8050

601 Branchway Road
Richmond, Virginia 23238
Phone: 804/794-0371
FAX: 804/794-2835

880 Technology Park Drive
Suite 500
Glen Allen, Virginia 23059
Phone: 804/658-0132
FAX: 804/658-0133

102 Hubbard Street
Blackburg, Virginia 24060
Phone: 540/651-0951
FAX: 540/651-0952

1567 Commerce Road
Suite 201
Vienna, Virginia 24482
Phone: 540/648-3220
FAX: 540/648-3221

HANGING ROCK TERRACE
SECTIONS 1.2 & 3
Phase 1 Water and Sewer Asbuilts
CATAWBA MAGISTERIAL DISTRICT
ROANOKE COUNTY, VIRGINIA

DRAWN BY: DRB
DESIGNED BY: DRB
CHECKED BY: RIS
DATE: NOV. 1, 2002

REVISIONS:
04-02-03
11-04-03
08-30-04
06-12-04
10-22-04 COUNTY WL

PHASE 1 WATER AND
SEWER ASBUILTS
3-8-05

SCALE: 1"=50'
SHEET NO.
1 OF 1
JOB NO.
R0200117.00