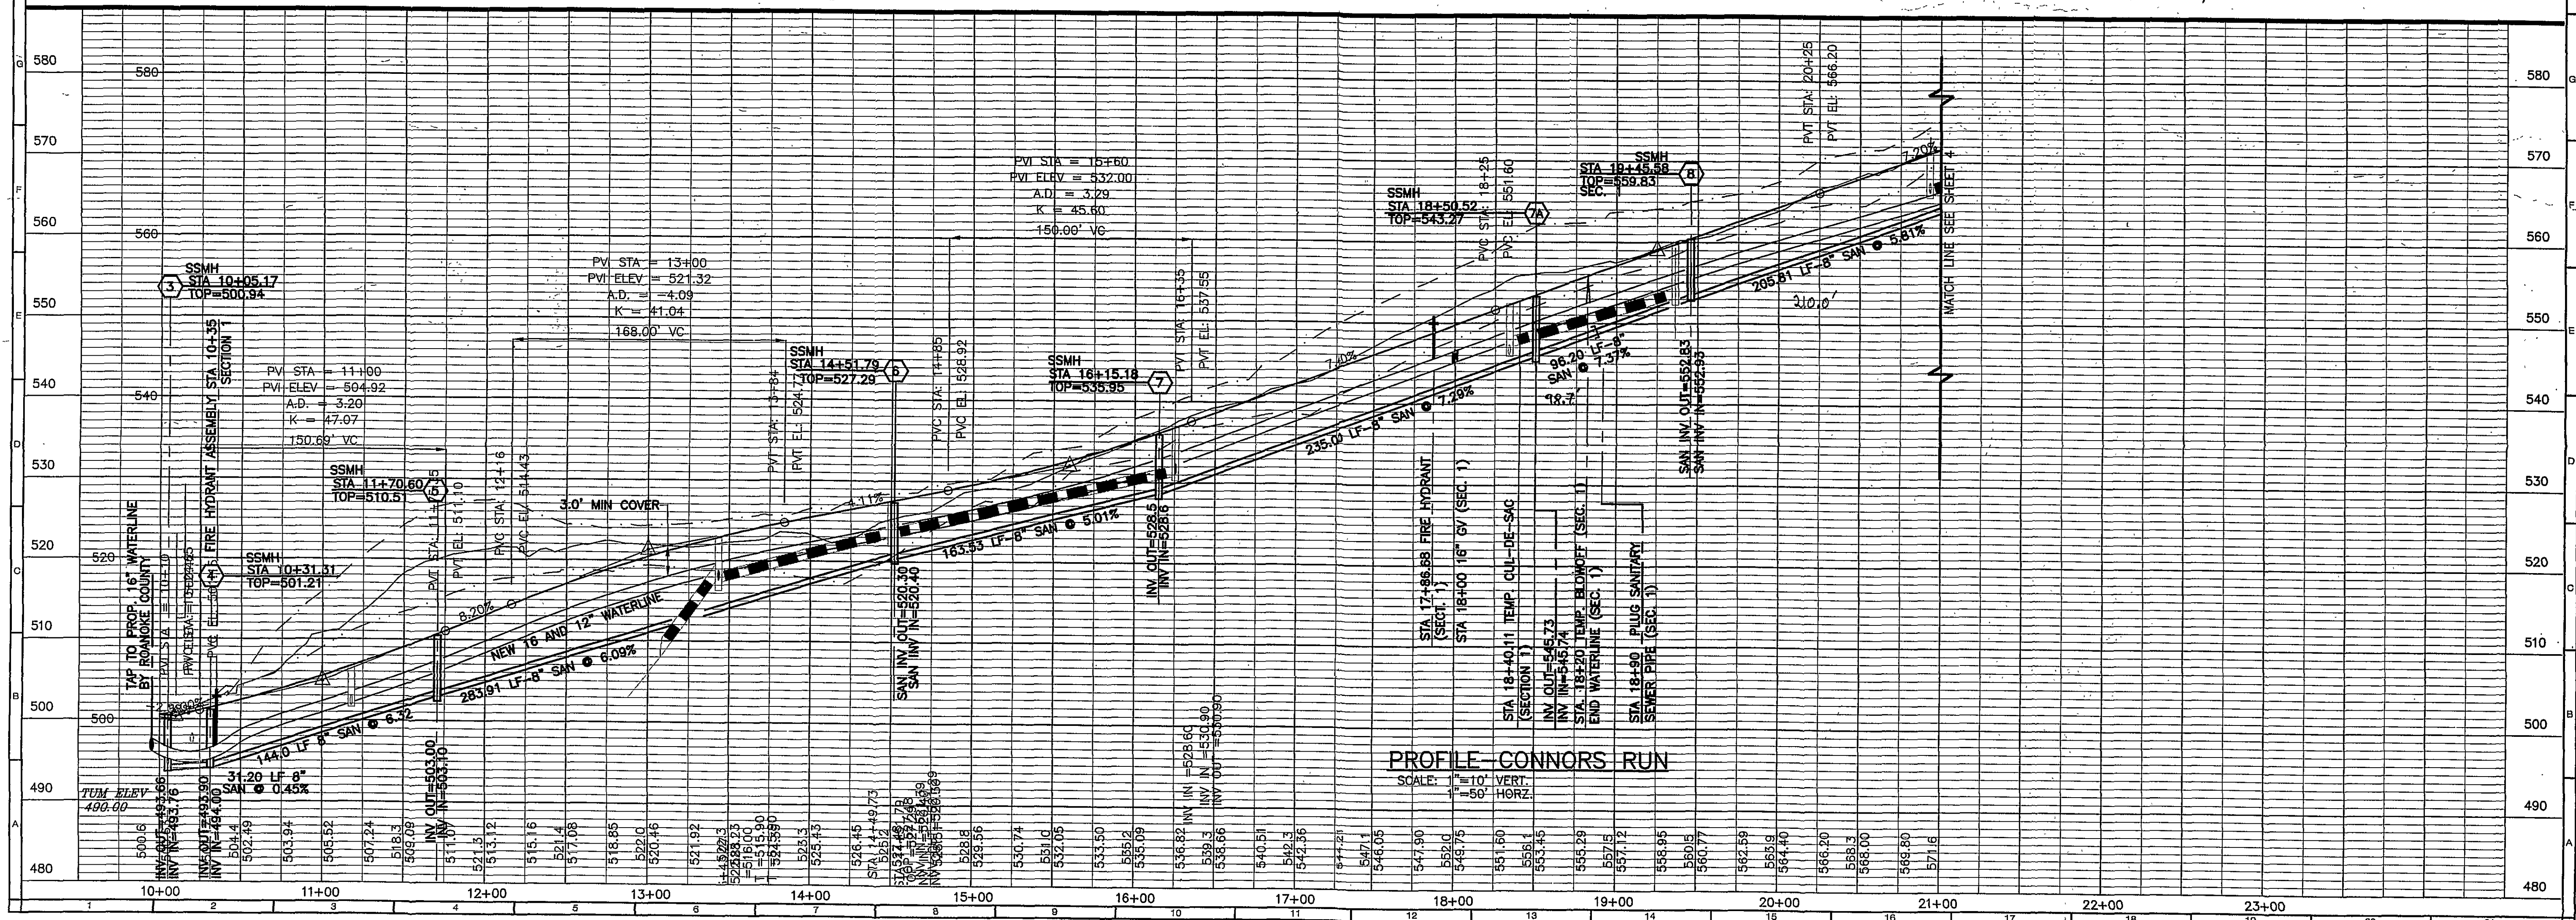


R0200117.00

As-Built - 10.71.00 K. Willsch