



AS BUILT
REVISED - 2/13/89

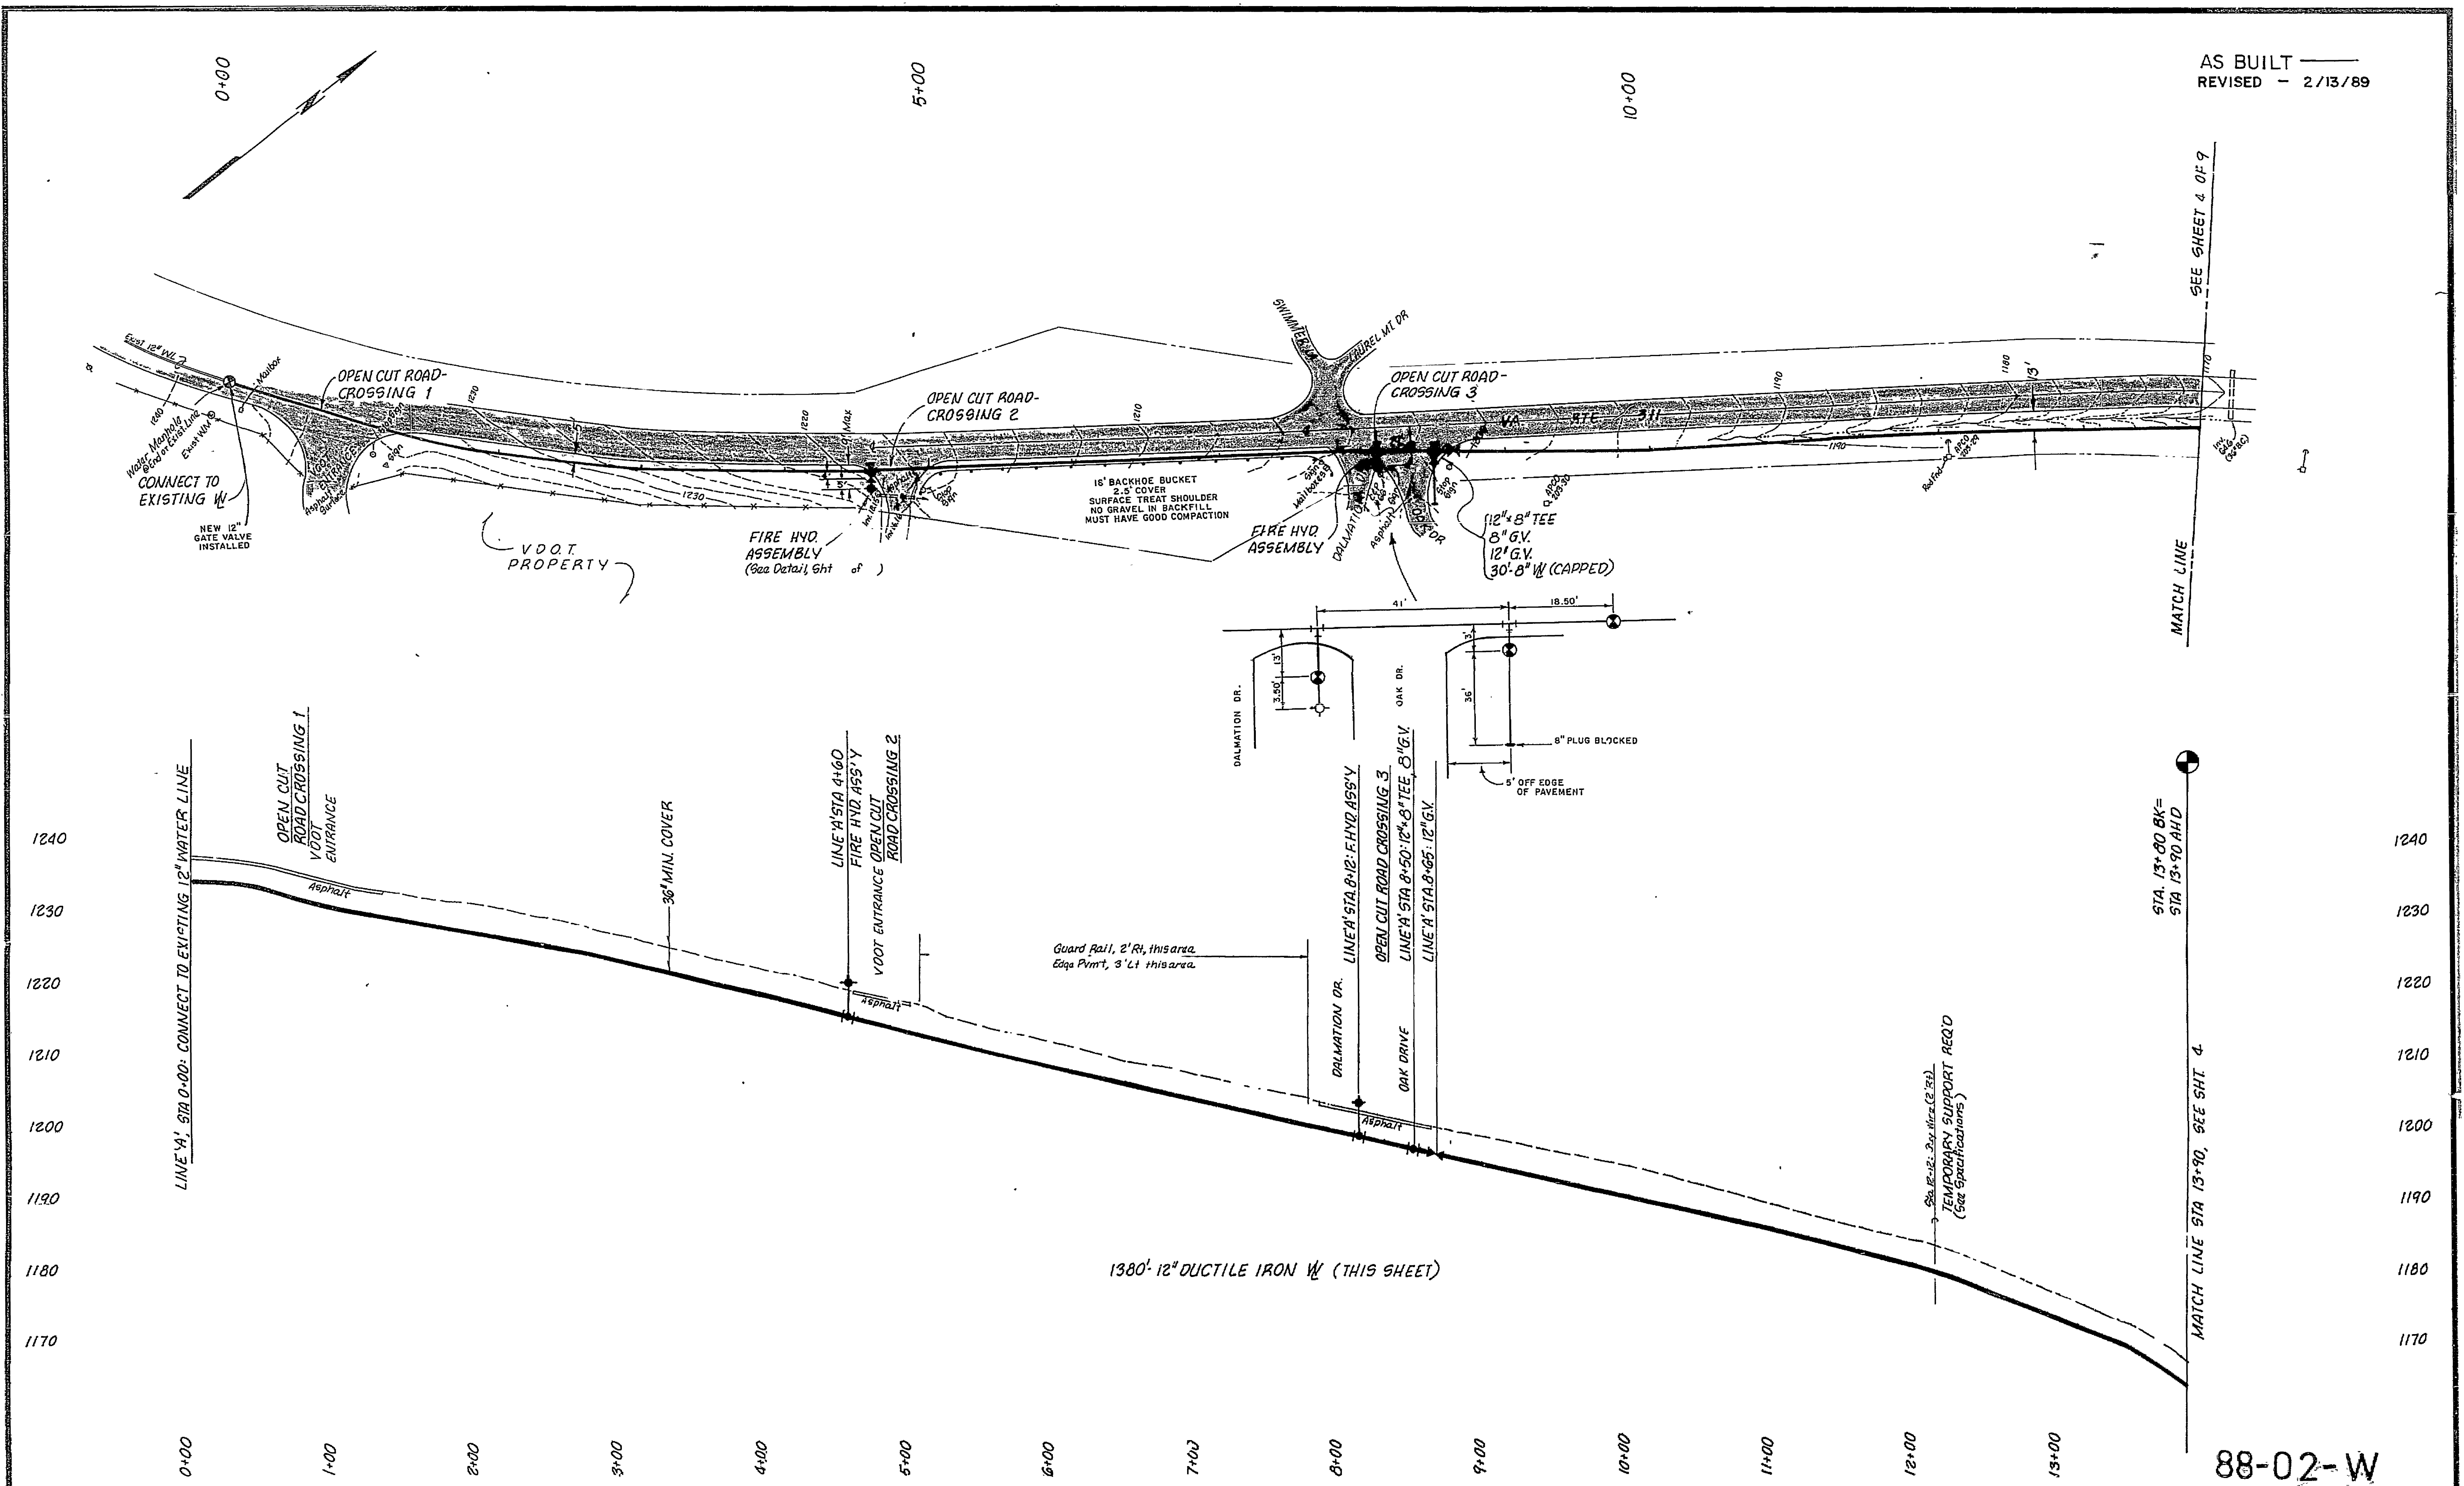

88-02-W

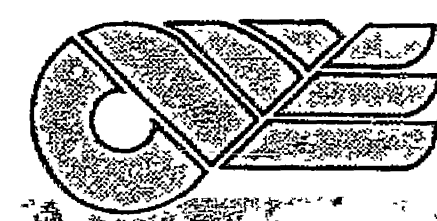


CLEAN WATER ENGINEERS, INC.

P.O. BOX 218
FINCASTLE, VIRGINIA 24090

P.O. BOX 3225
STAUNTON, VIRGINIA 24401

ROANOKE COUNTY WATERLINE EXTENSION
VIRGINIA ROUTE 311/HANGING ROCK VICINITY
ROANOKE COUNTY, VIRGINIA

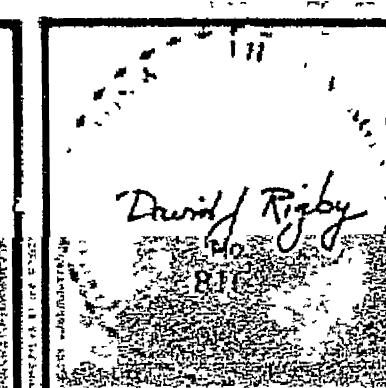

REVISIONS		
NO.	DATE	BY
1		
2		
3		
4		
5		

DESIGNED: WGP	SHEET: 3 OF 8
DRAWN: LHJ	SCALE: 1" = 50'
CHECKED: RCJ/CCB	DATE: JAN 1988
APPROVED: DUR	PROJECT: 87079

WT-0195

