

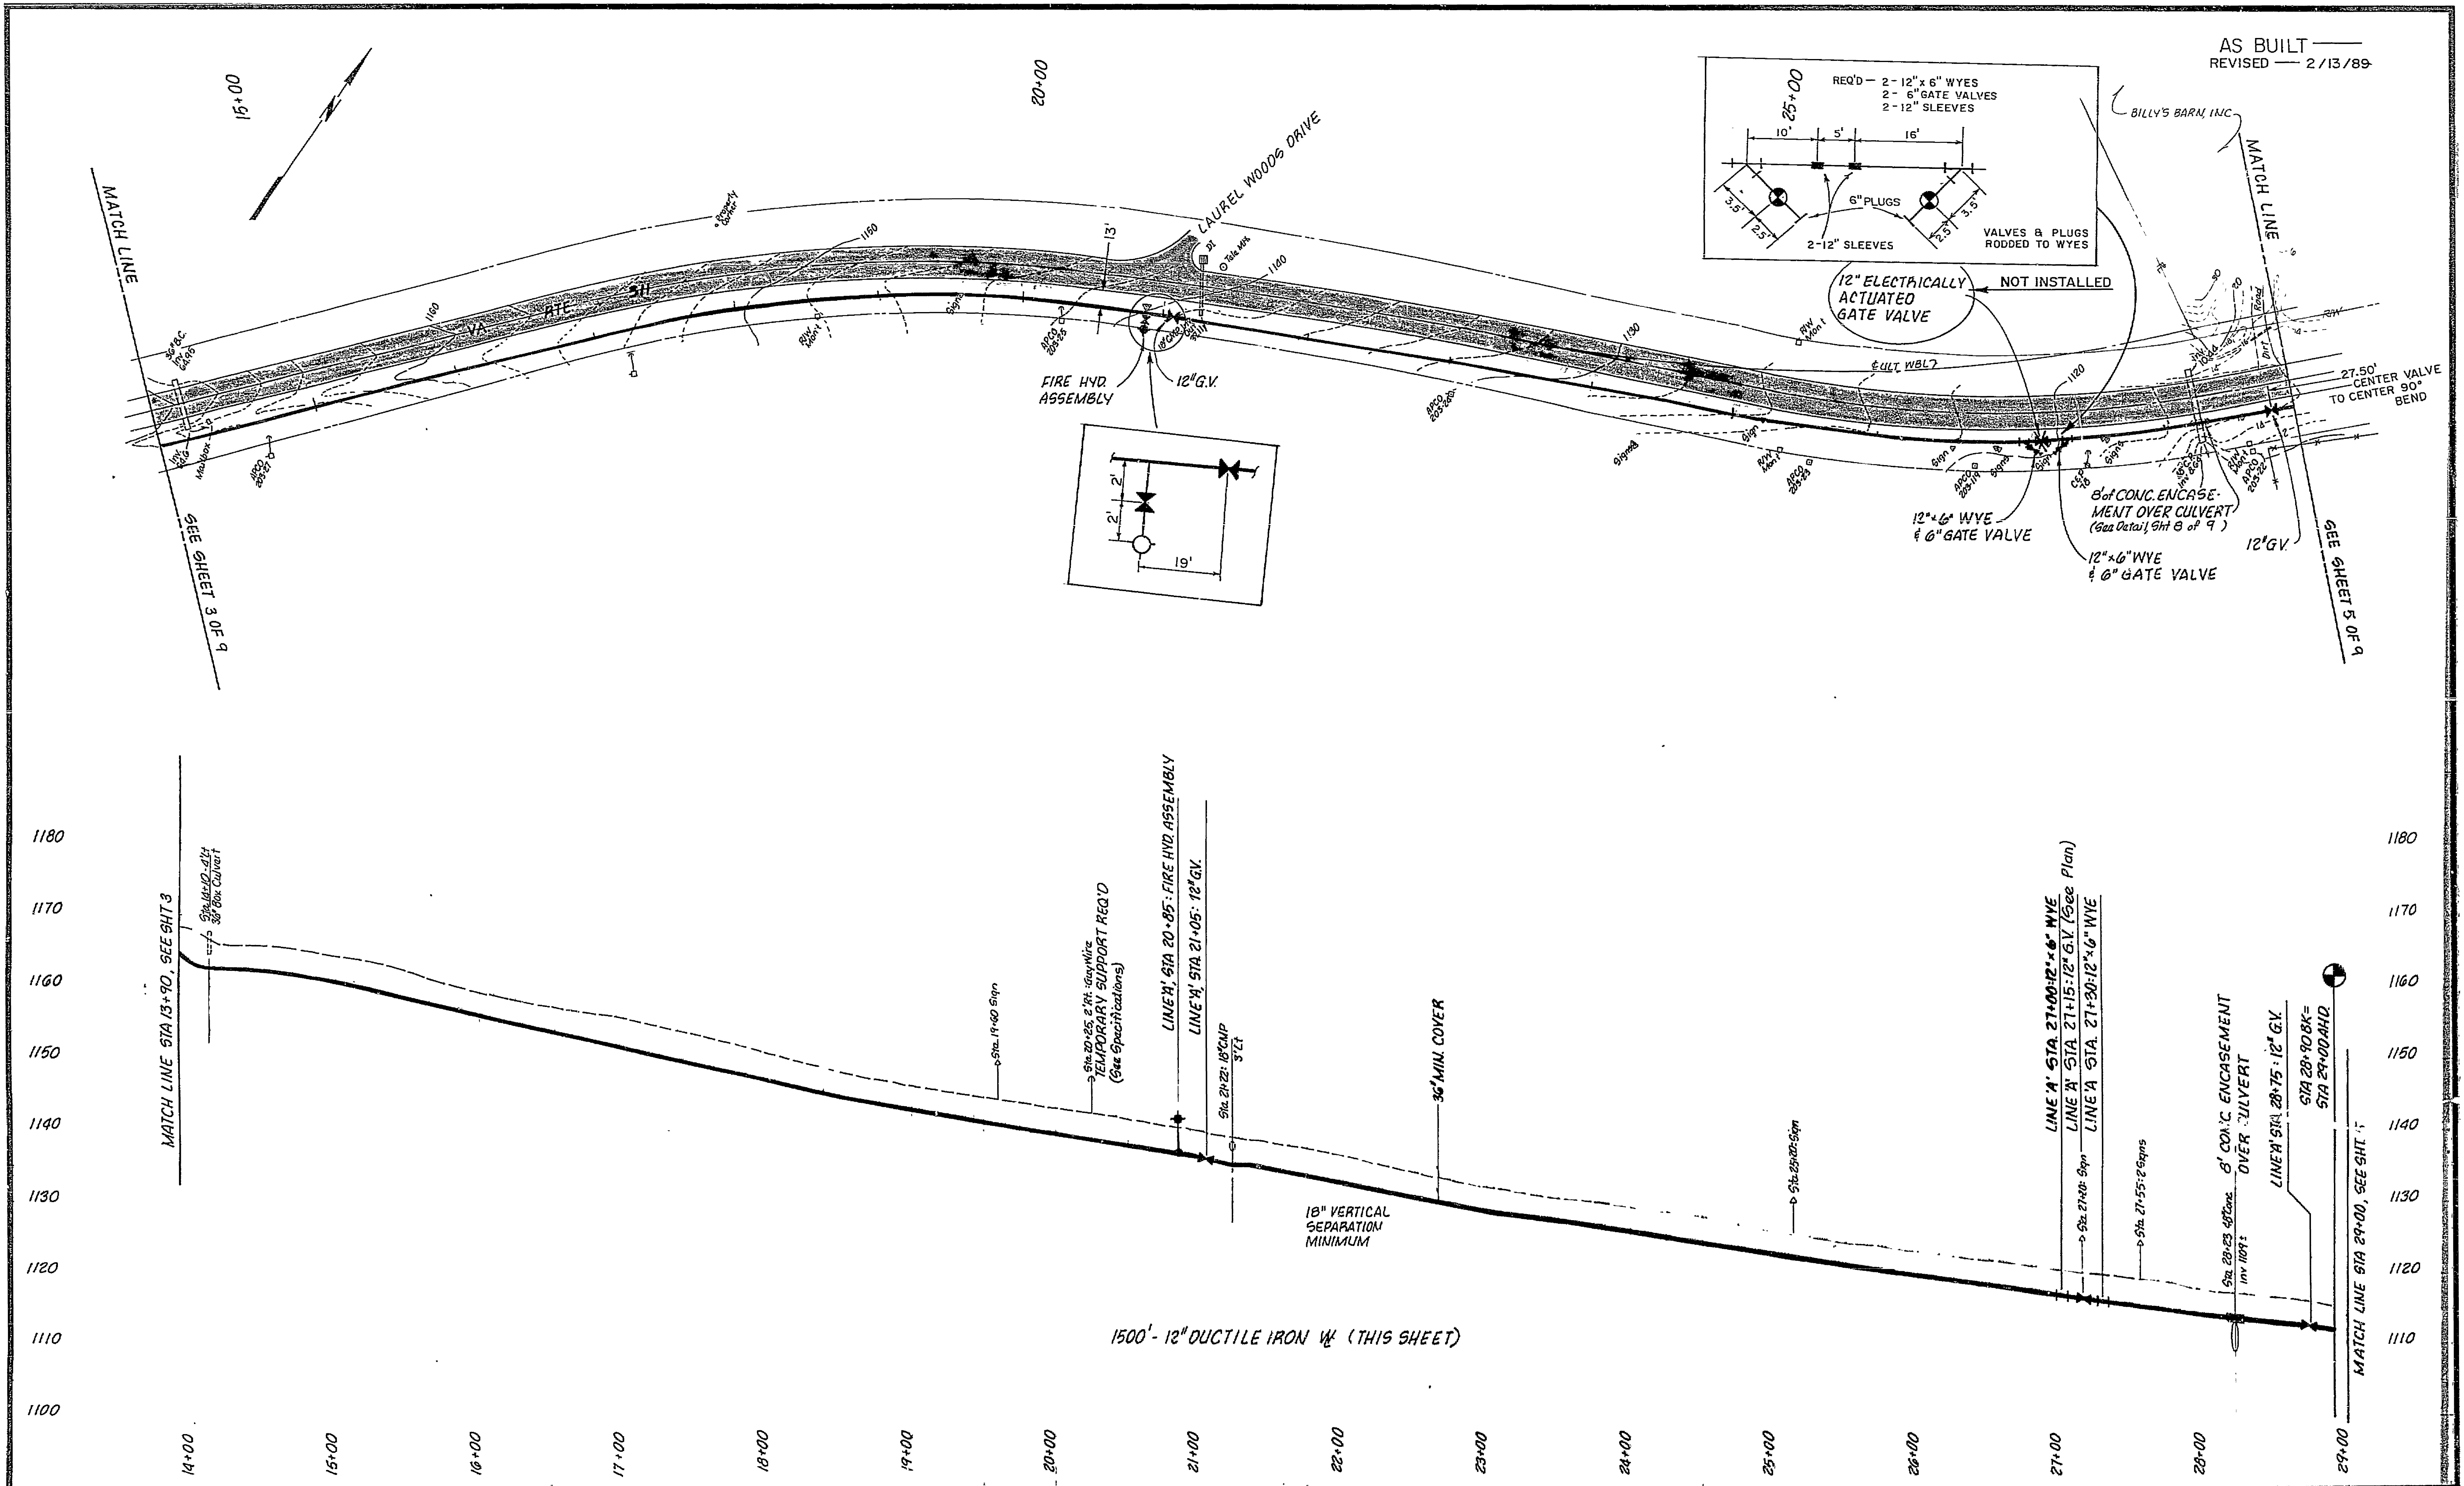
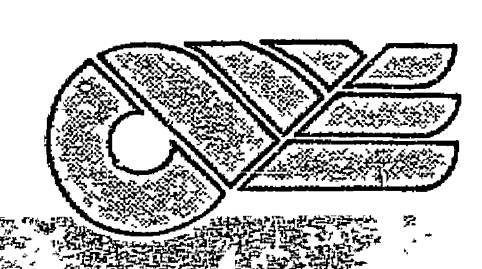
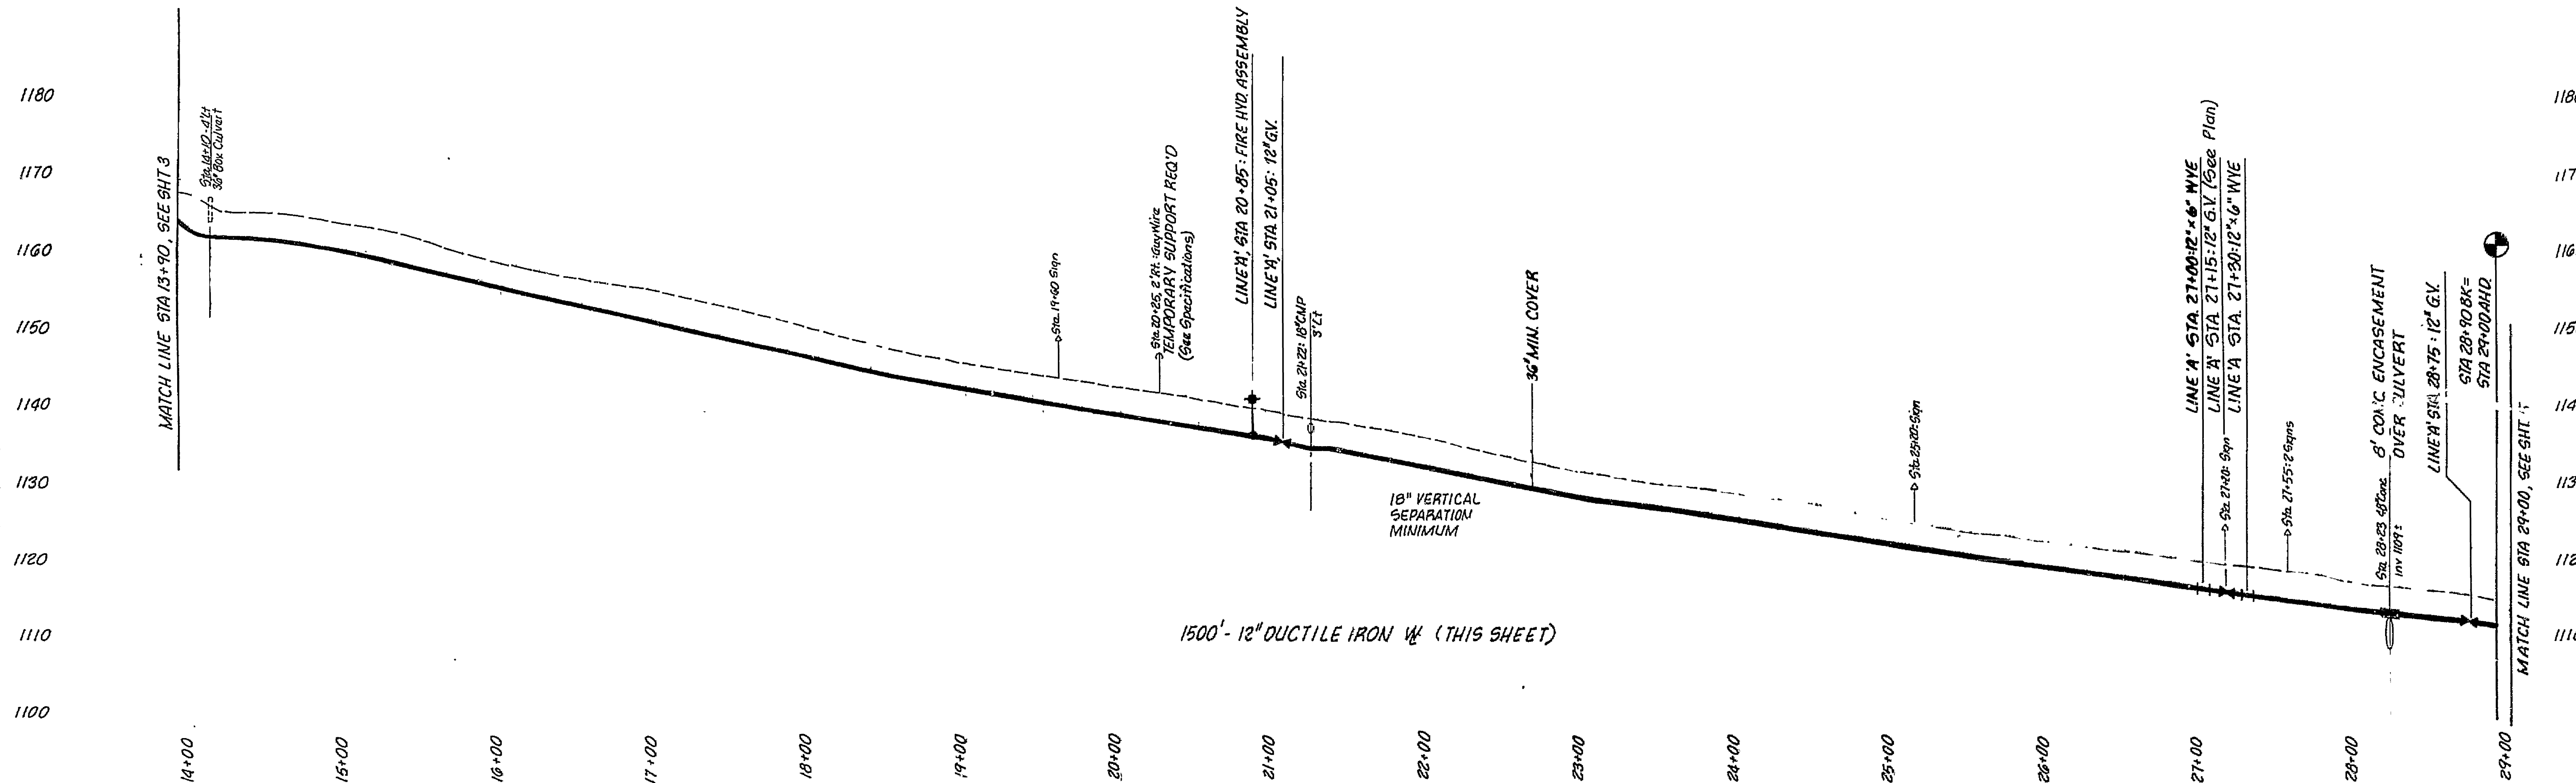


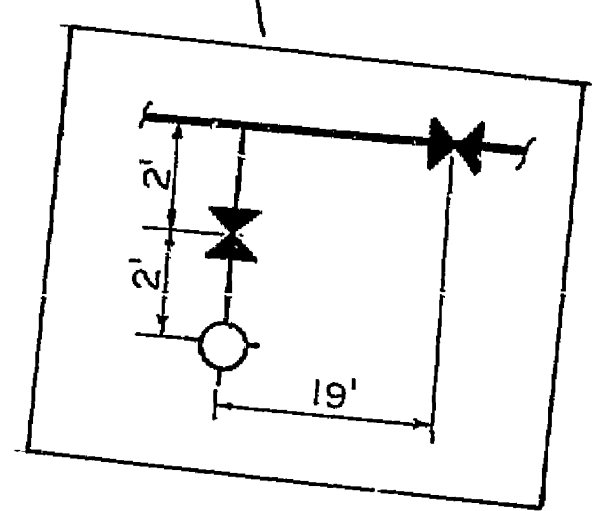

AS BUILT
REVISED 2/13/89

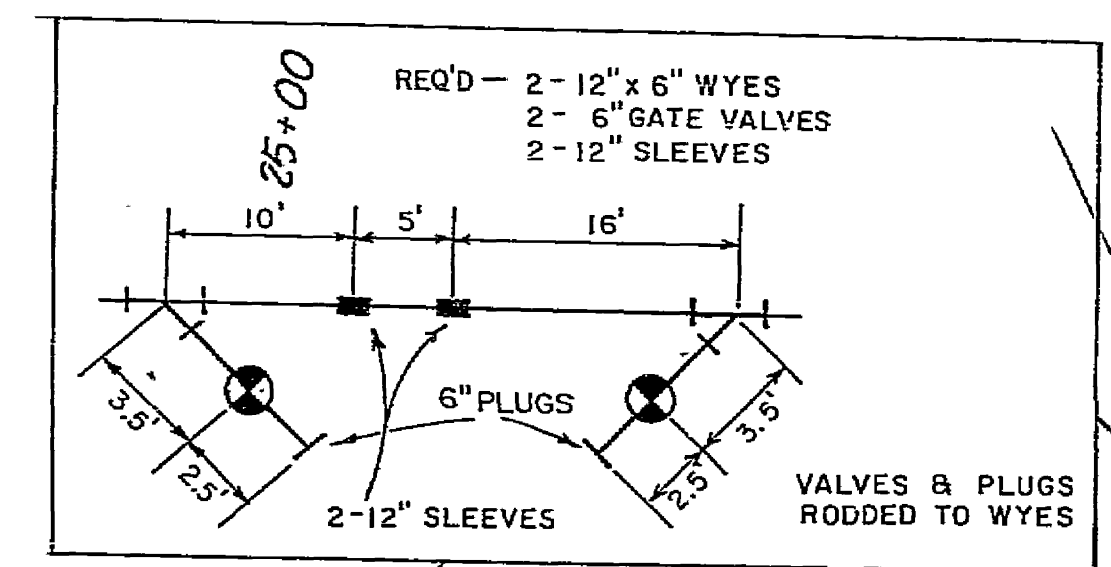

CLEAN WATER ENGINEERS, INC.

P.O. BOX 218 FINCASTLE, VIRGINIA 24090
P.O. BOX 3225 STAUNTON, VIRGINIA 24401

**ROANOKE COUNTY WATERLINE EXTENSION
VIRGINIA ROUTE 311/HANGING ROCK VICINITY
ROANOKE COUNTY, VIRGINIA**

David J. Raby
DATE: 12/1/88

REVISIONS		
NO.	DATE	BY
1		
2		
3		
4		

DESIGNED: WGP	SHEET: 4 OF 8
DRAWN: LHJ	SCALE: 1" = 50'
CHECKED: RCU/CCB	DATE: JAN 1989
APPROVED: DJR	PROJECT: 87079

88-02-W W-0196

