


AS BUILT
REVISED 2/13/89

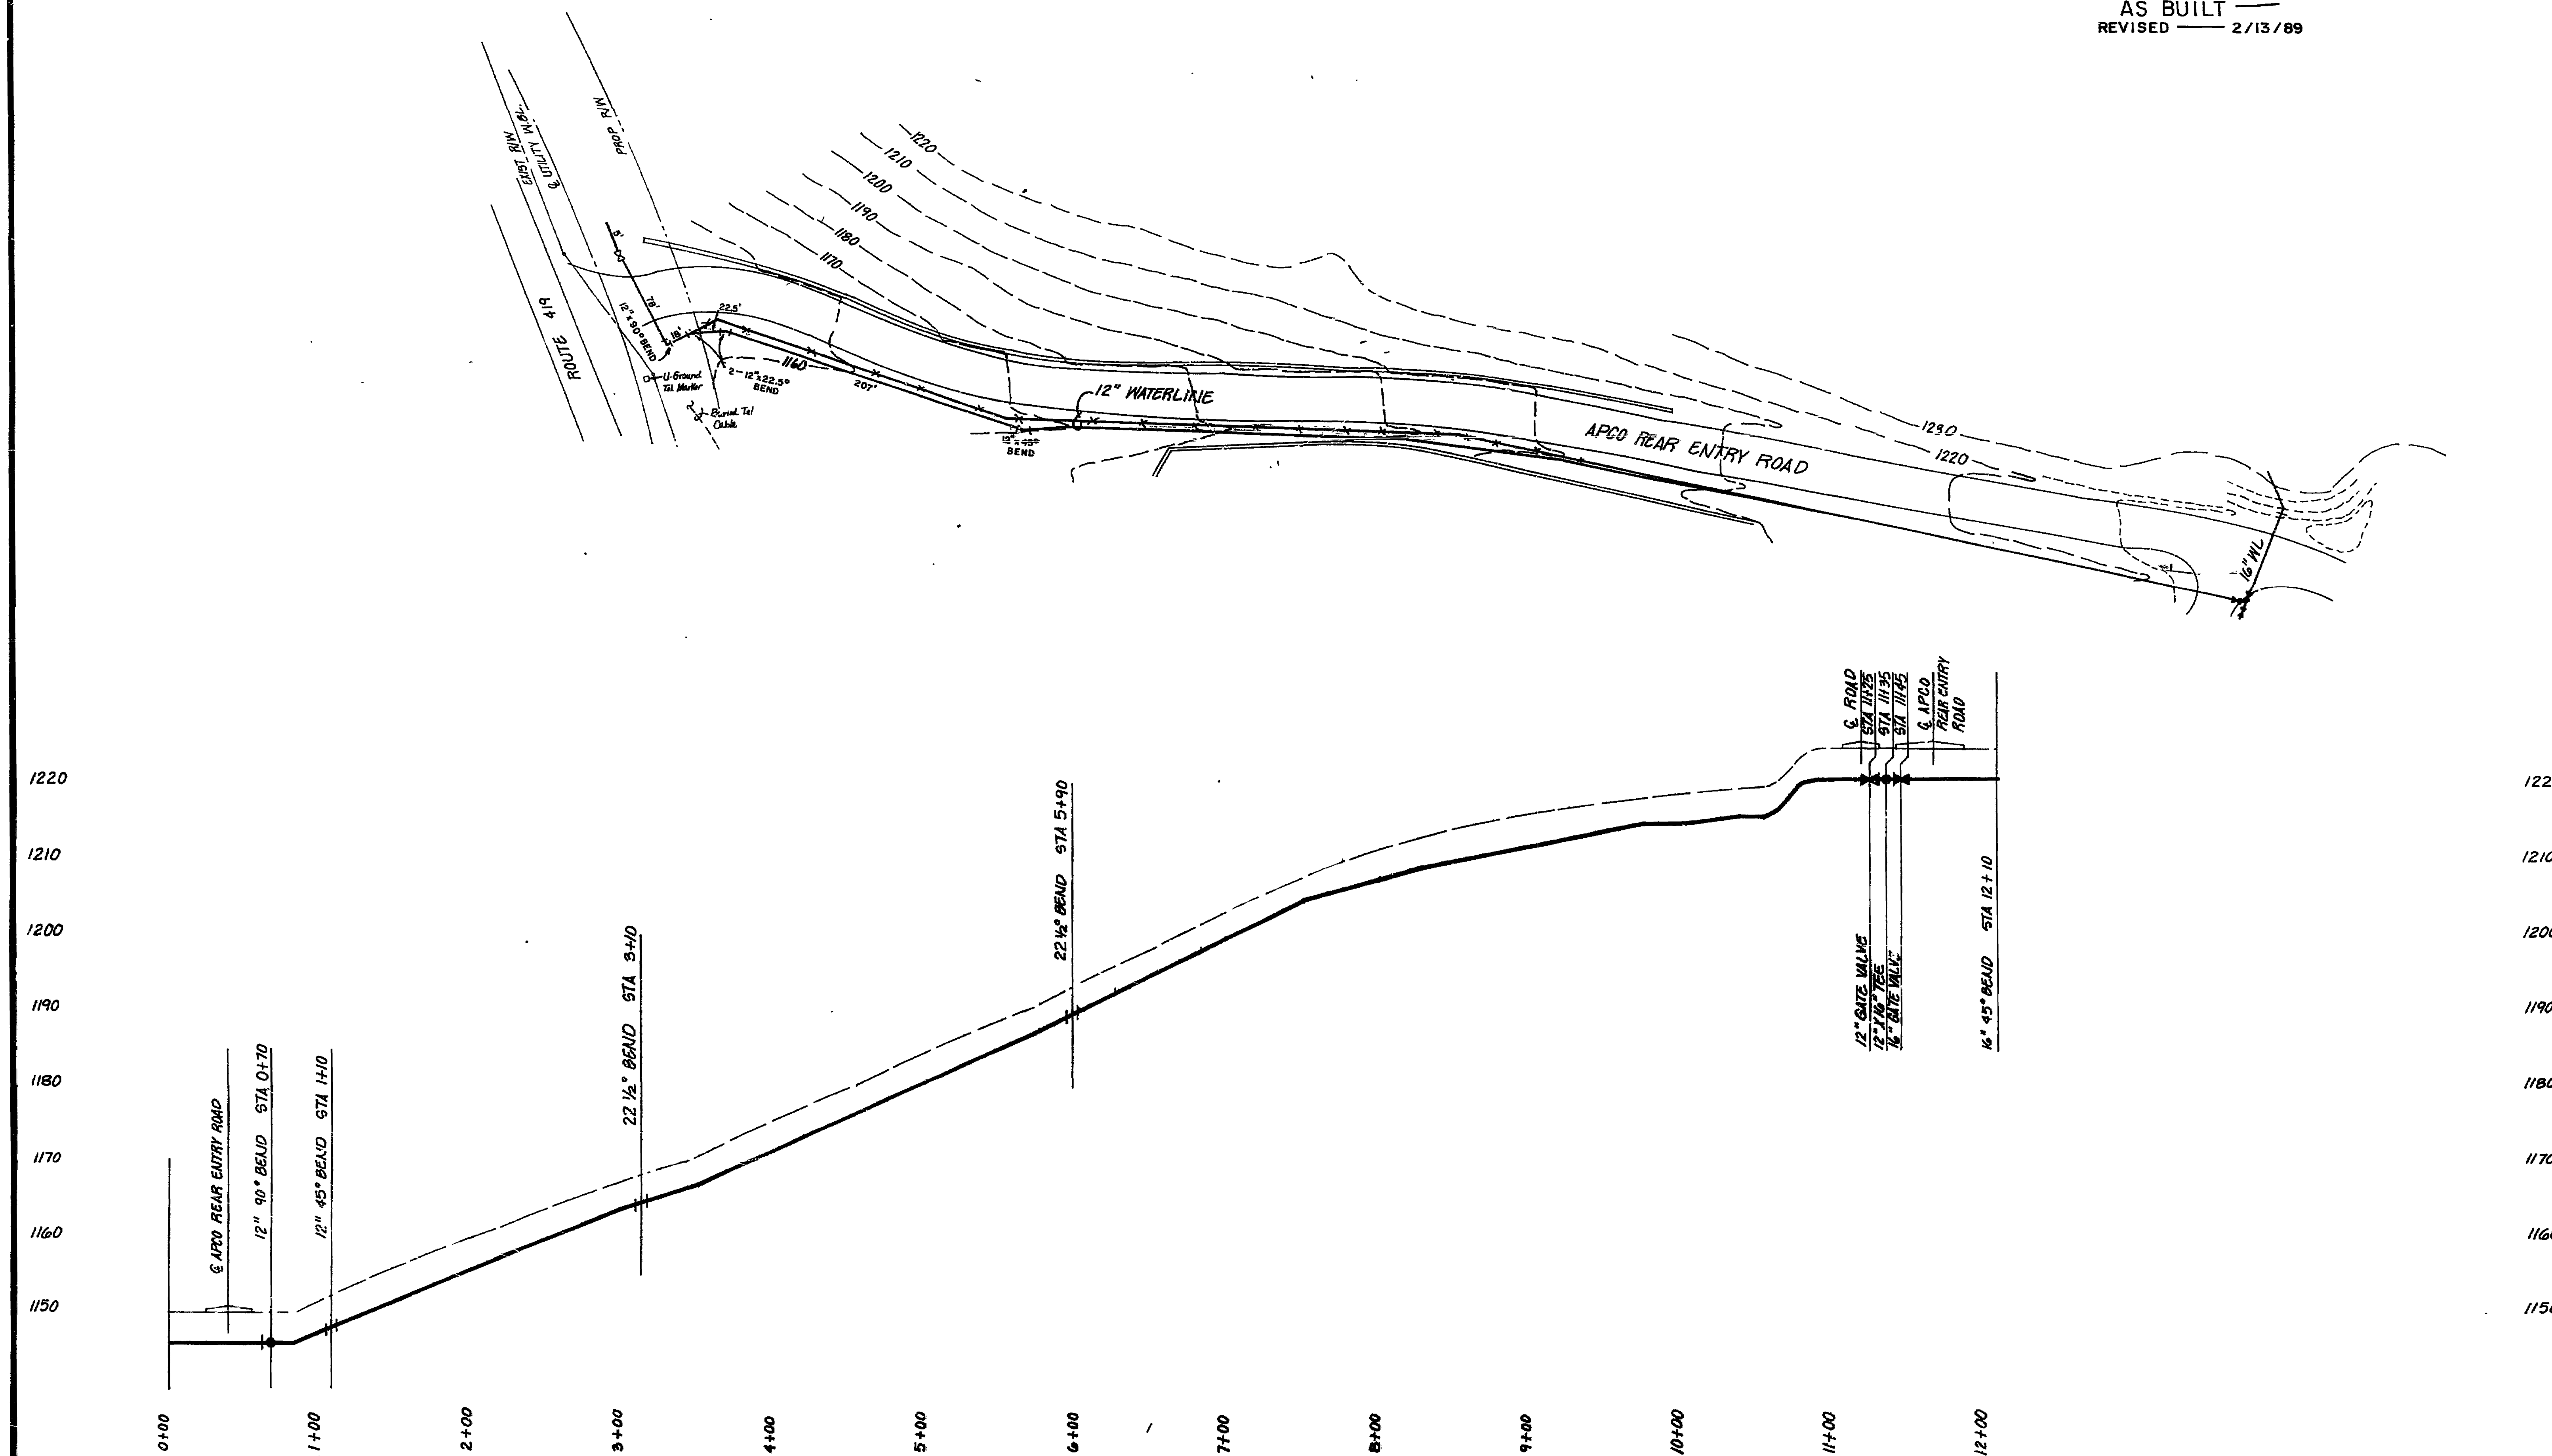

	ROANOKE COUNTY WATERLINE EXTENSION VIRGINIA ROUTE 311 / HANGING ROCK VICINITY ROANOKE COUNTY, VIRGINIA				REVISIONS			DESIGNED:	SHEET:
	NO.	DATE	BY		DRAWN:	SCALE:			
					CHECKED:	DATE:			
					APPROVED:	PROJECT:			

WT-0201 88-02-W

