

AS-BUILT APRIL 2, 2002

"AS-BUILT" 26 AUGUST 1997

DEVELOPMENT PLAN
FOR

"HANGING ROCK ESTATES"

SITUATED IN
CATAWBA MAGISTERIAL DISTRICT
ROANOKE COUNTY, VIRGINIA

DATE: 23 JUNE 1995
REVISED: 19 JANUARY 1996
REVISED: 26 FEBRUARY 1996


REVISED: 9 APRIL 1996

PROPERTY OF
J. ROBERT CARLTON

"AS-BUILT"

NOTES:
1) "AS-BUILT" INFORMATION TAKEN FROM
PLANS FURNISHED BY ROANOKE COUNTY.
2) "AS-BUILT" DIMENSIONS SHOWN IN
BRACKETS.

NORTH LOOP WATER LINE
ONLY

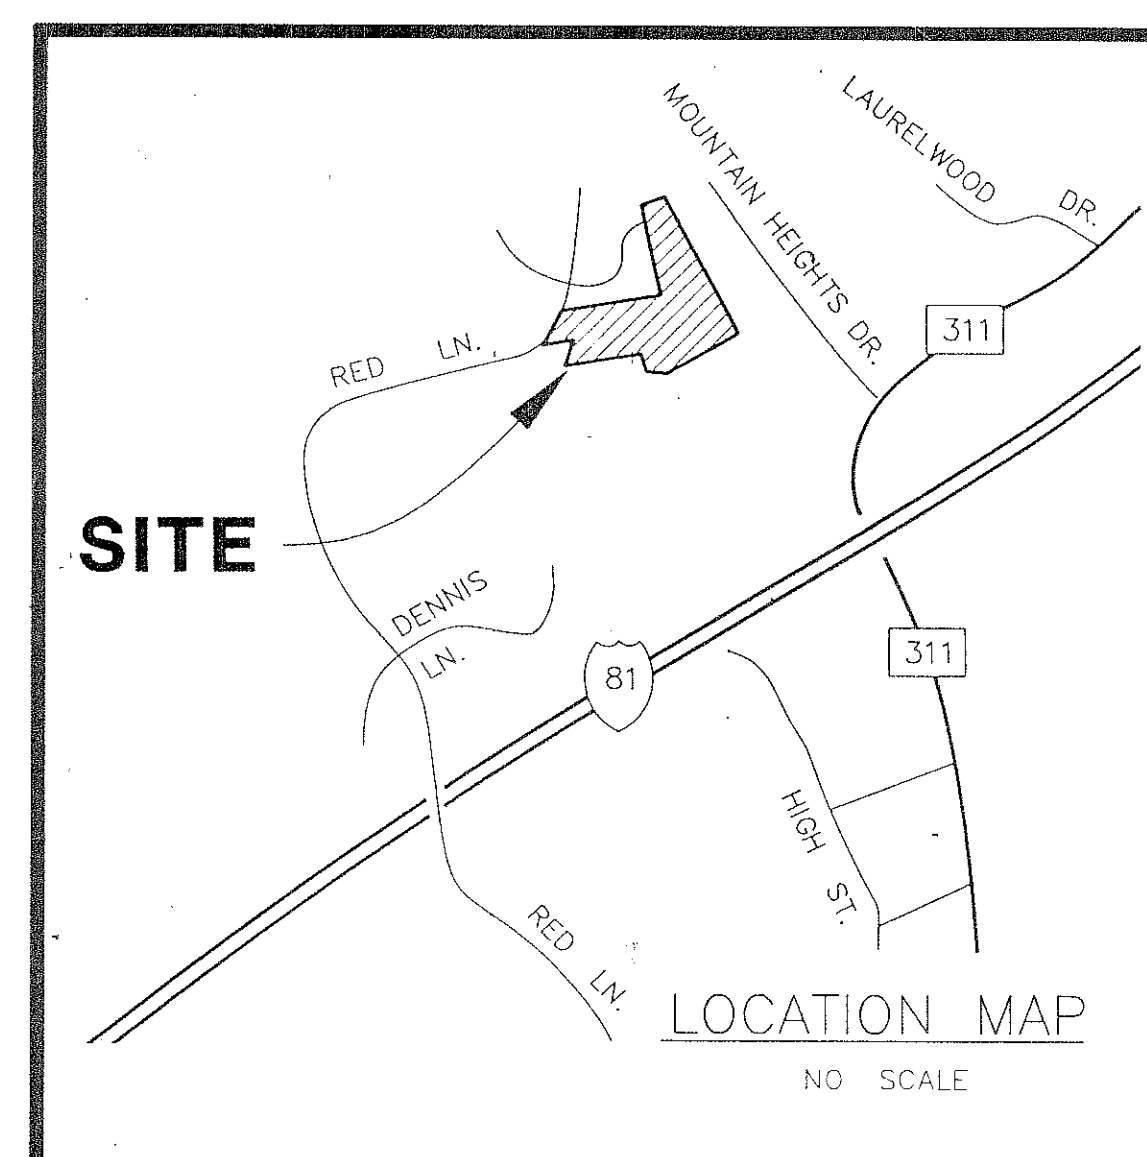

INDEX OF DRAWINGS

SHEET No.	DESCRIPTION
1.	LUMSDEN ASSOCIATES COVER SHEET
2.	ROANOKE COUNTY STD. COVER SHEET
3.	RECORD MAP
4.	NOTES & DETAILS
5.	DIMENSIONAL LAYOUT & UTILITIES
6.	DIMENSIONAL LAYOUT & UTILITIES
7.	GRADING & STORM DRAINAGE PLAN
8.	GRADING & STORM DRAINAGE PLAN
9.	ROAD & SANITARY SEWER PROFILES
10.	ROAD & SANITARY SEWER PROFILES
11.	SANITARY SEWER PROFILES
12.	STORM SEWER PROFILES & DETENTION POND DETAILS
13.	EROSION CONTROL PLAN
14.	EROSION CONTROL PLAN
15.	SEDIMENT BASIN DETAILS
16.	ROANOKE CO. STD. EROSION CONTROL DETAIL SHEET
17.	ROANOKE CO. STD. WATER DETAIL SHEET
18.	ROANOKE CO. STD. SANITARY SEWER DETAIL SHEET

LUMSDEN ASSOCIATES, P.C.
ENGINEERS-SURVEYORS-PLANNERS
ROANOKE, VIRGINIA

RC-6784

#94-993

SHEET 1 OF 18