



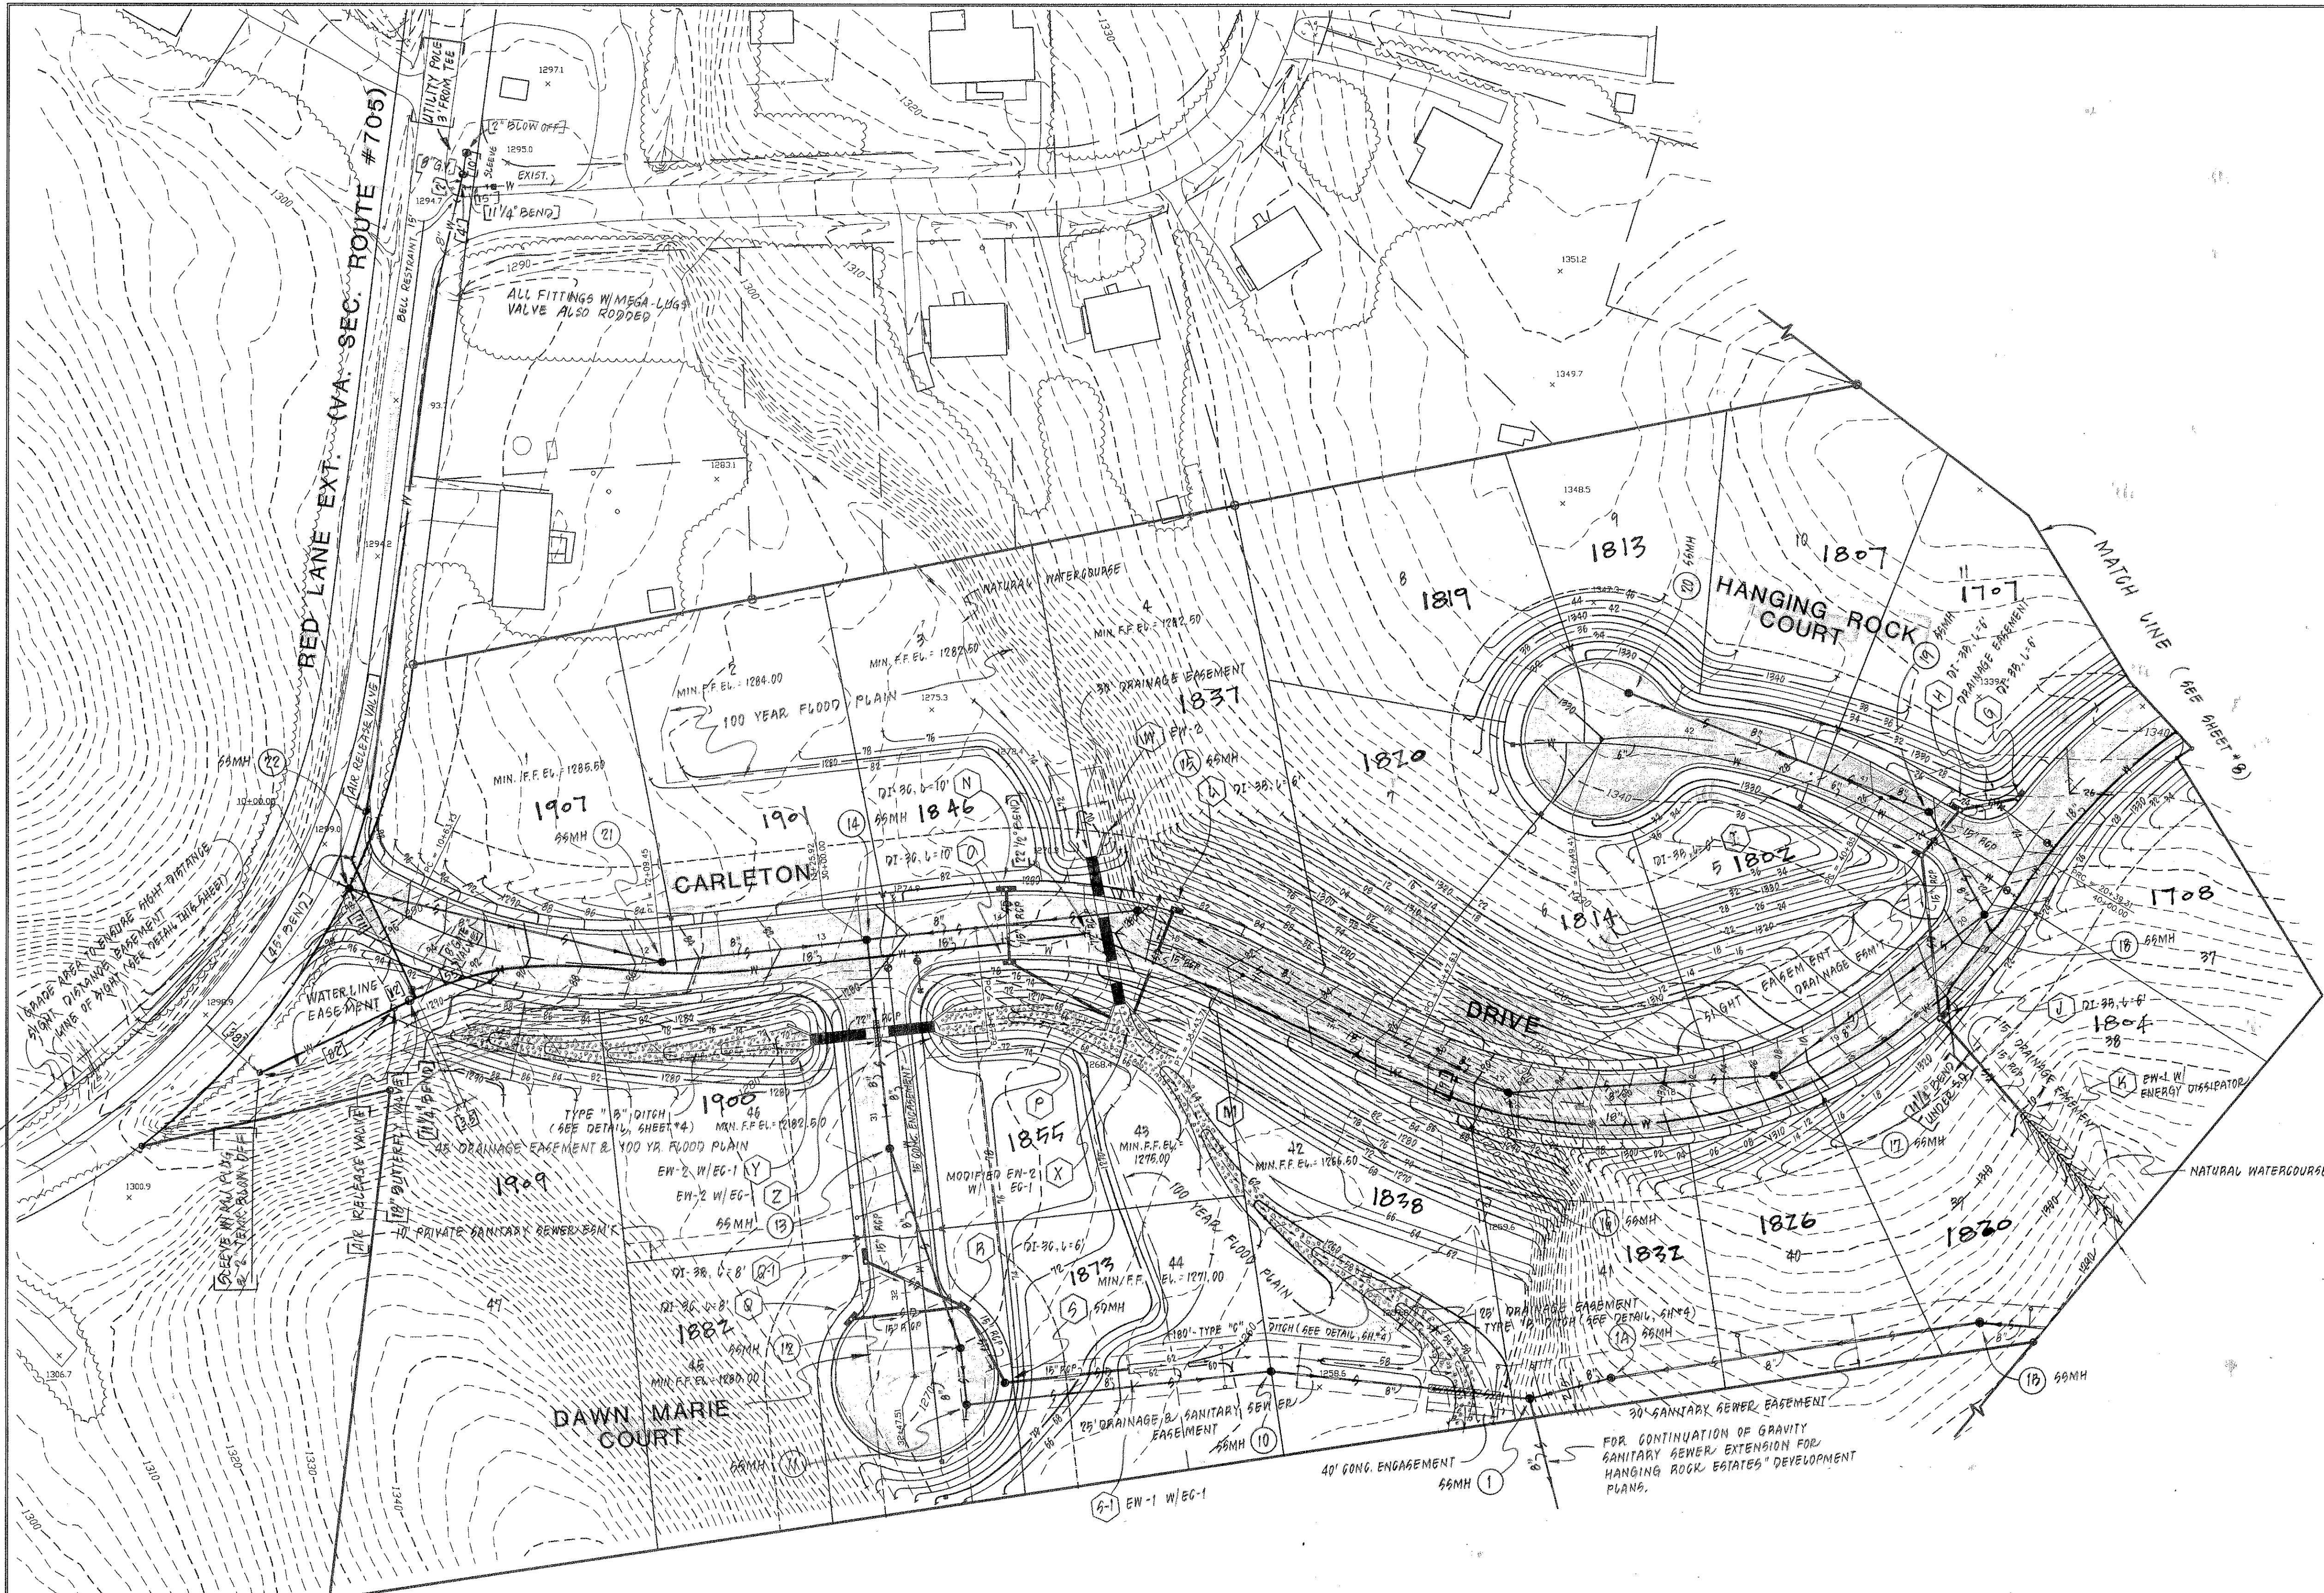

LEGEND

EXISTING	PROPOSED	DESCRIPTION
		STORM DRAIN LINE
		SANITARY SEWER LINE
		WATER LINE
		PAVEMENT
		CONCRETE CURB & GUTTER
		BLOW-OFF
		GATE VALVE
		CLEAN-OUT
		SINGLE WATER METER
		DOUBLE WATER METER
		DROP INLET
		MANHOLE
		FIRE HYDRANT ASSEMBLY
		CONTOURS

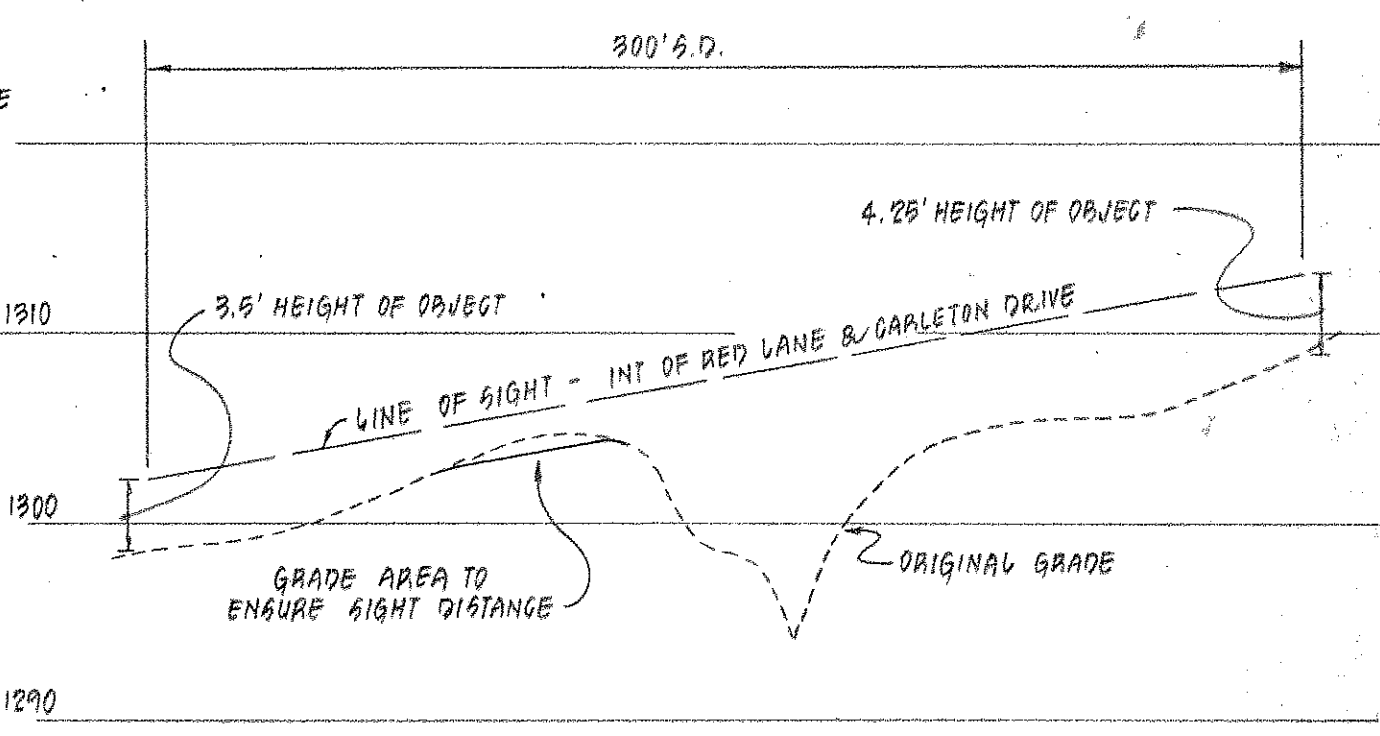

LINE OF SIGHT DETAIL
SCALE: 1" = 50' HORIZ
1" = 10' VERT.

BENCHMARK:
R.H. NAIL IN CITY OF SALEM POLE # 3127-4091, ELEV. = 1176.73
7-11-97 18" WATER LINE 'AS-BUILT'

REVISION	DATE	DESCRIPTION
5	4-17-96	REVISED GRADING OF HANGING ROCK COURT.
4	2-26-96	REVISED GRADING & R/W OF HANGING ROCK COURT.
3	1-19-96	REVISED LOTS, DAWN MARIE COURT, GRADING & STORM DRAINAGE.
2	9/21/95	REVISED STRUCTURE "Y" & "Z" TO MATCH PROFILE.
1	6/29/95	ADDED SIGHT DISTANCE EASEMENT ON RED LANE

"AS BUILT"

DESIGNED	WAG, CAM
DRAWN	RAC
CHECKED	MSW

GRADING & STORM DRAINAGE FOR "HANGING ROCK ESTATES"
PREPARED FOR
J. ROBERT CARLTON
CATAMBA MAGISTERIAL DISTRICT
ROANOKE COUNTY, VIRGINIA

LUMSDEN ASSOCIATES, P.C.
ENGINEERS-SURVEYORS-PLANNERS
ROANOKE, VIRGINIA

SCALE: 1" = 50' COMM: # 94-359
DATE: 23 JUNE 1995 SHEET 7 of 19

