
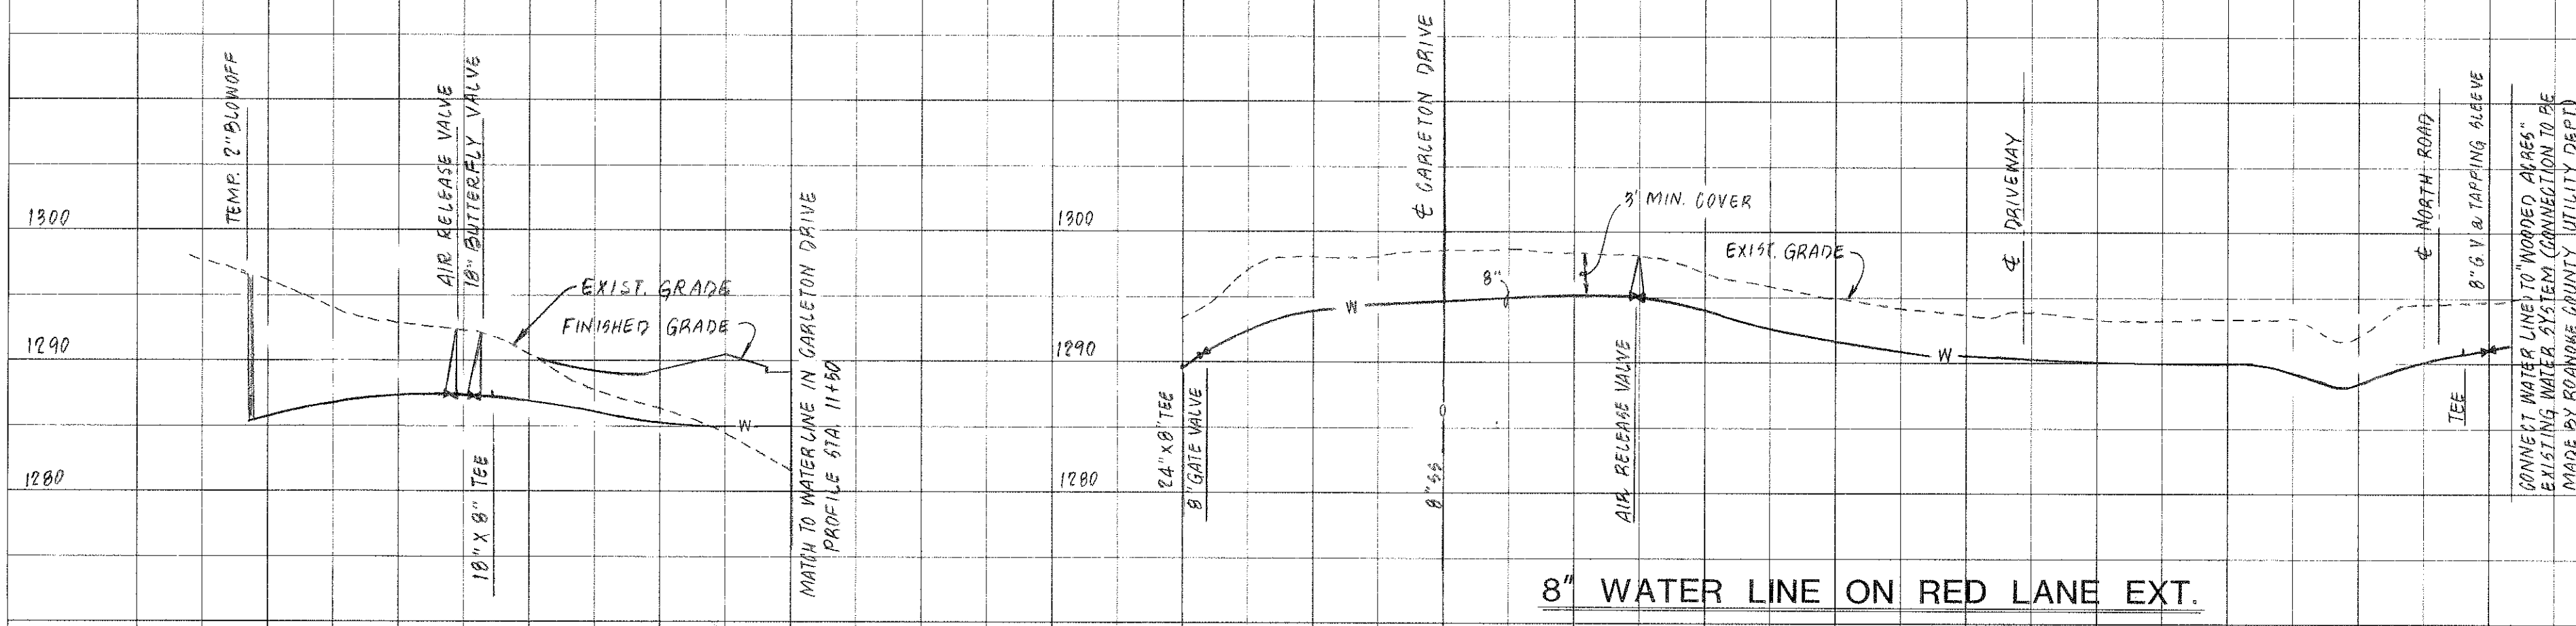
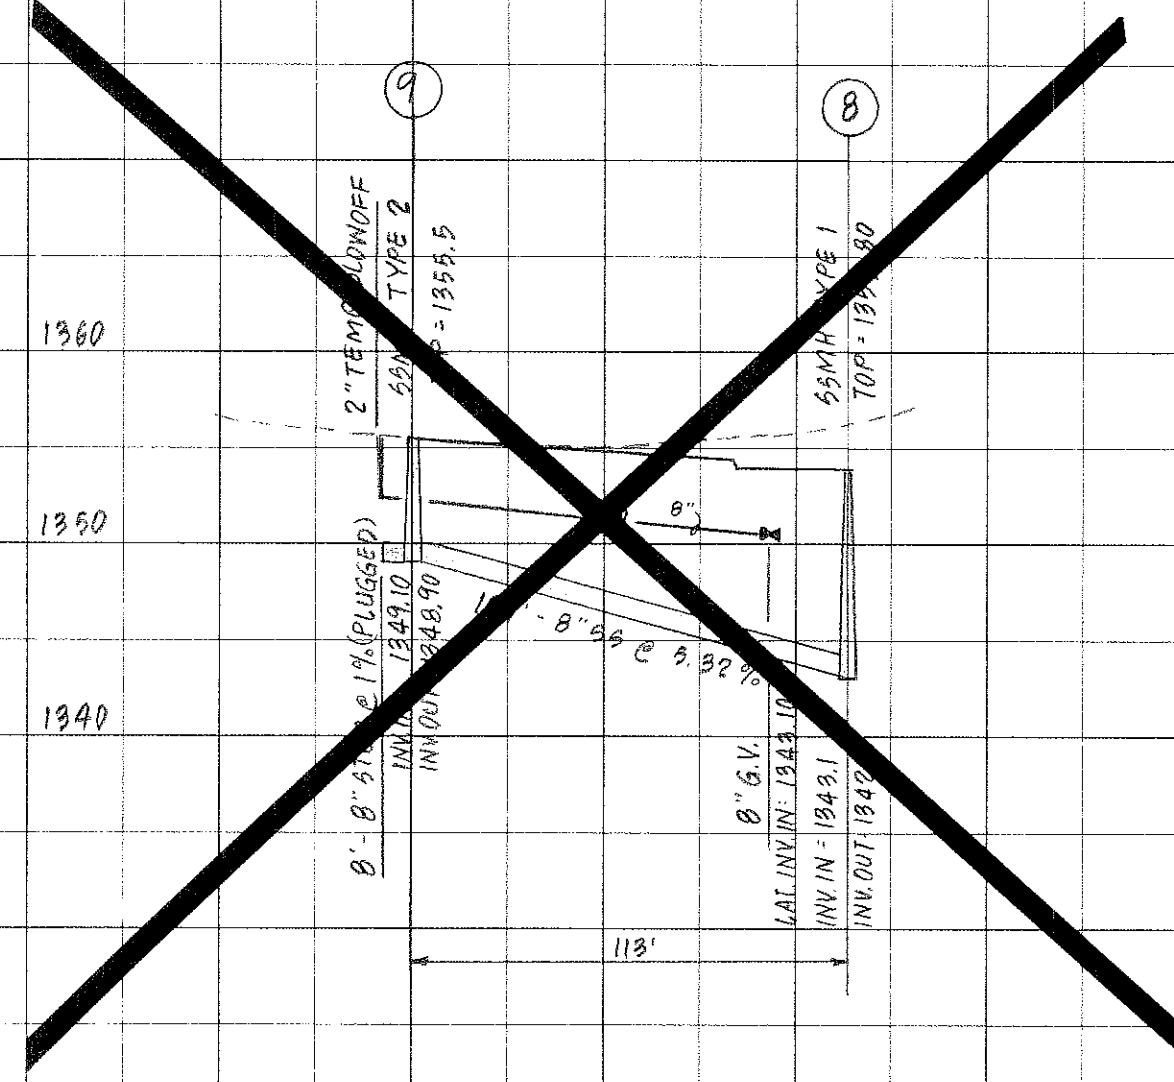
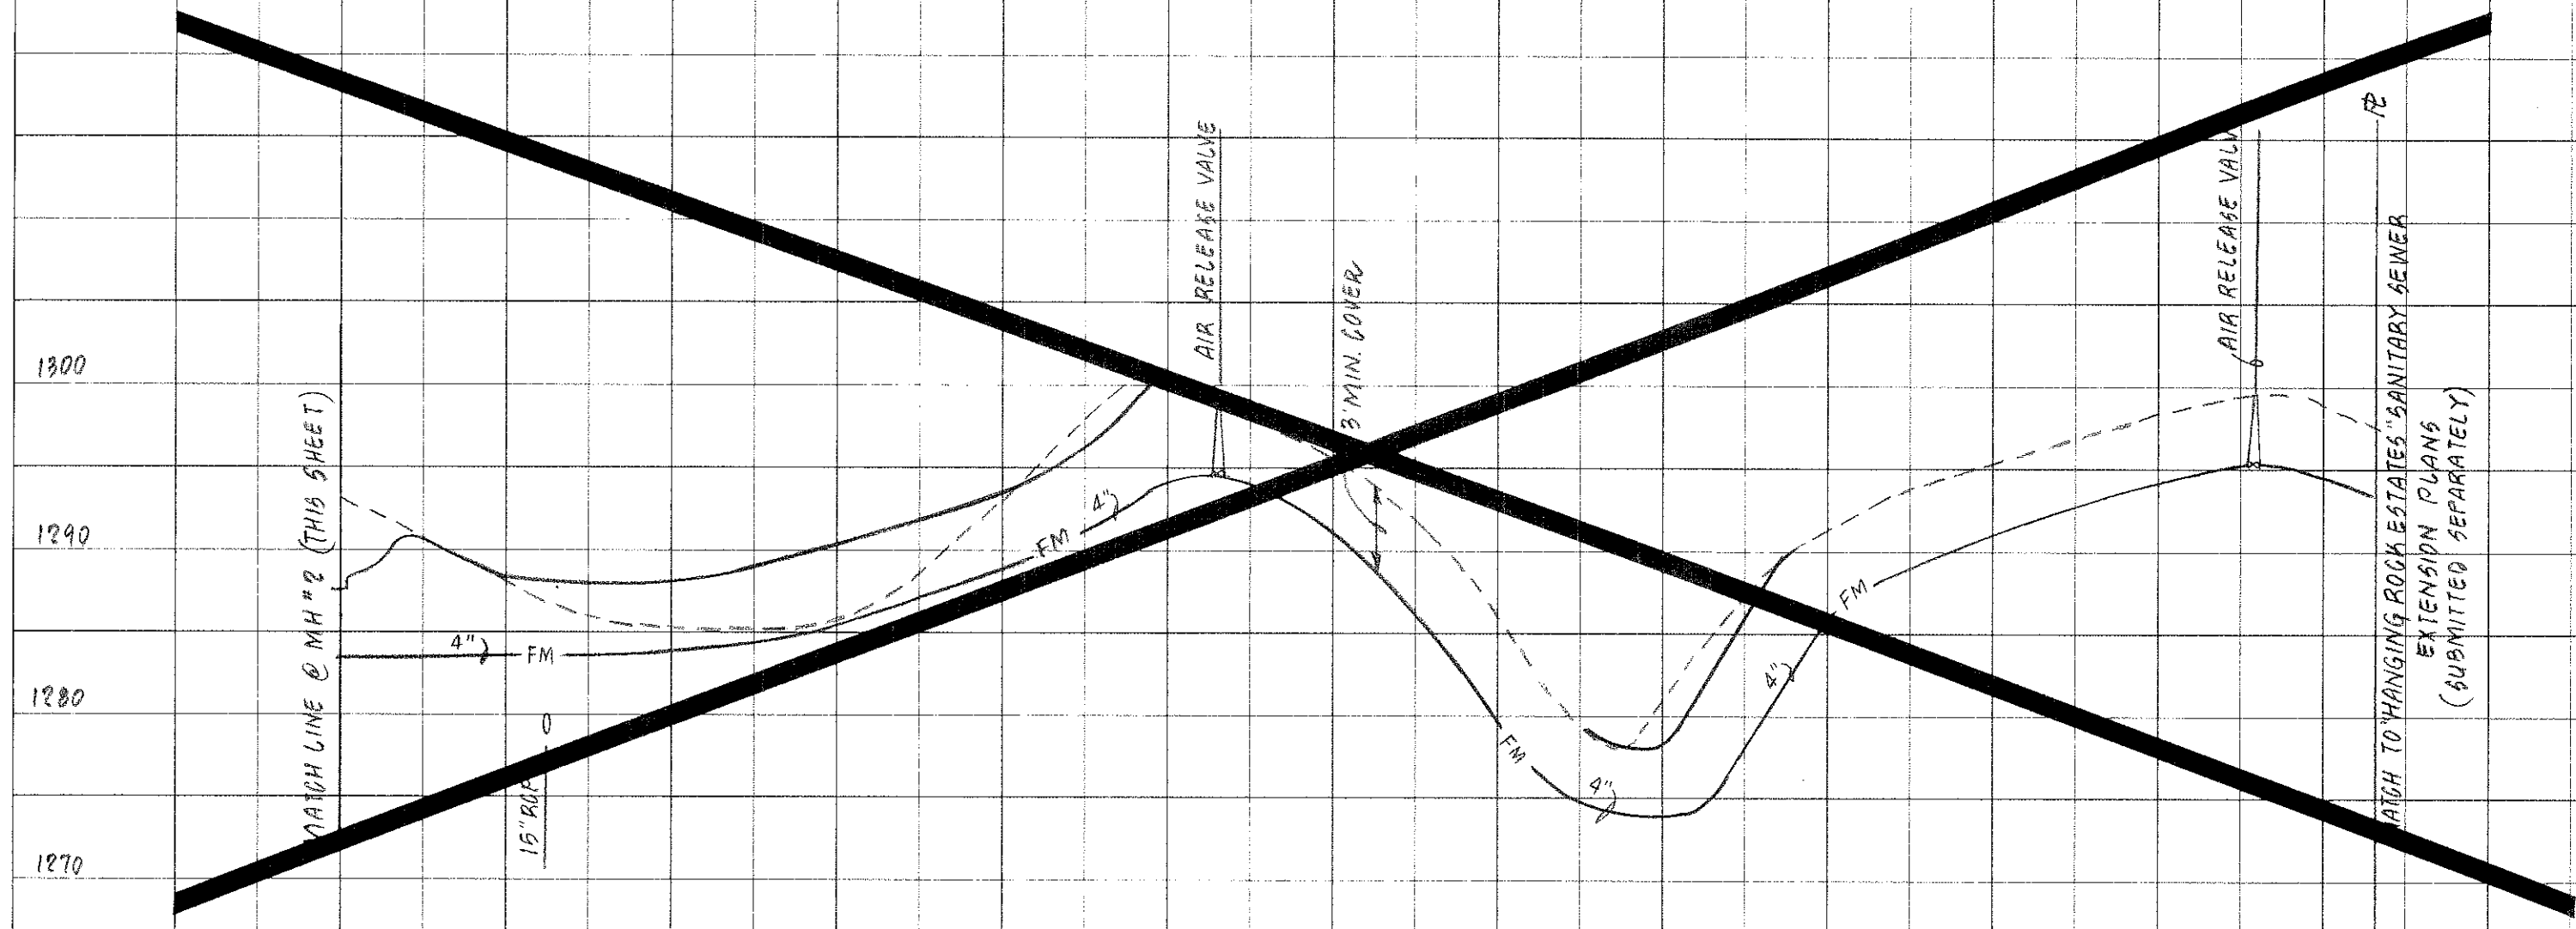
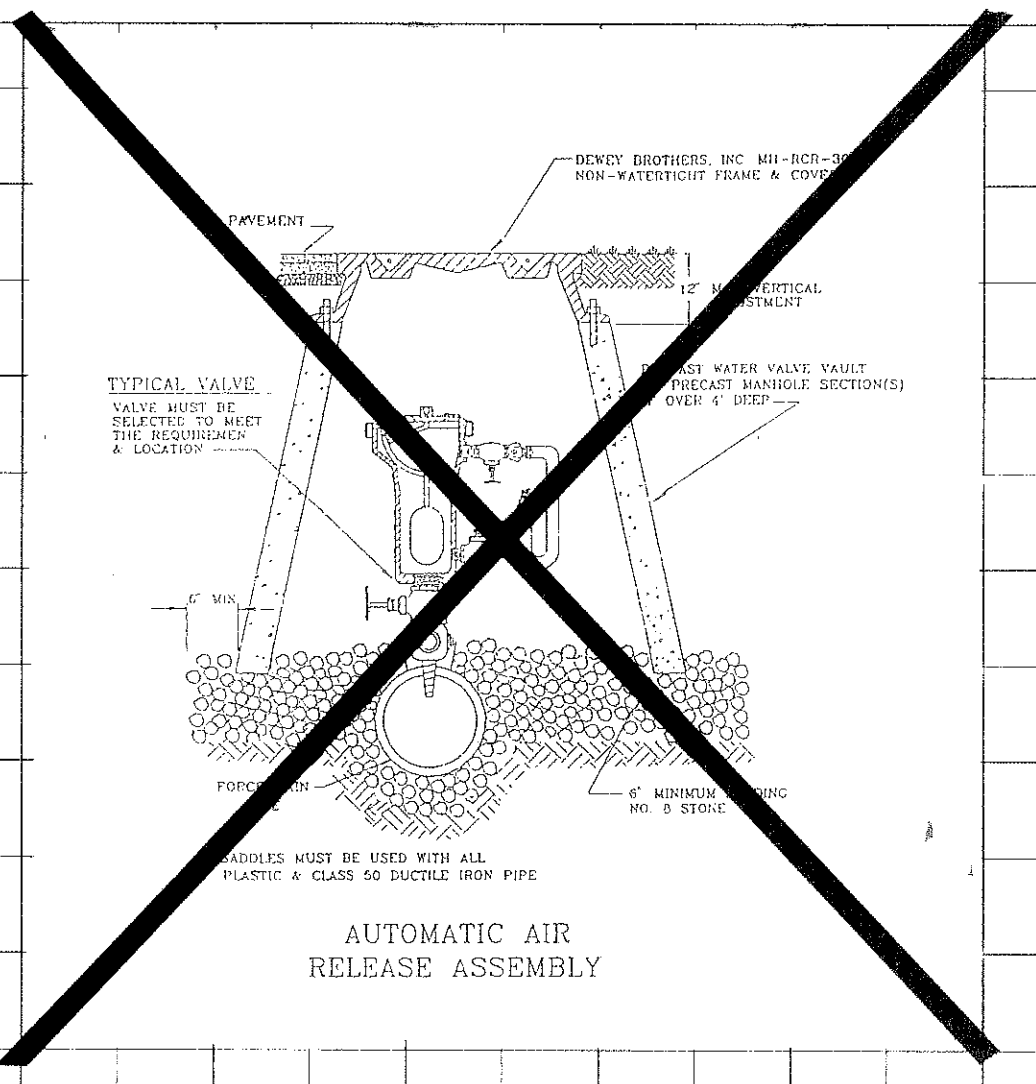


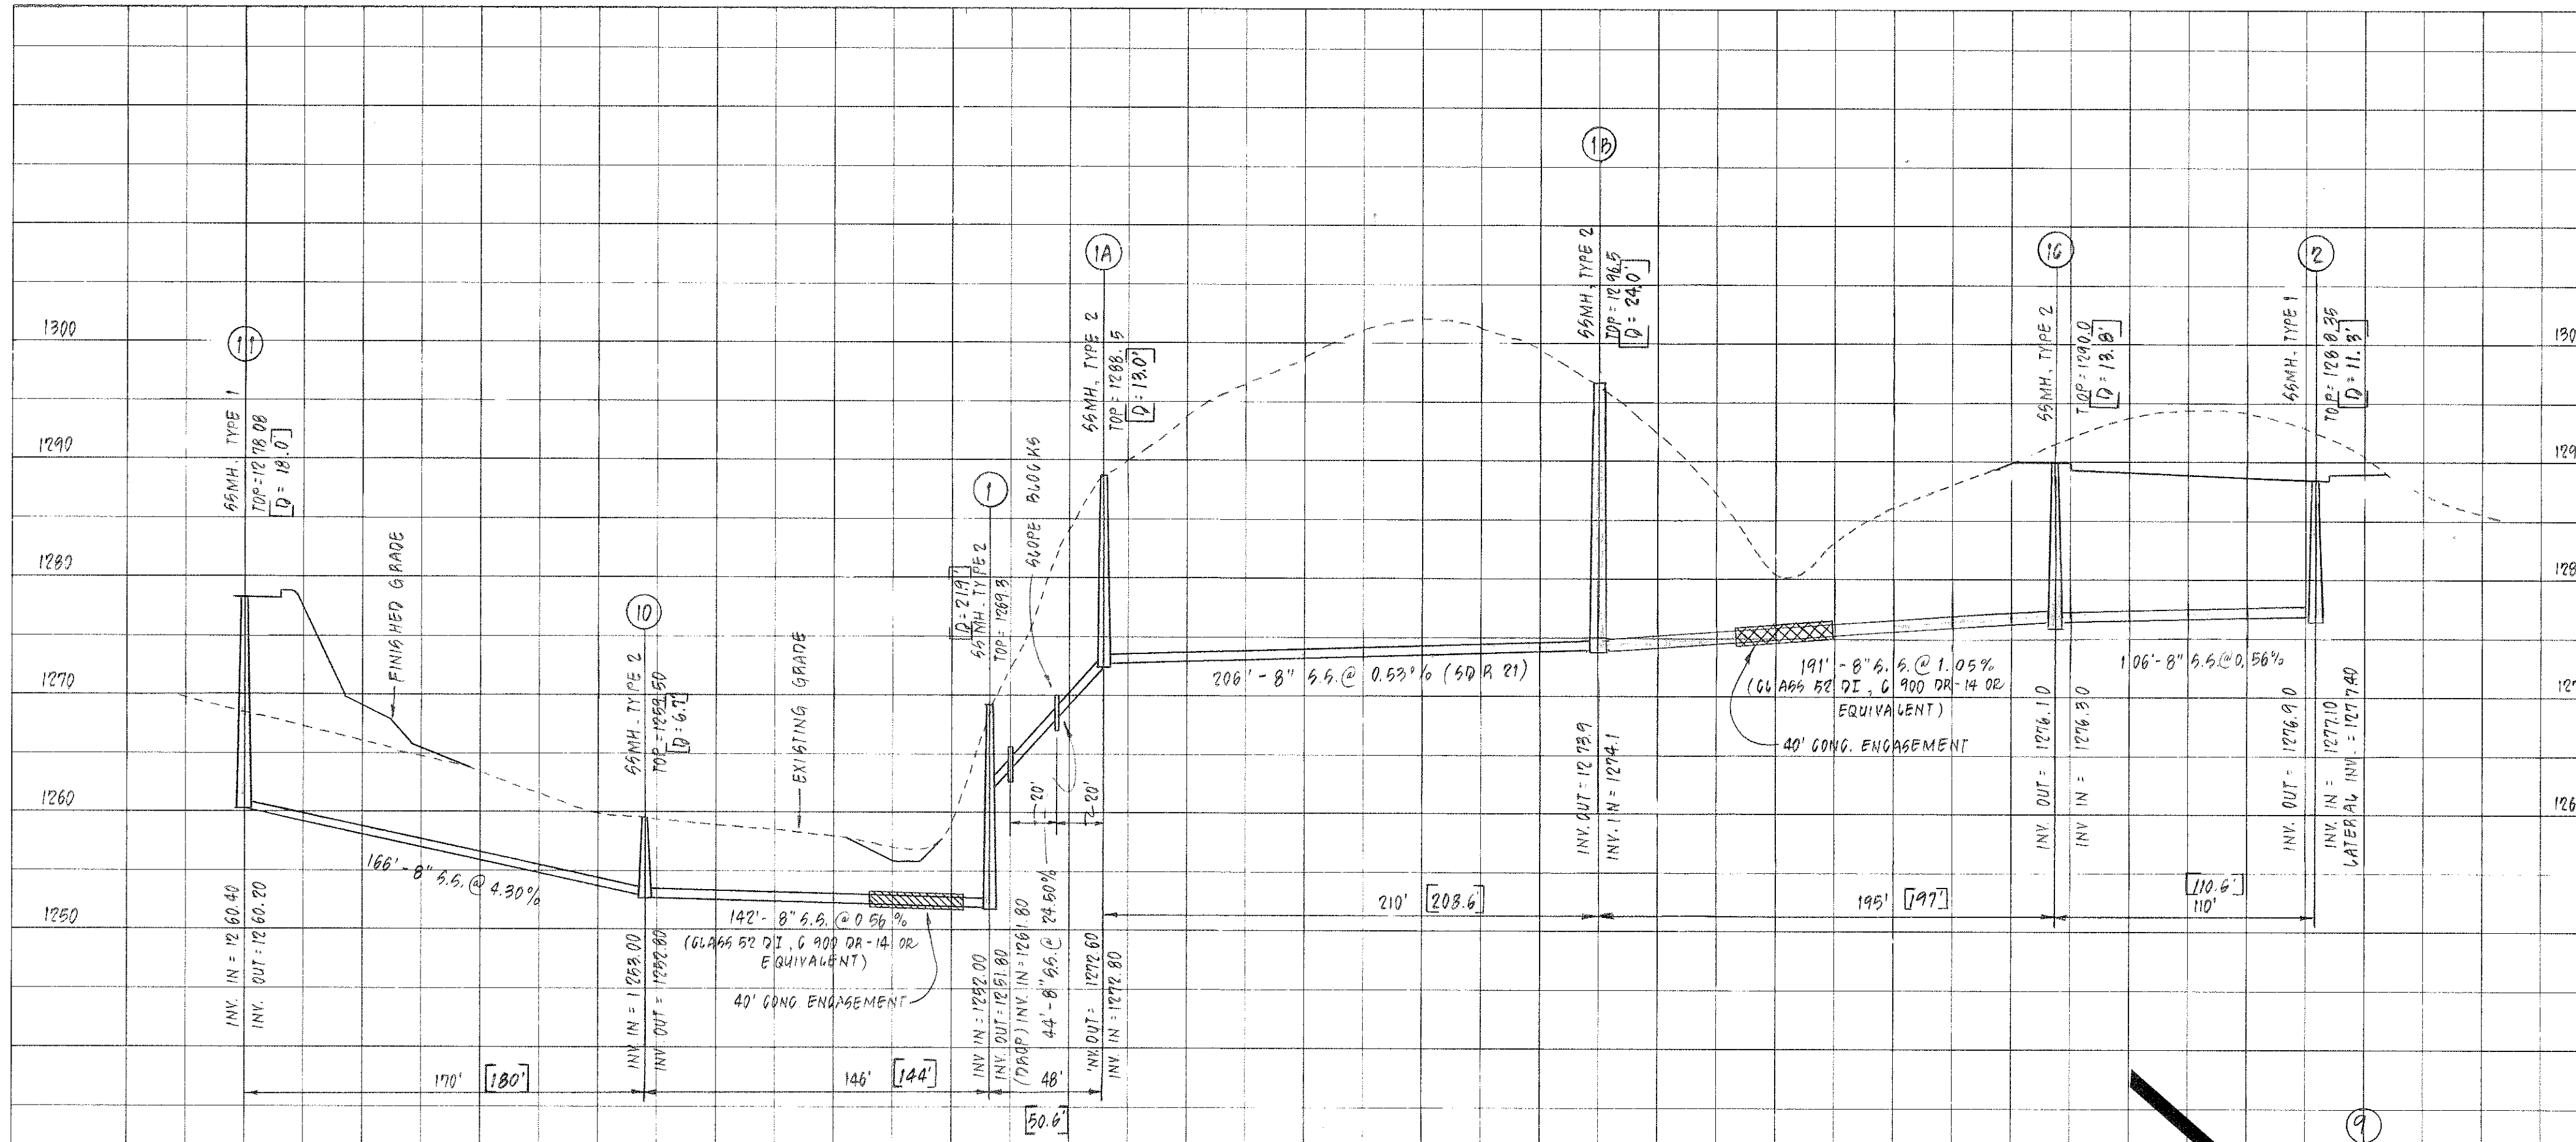

[18"] WATER LINE PROFILE

8" WATER LINE ON RED LANE EXT.


"AS-BUILT" 4/2/02 IN BRACKETS

- NOTES:
- ALL SANITARY SEWER MANHOLES DEPICTED WILL BE EITHER TYPE 1 OR TYPE 2 AS DEFINED BELOW.
 TYPE 1: SSMH WITH WATERTIGHT FRAME & COVER, 3000EC
 TYPE 2: SSMH WITH WATERTIGHT FRAME & COVER, RCR 3000W
 - ALL SANITARY SEWER MANHOLE FRAME AND COVERS WILL BE SITUATED SO AS NOT TO BE LOCATED IN THE CURB & GUTTER.

REVISION	DATE	DESCRIPTION
3	7-11-97	"AS-BUILT" 18" WATER LINE
2	5-22-96	RAISED 66MH 5 (10' & 2' 1')
1	2-26-96	ADDED CONG. ENGAGEMENT & TYPE OF PIPE BETWEEN 66MH 10-1 AND 1A-1B-10
1	1-19-96	REVISED SANITARY SEWER PROFILES

DESIGNED **WAS**
 DRAWN **VW8**
 CHECKED **M5W**

SANITARY SEWER AND WATER PROFILES
 FOR
"HANGING ROCK ESTATES"
 PREPARED FOR
J. ROBERT CARLTON
 CATAWBA MAGISTERIAL DISTRICT
 ROANOKE COUNTY, VIRGINIA

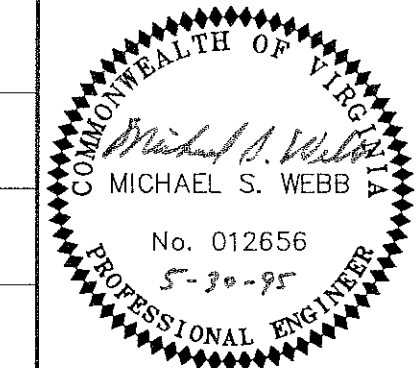

LUMSDEN ASSOCIATES, P.C.
 ENGINEERS-SURVEYORS-PLANNERS
 ROANOKE, VIRGINIA

SCALE: **HORIZ: 1"=50'**
VERT: 1"=10'

DATE: **29 JUNE 1995** SHEET **11 of 18**