

"AS-BUILT" SHOWN IN BRACKETS 25 JUNE 1998

DEVELOPMENT PLANS

AS-BUILT

APRIL 2, 2002

FOR

HANGING ROCK ESTATES

OFF-SITE SEWER EXTENSION

SITUATED IN

CATAWBA MAGISTERIAL DISTRICT
ROANOKE COUNTY, VIRGINIA


DATE: 2 AUGUST 1996

PREPARED FOR

J. ROBERT CARLTON

INDEX OF DRAWINGS

SHEET No.	DESCRIPTION
1.	LUMSDEN ASSOCIATES COVER SHEET
2.	ROANOKE COUNTY STD. COVER SHEET
3.	PLAN & PROFILES
4.	PLAN & PROFILES
5.	ROANOKE CO. STD. EROSION CONTROL DETAIL SHEET
6.	ROANOKE CO. SANITARY SEWER DETAIL SHEET

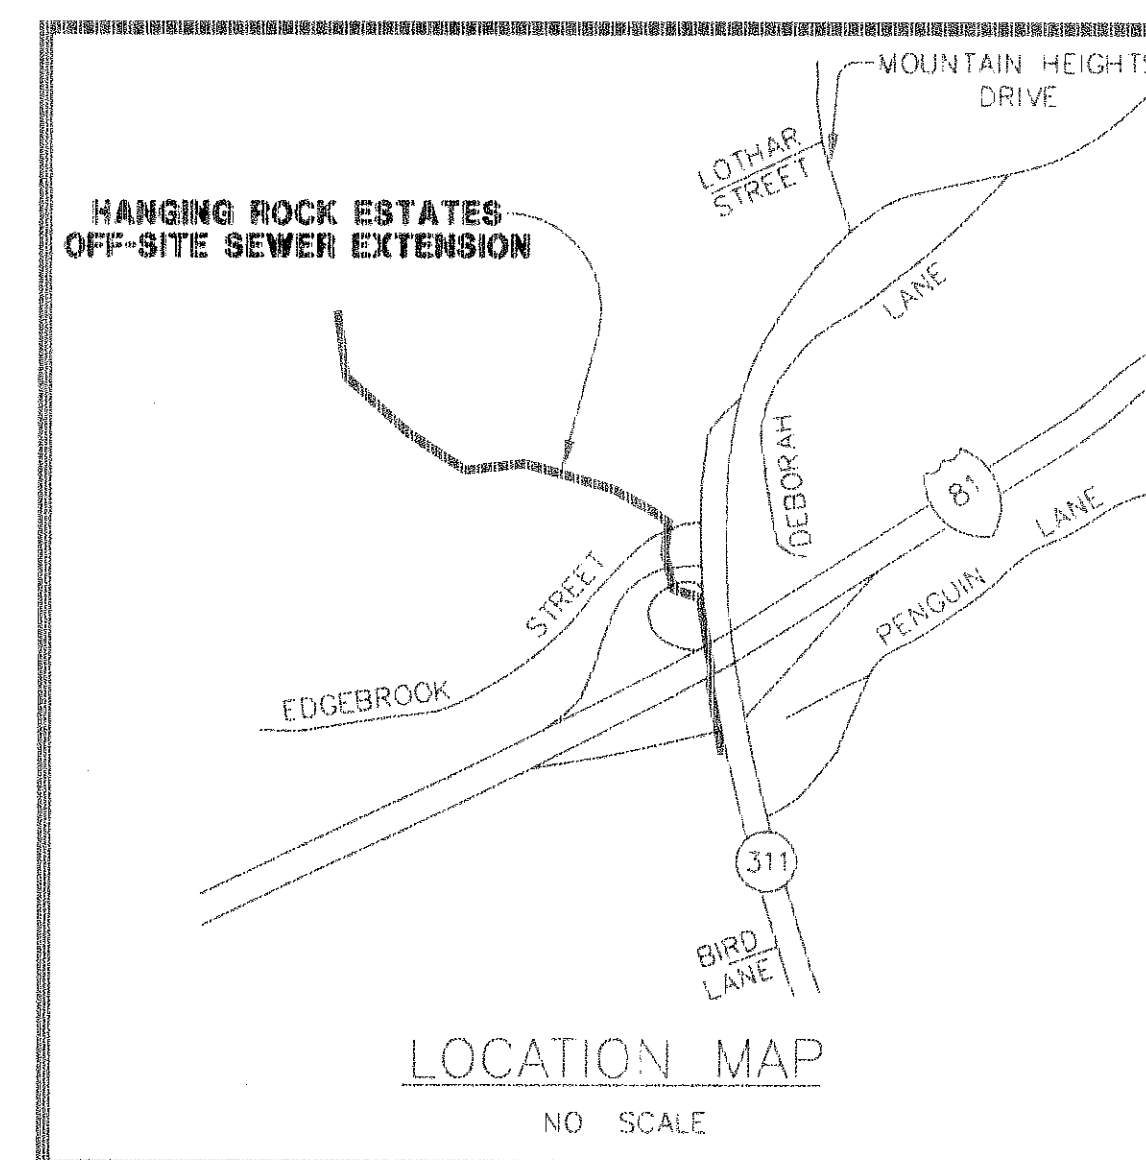

LUMSDEN ASSOCIATES, P.C.
ENGINEERS—SURVEYORS—PLANNERS
ROANOKE, VIRGINIA

4C-35Z

SHEET 1 OF 6