




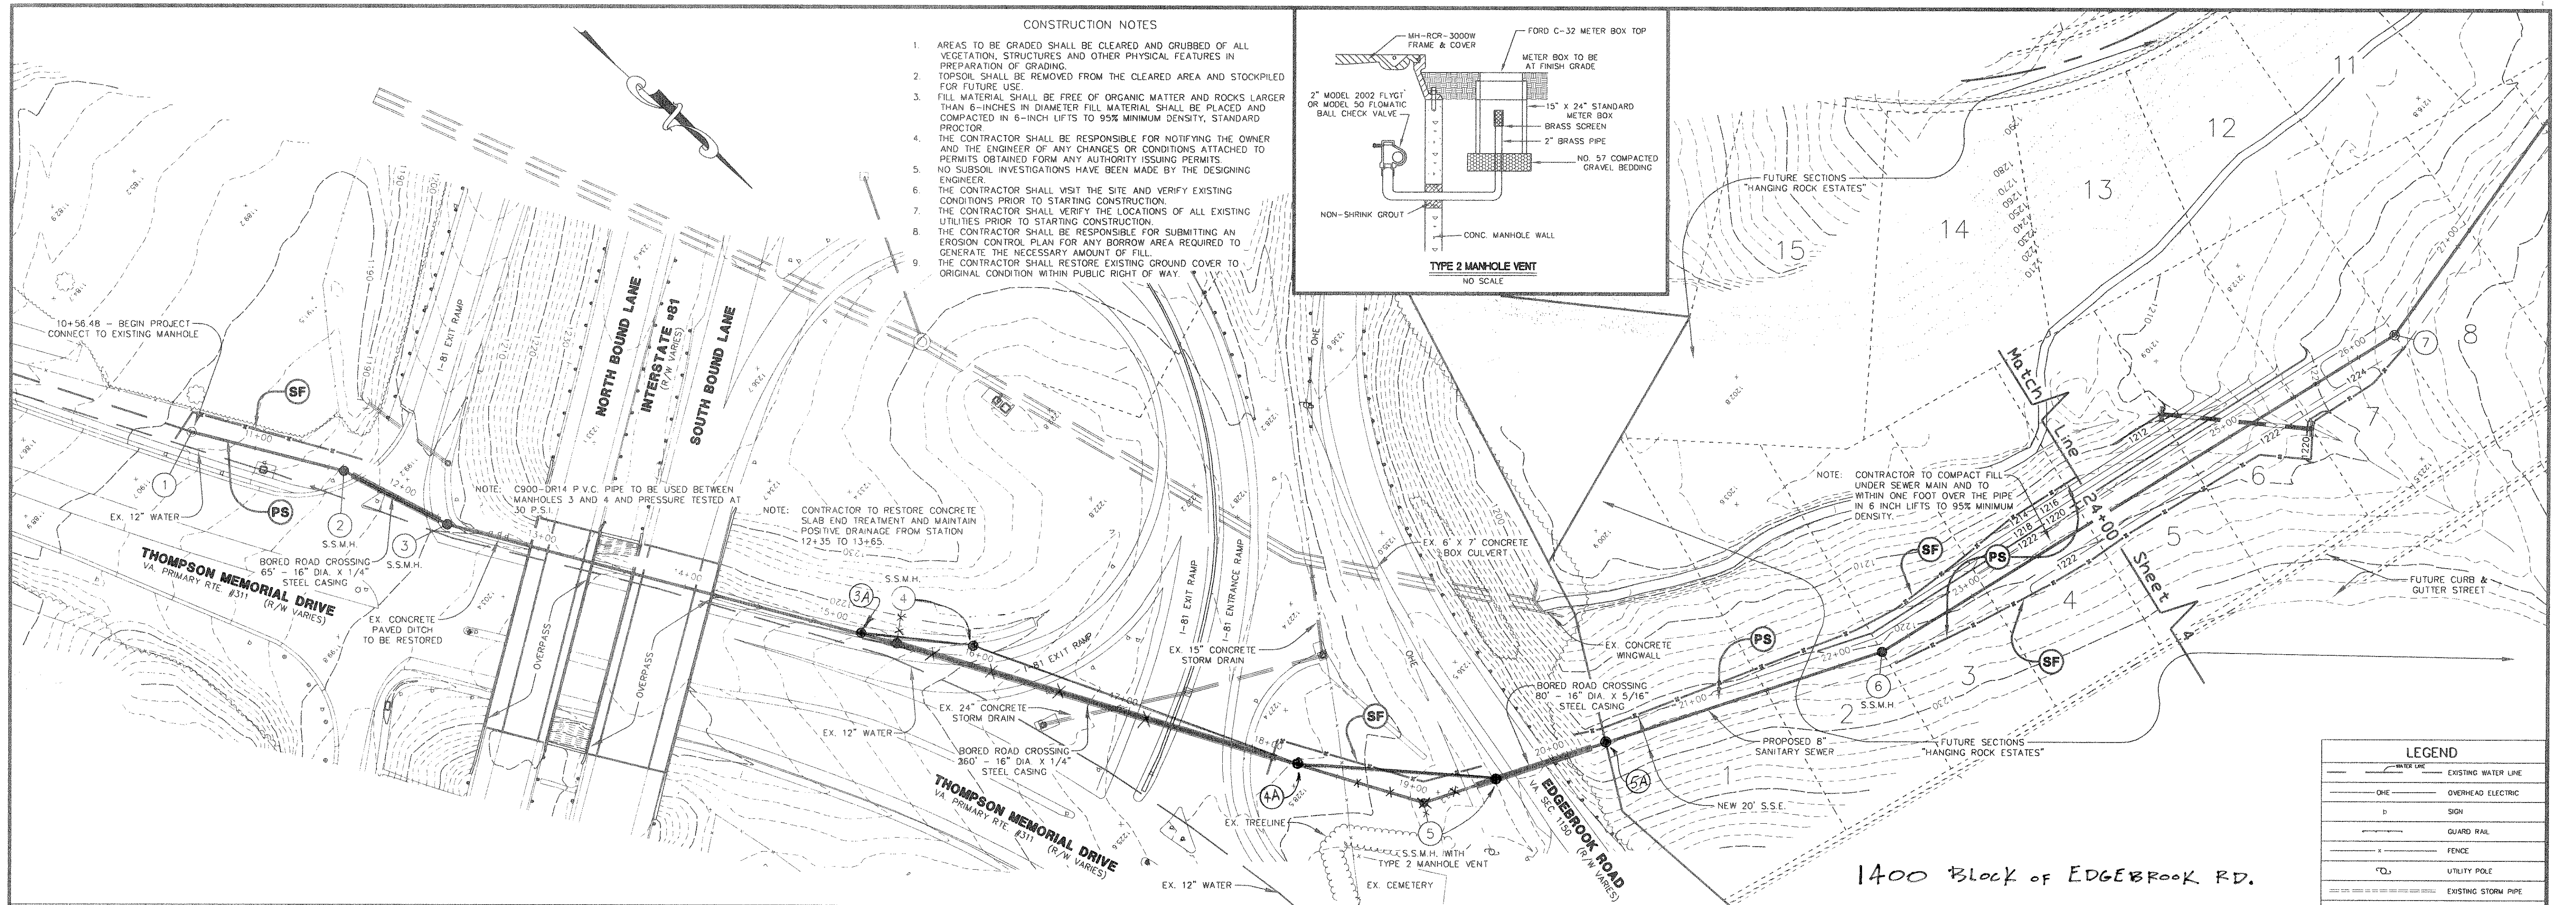

- CONSTRUCTION NOTES
1. AREAS TO BE GRADED SHALL BE CLEARED AND GRUBBED OF ALL VEGETATION, STRUCTURES AND OTHER PHYSICAL FEATURES IN PREPARATION OF GRADING.
 2. TOPSOIL SHALL BE REMOVED FROM THE CLEARED AREA AND STOCKPILED FOR FUTURE USE.
 3. FILL MATERIAL SHALL BE FREE OF ORGANIC MATTER AND ROCKS LARGER THAN 6-INCHES IN DIAMETER. FILL MATERIAL SHALL BE PLACED AND COMPACTED IN 6-INCH LIFTS TO 95% MINIMUM DENSITY, STANDARD PROCTOR.
 4. THE CONTRACTOR SHALL BE RESPONSIBLE FOR NOTIFYING THE OWNER AND THE ENGINEER OF ANY CHANGES OR CONDITIONS ATTACHED TO PERMITS OBTAINED FROM ANY AUTHORITY ISSUING PERMITS.
 5. NO SUBSOL INVESTIGATIONS HAVE BEEN MADE BY THE DESIGNING ENGINEER.
 6. THE CONTRACTOR SHALL VISIT THE SITE AND VERIFY EXISTING CONDITIONS PRIOR TO STARTING CONSTRUCTION.
 7. THE CONTRACTOR SHALL VERIFY THE LOCATIONS OF ALL EXISTING UTILITIES PRIOR TO STARTING CONSTRUCTION.
 8. THE CONTRACTOR SHALL BE RESPONSIBLE FOR SUBMITTING AN EROSION CONTROL PLAN FOR ANY BORROW AREA REQUIRED TO GENERATE THE NECESSARY AMOUNT OF FILL.
 9. THE CONTRACTOR SHALL RESTORE EXISTING GROUND COVER TO ORIGINAL CONDITION WITHIN PUBLIC RIGHT OF WAY.

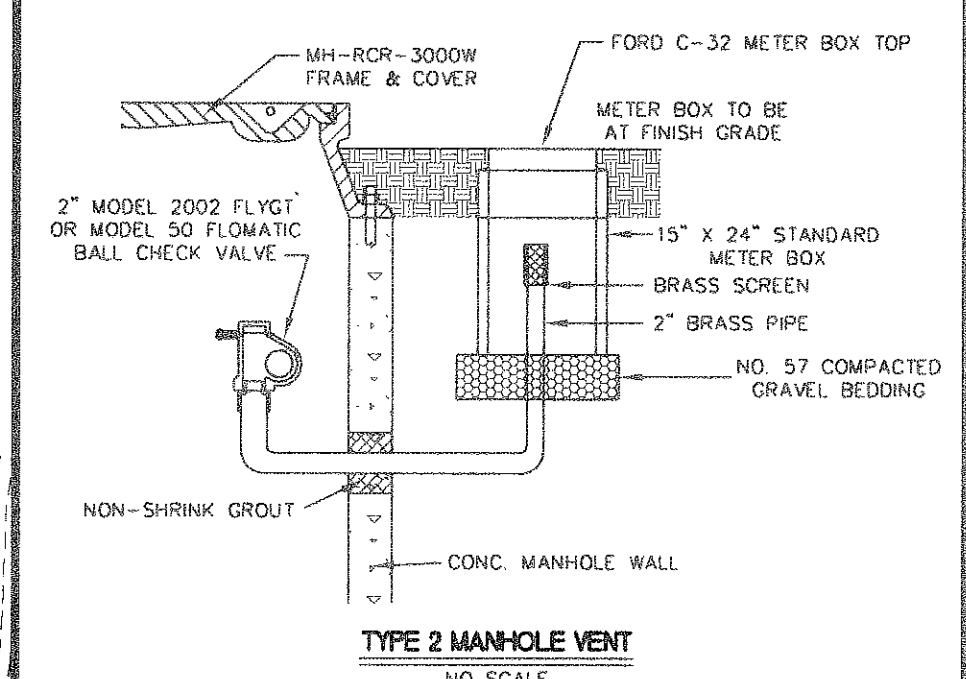

LEGEND	
	EXISTING WATER LINE
	OVERHEAD ELECTRIC
	SIGN
	GUARD RAIL
	FENCE
	UTILITY POLE
	EXISTING STORM PIPE
	PROPOSED STORM PIPE
	EXISTING DROP INLET
	PROPOSED DROP INLET
	EXISTING STORM DRAIN MANHOLE
	PROPOSED STORM DRAIN MANHOLE
	PROPOSED 8\" SANITARY SEWER
	EXISTING SANITARY SEWER MANHOLE
	PROPOSED SANITARY SEWER MANHOLE
	EXISTING CONTOUR
	PROPOSED CONTOUR
	TREE LINE
	SPOT ELEVATION

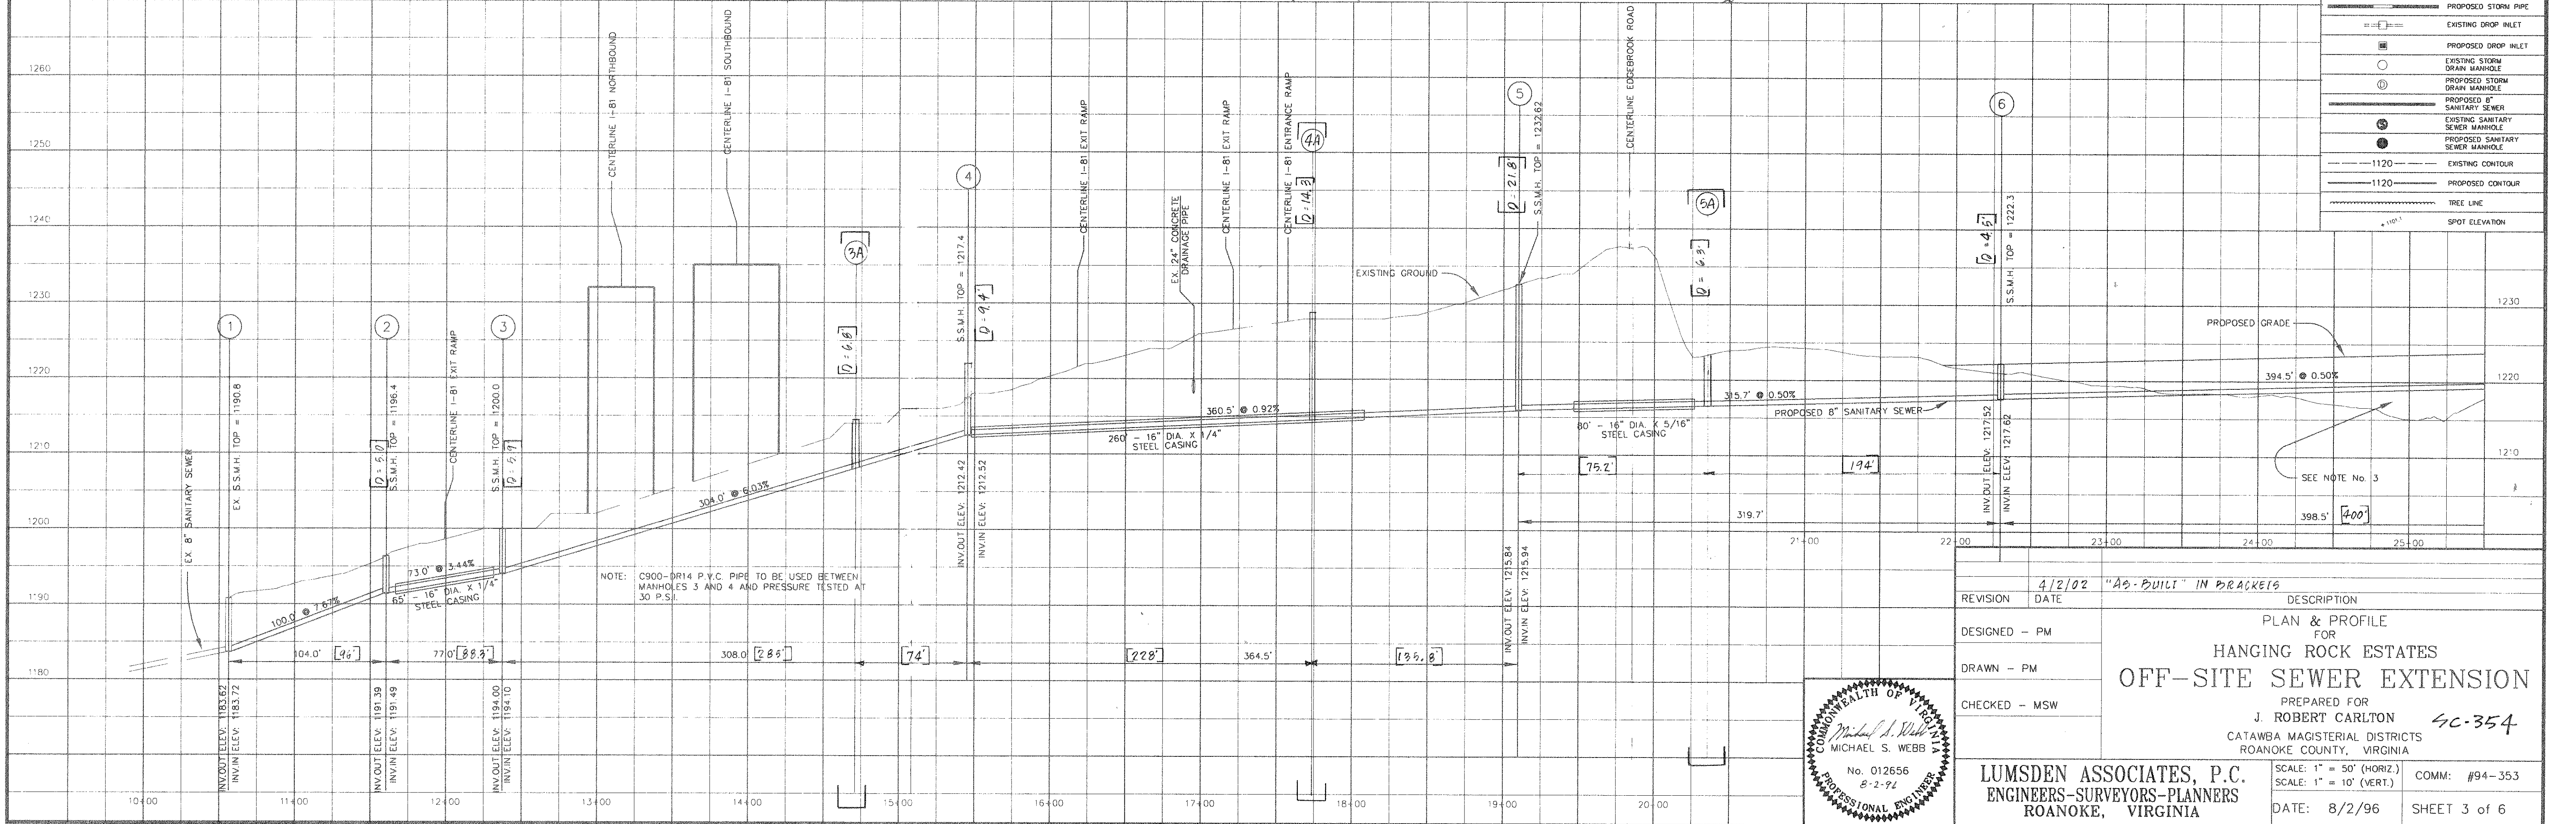

REVISION	4/2/02	"AS-BUILT" IN BRACKETS	DESCRIPTION
DESIGNED	PM		PLAN & PROFILE FOR
DRAWN	PM		HANGING ROCK ESTATES
CHECKED	MSW		OFF-SITE SEWER EXTENSION
PREPARED FOR J. ROBERT CARLTON			
CATAMBA MAGISTERIAL DISTRICTS ROANOKE COUNTY, VIRGINIA			
LUMSDEN ASSOCIATES, P.C. ENGINEERS-SURVEYORS-PLANNERS ROANOKE, VIRGINIA			
SCALE: 1" = 50' (HORIZ.) SCALE: 1" = 10' (VERT.)			
DATE: 8/2/96			
SHEET 3 of 6			

