




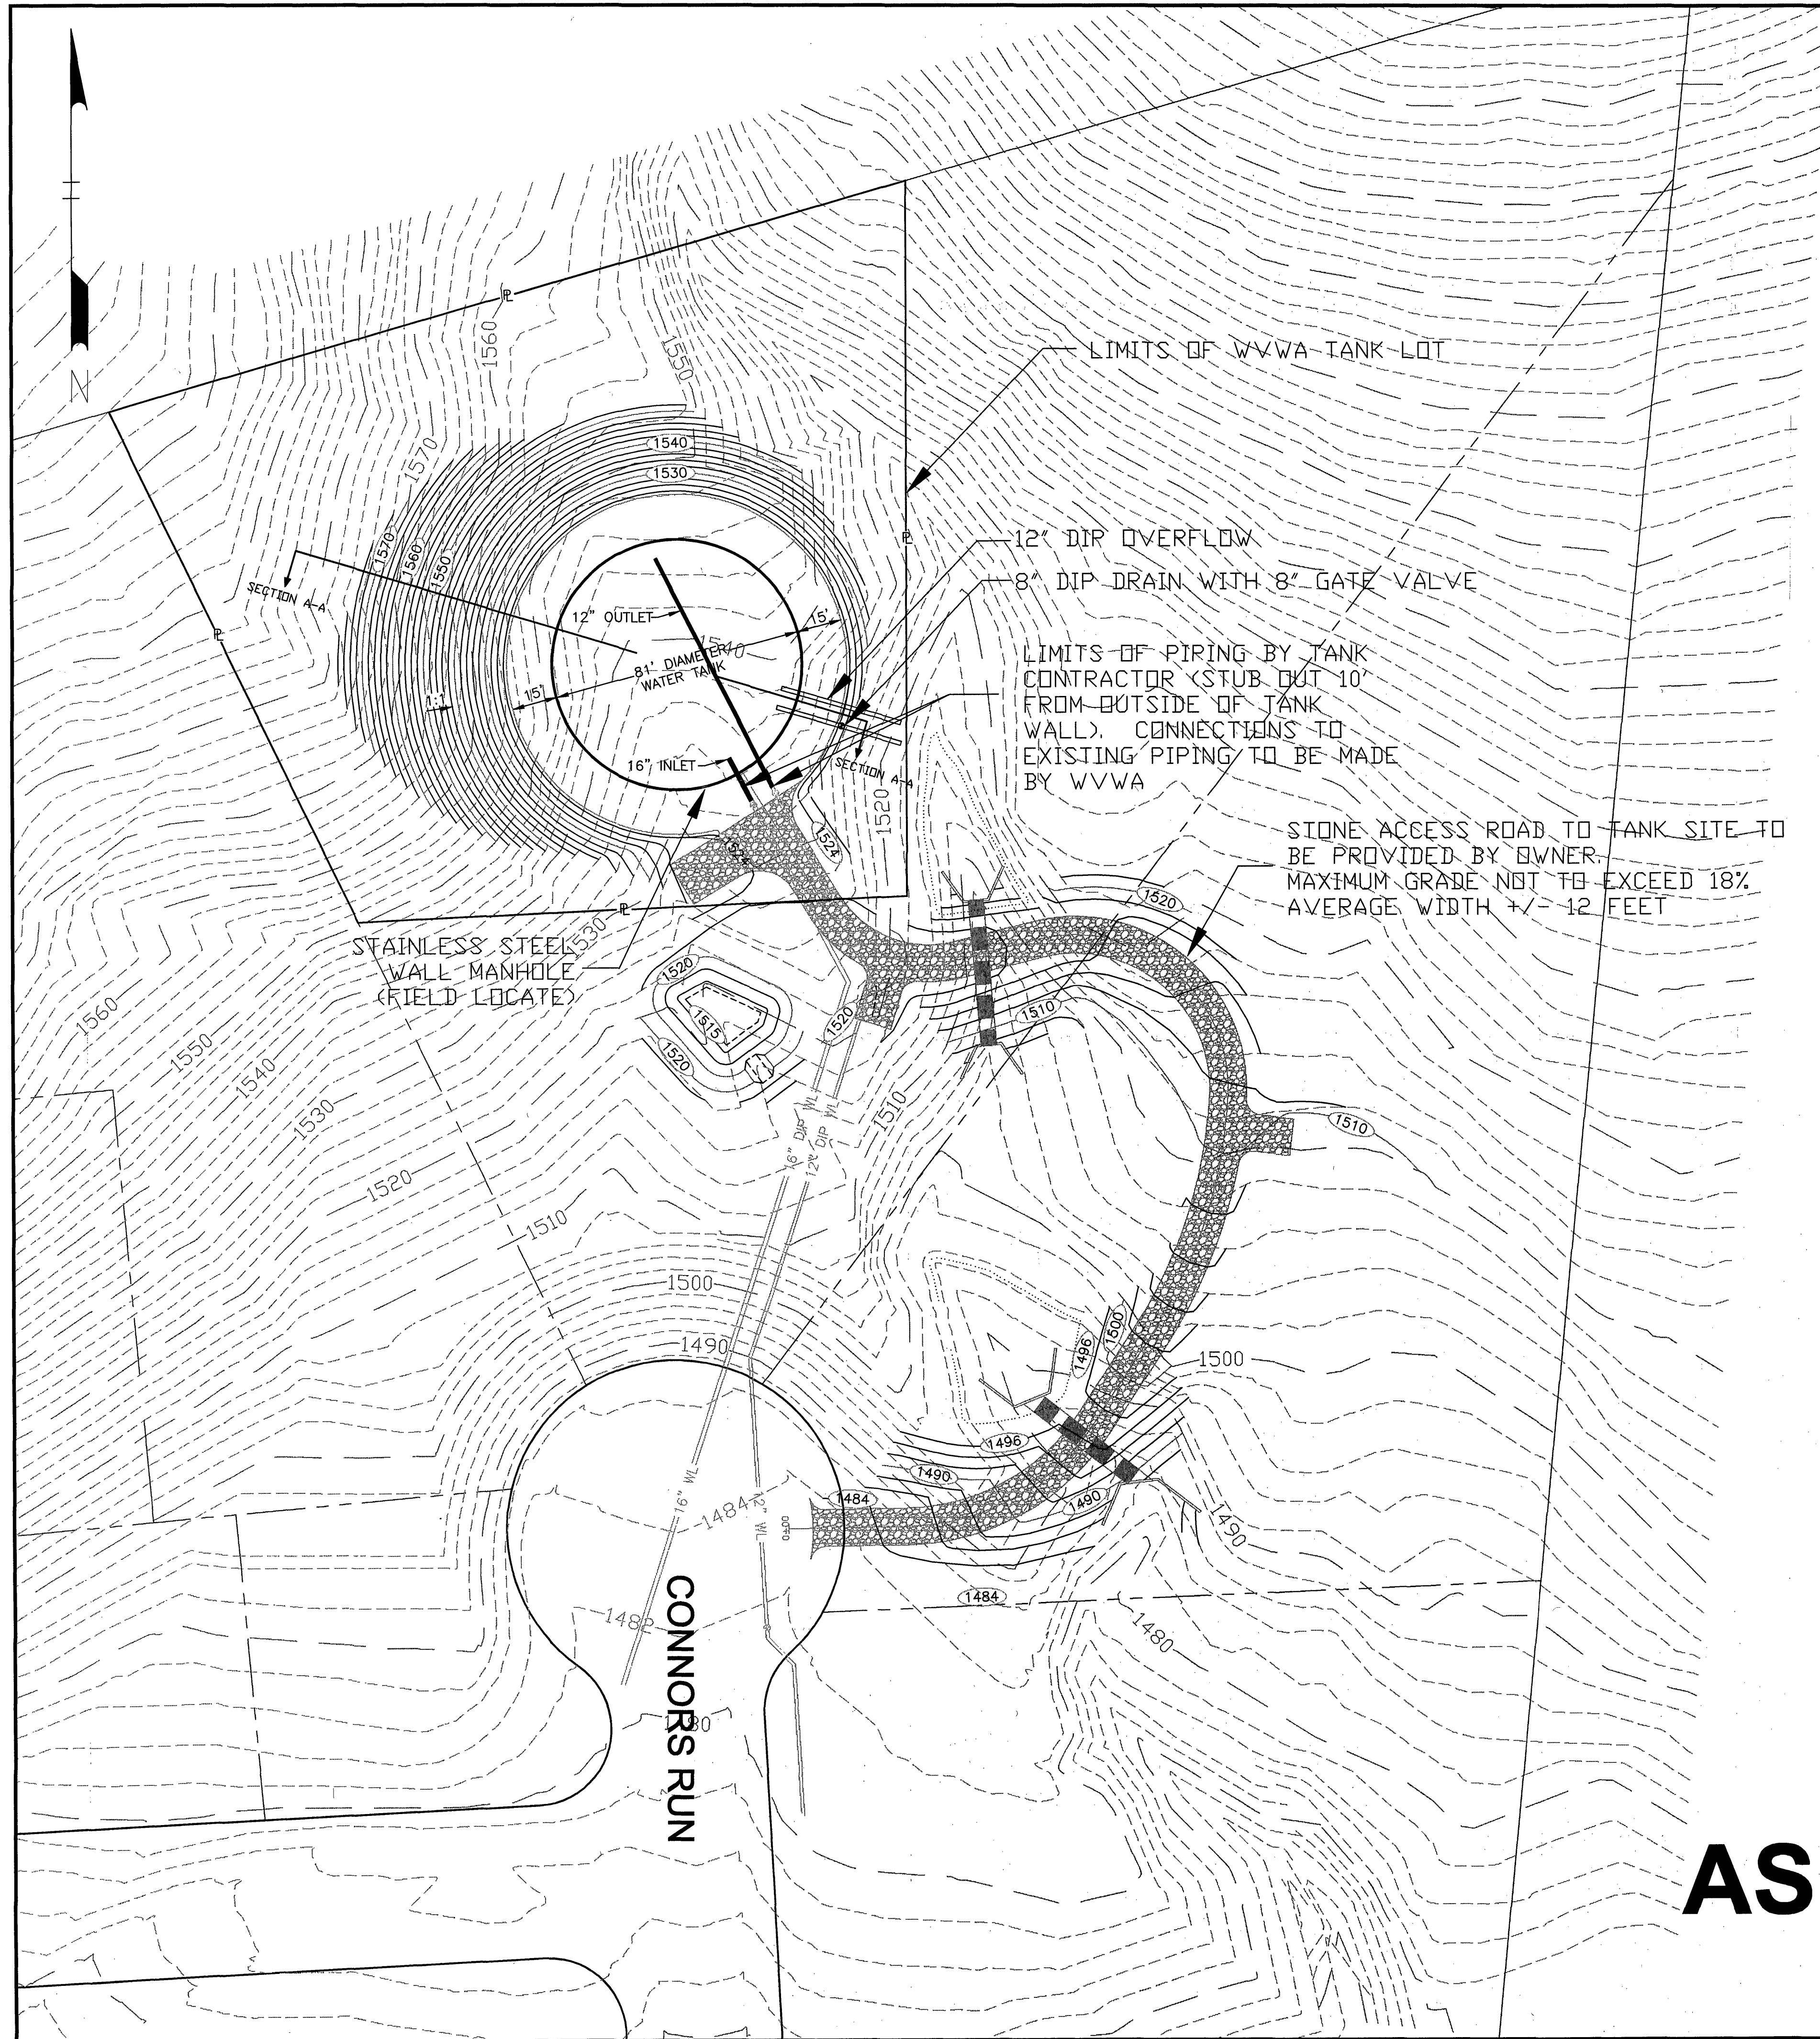


AS-BUILT
06-19-09

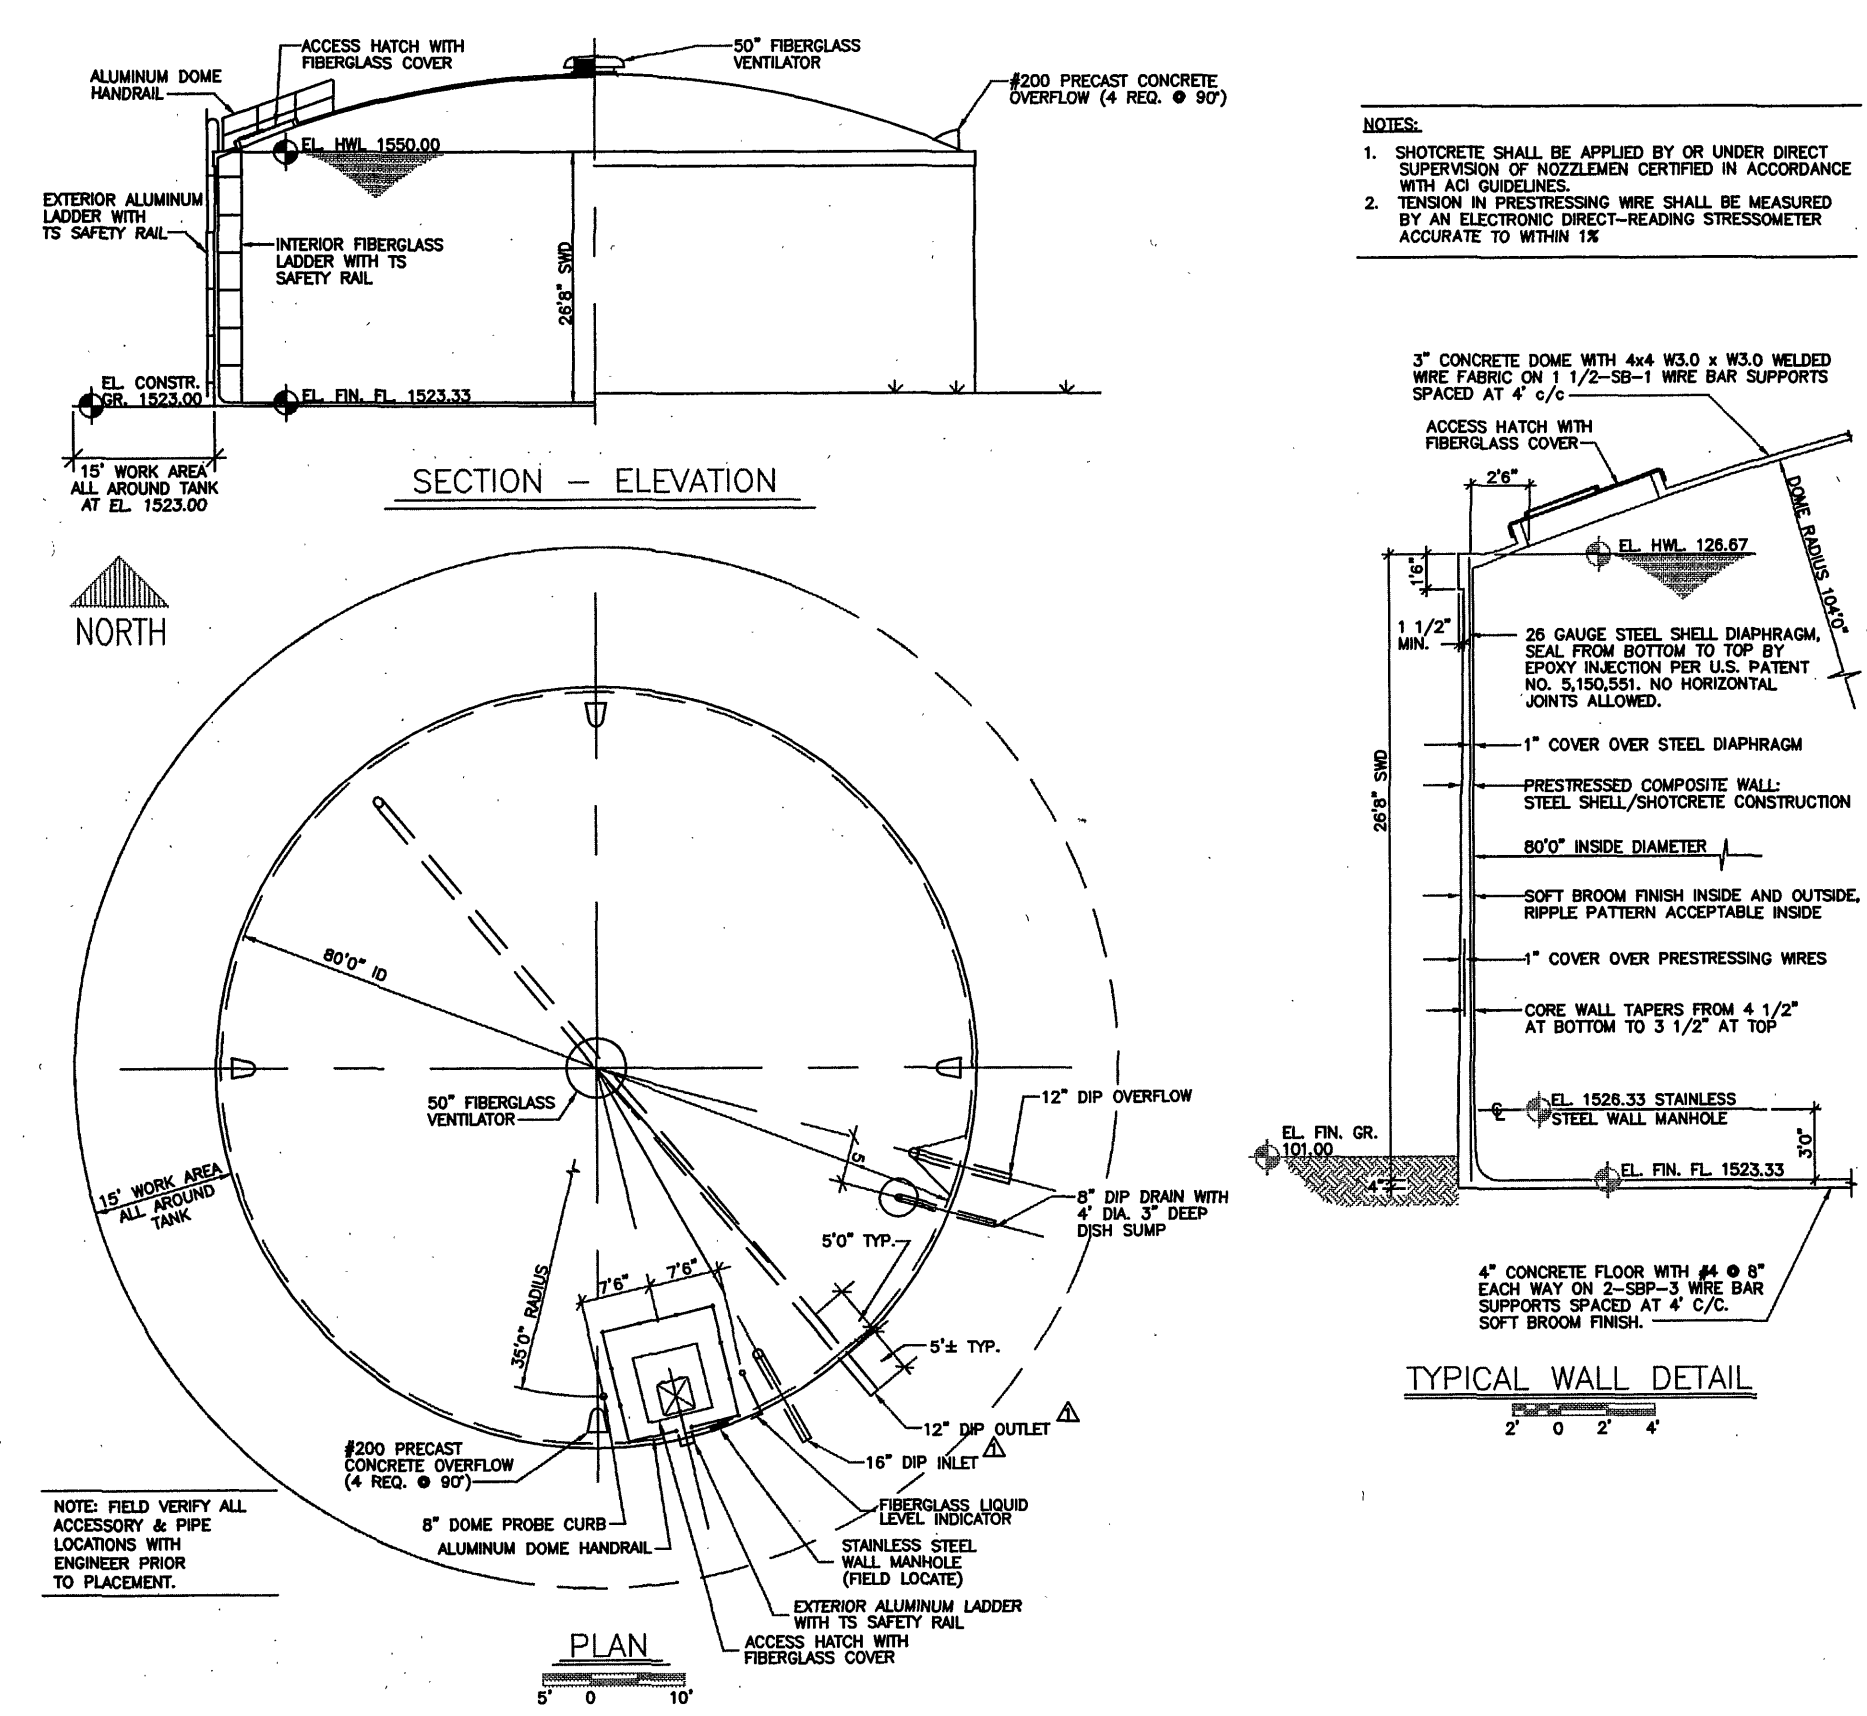


Revisions made 10/27/08

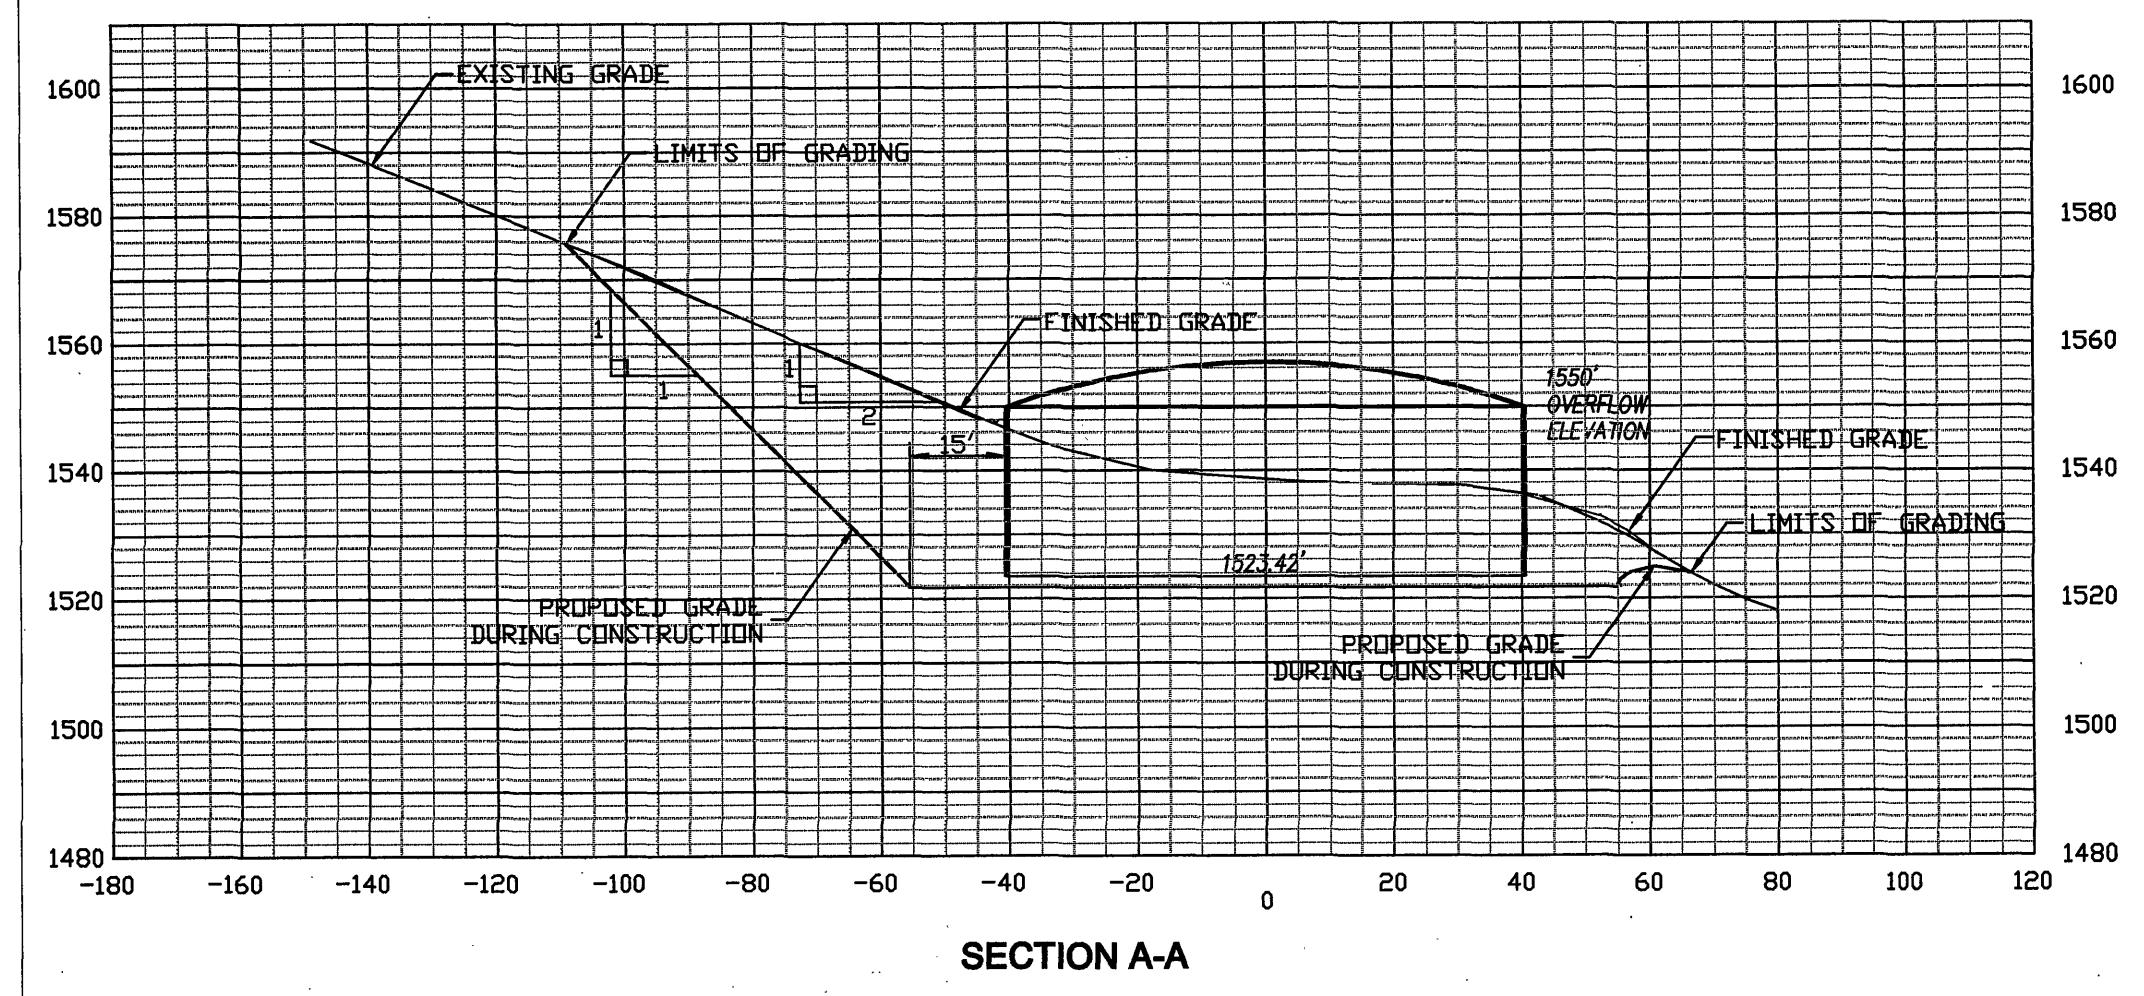

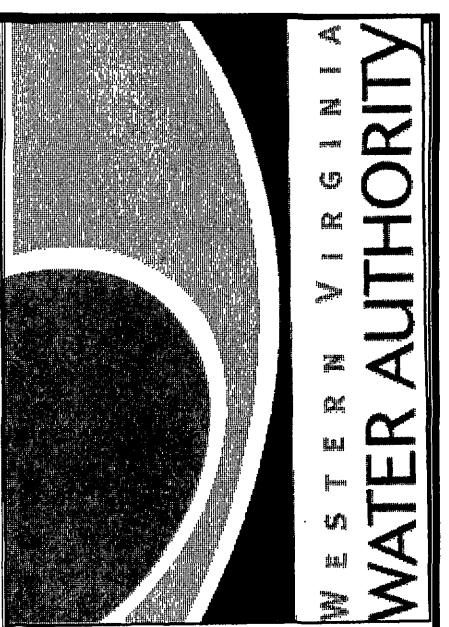

ENGINEERING SERVICES
2012 SOUTH JEFFERSON STREET
ROANOKE, VIRGINIA 24014
PHONE: (540) 853-5641

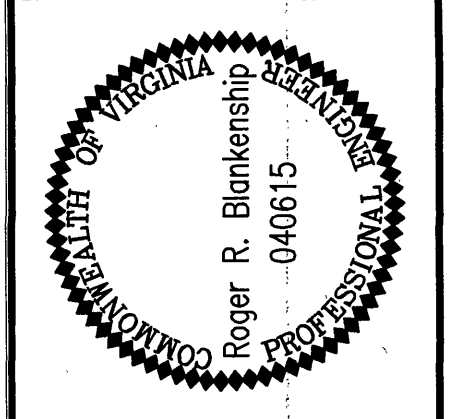

**HANGING ROCK TERRACE
1 MILLION GALLON
WATER STORAGE TANK**

Designed By:	RRB
Drawn By:	RRB
Checked By:	RWB
Date:	11/08/06
Scale:	1" = 30'
Plan #:	00-00
Sheet:	2 OF 4