

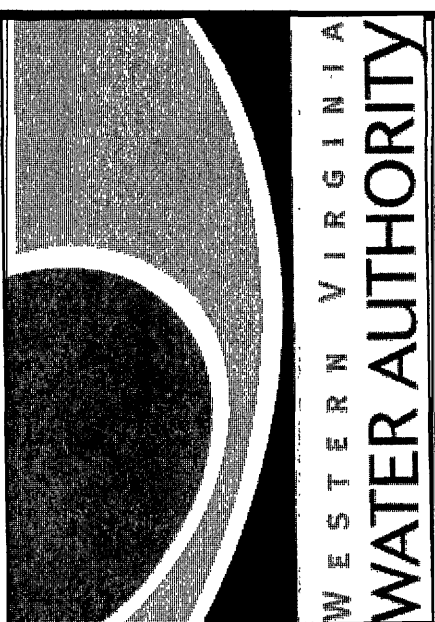


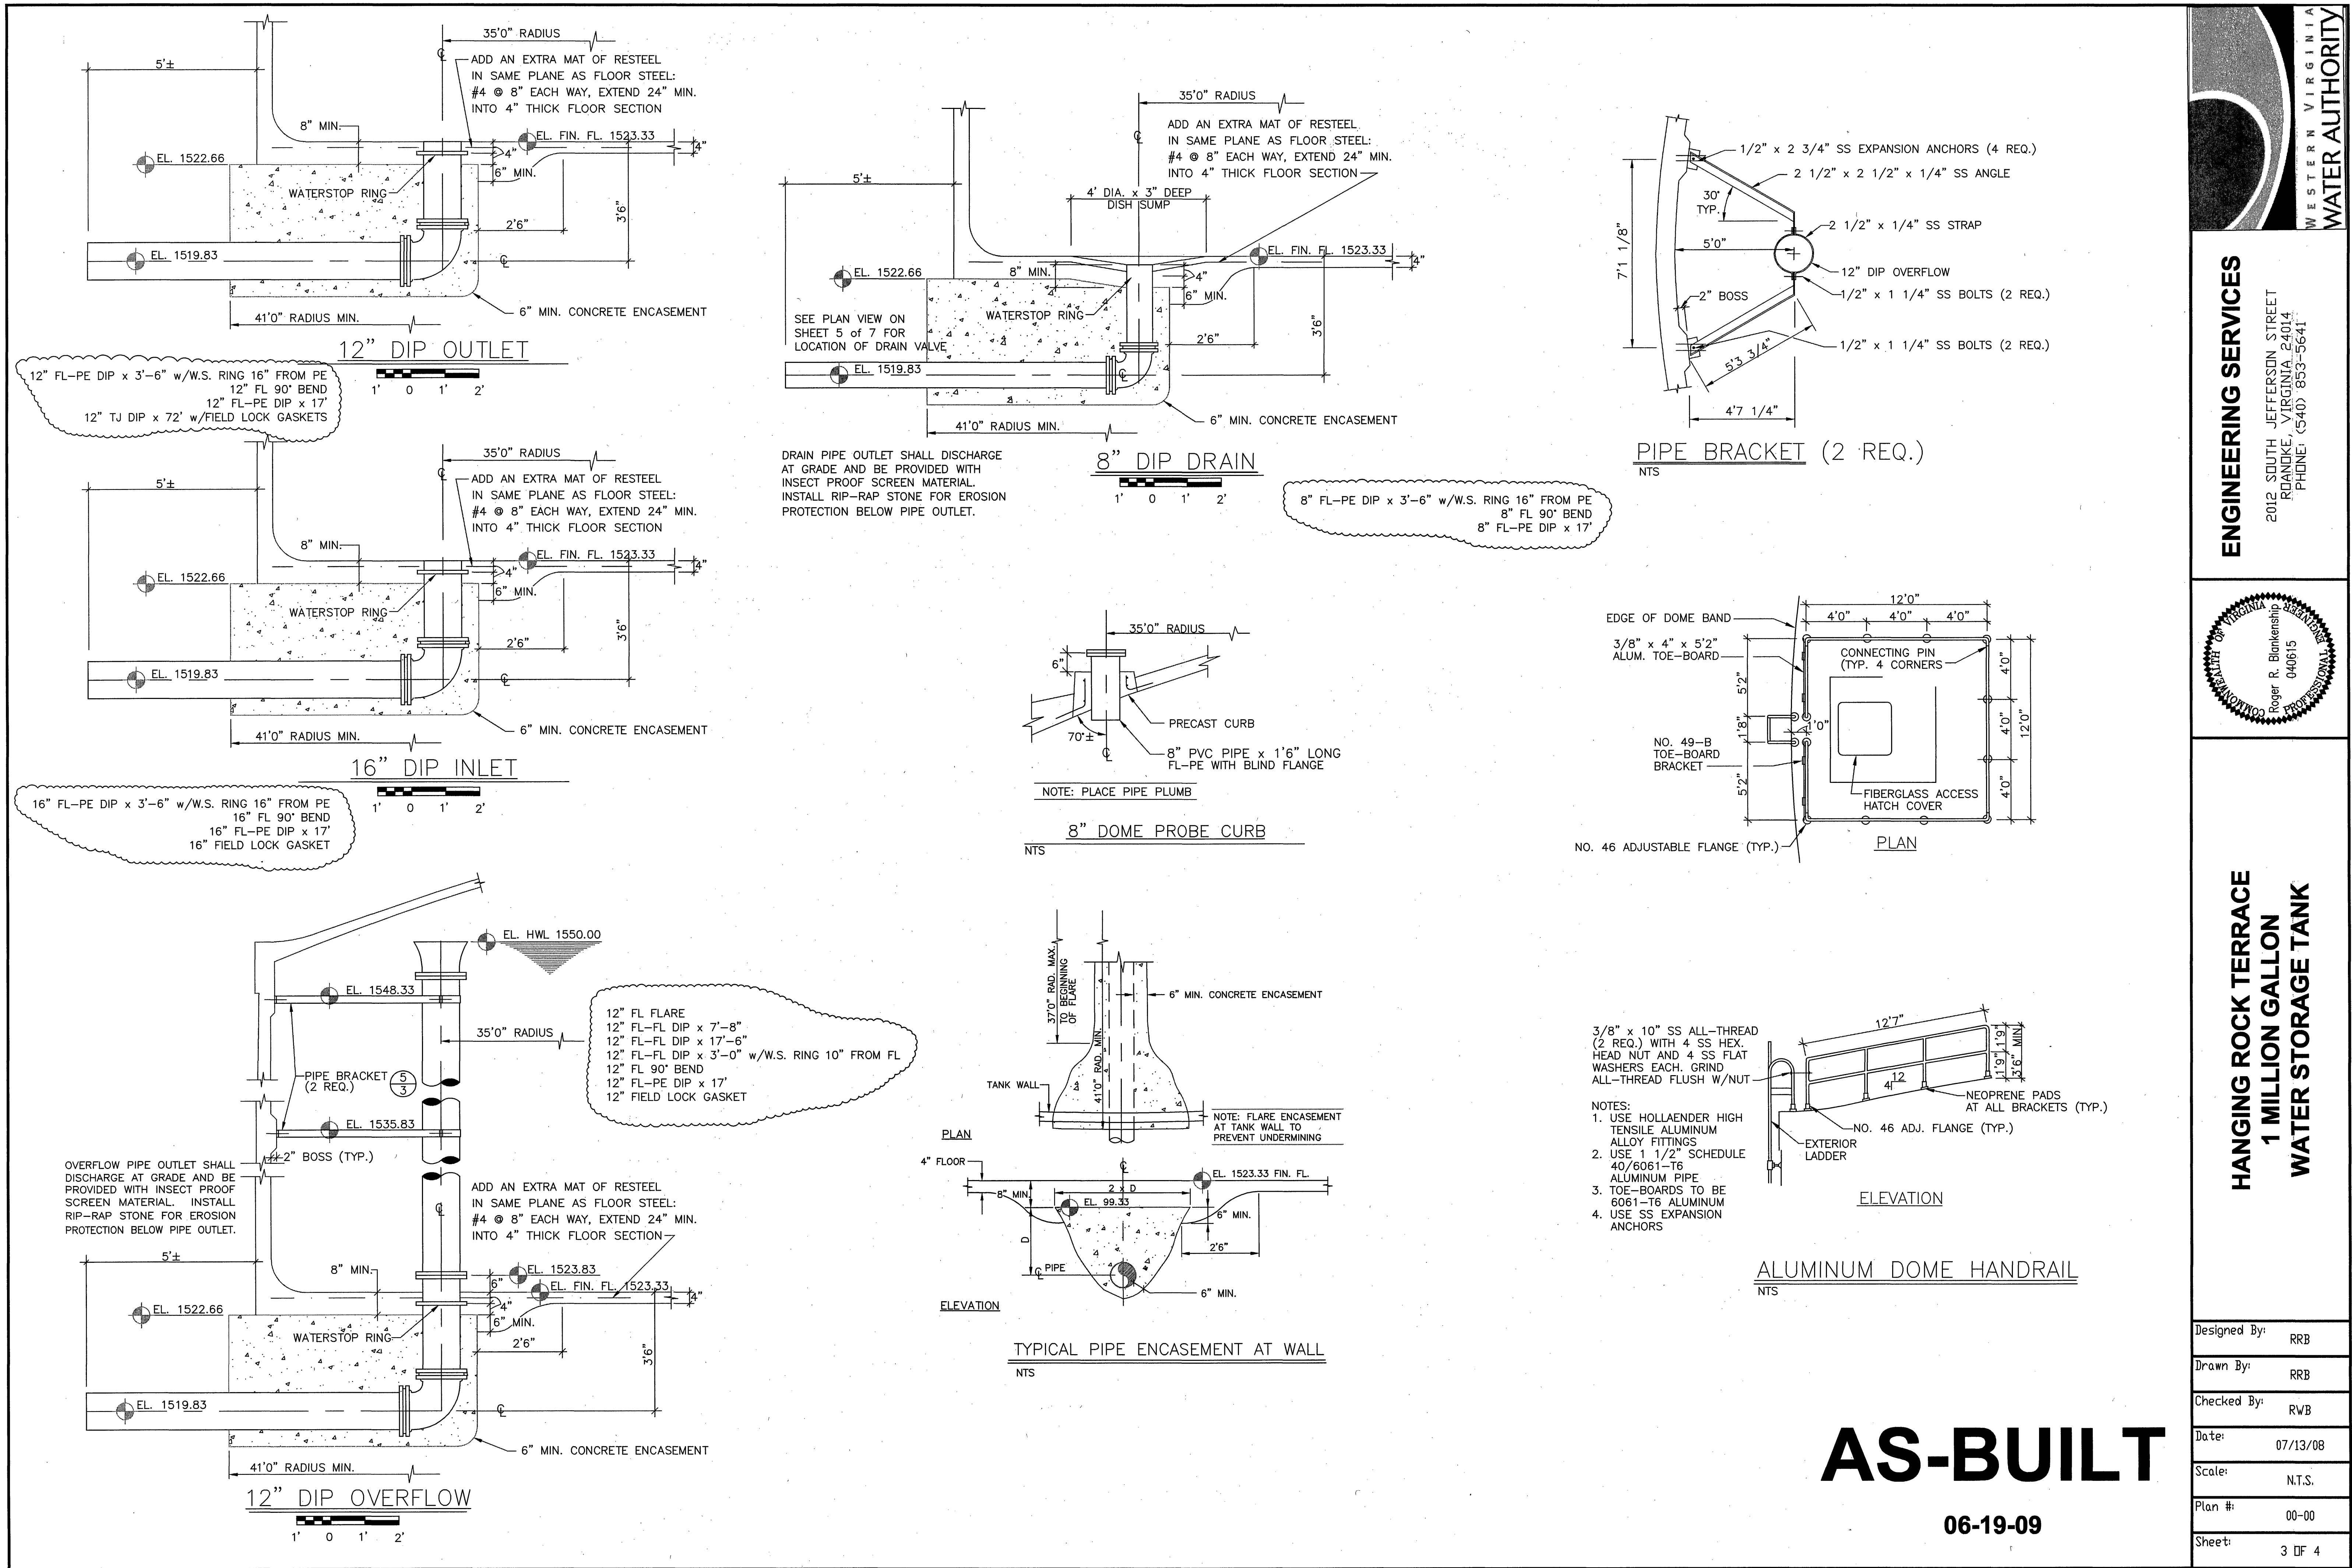

ENGINEERING SERVICES

2012 SOUTH JEFFERSON STREET
ROANOK, VIRGINIA 24014
PHONE: (540) 853-5641

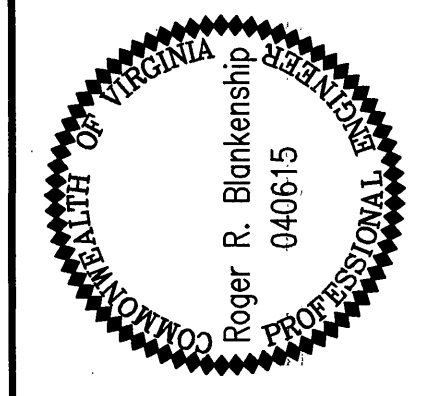

HANGING ROCK TERRACE
1 MILLION GALLON
WATER STORAGE TANK

Designed By:	RRB
Drawn By:	RRB
Checked By:	RWB
Date:	07/13/08
Scale:	N.T.S.
Plan #:	00-00
Sheet:	3 OF 4

AS-BUILT

06-19-09