



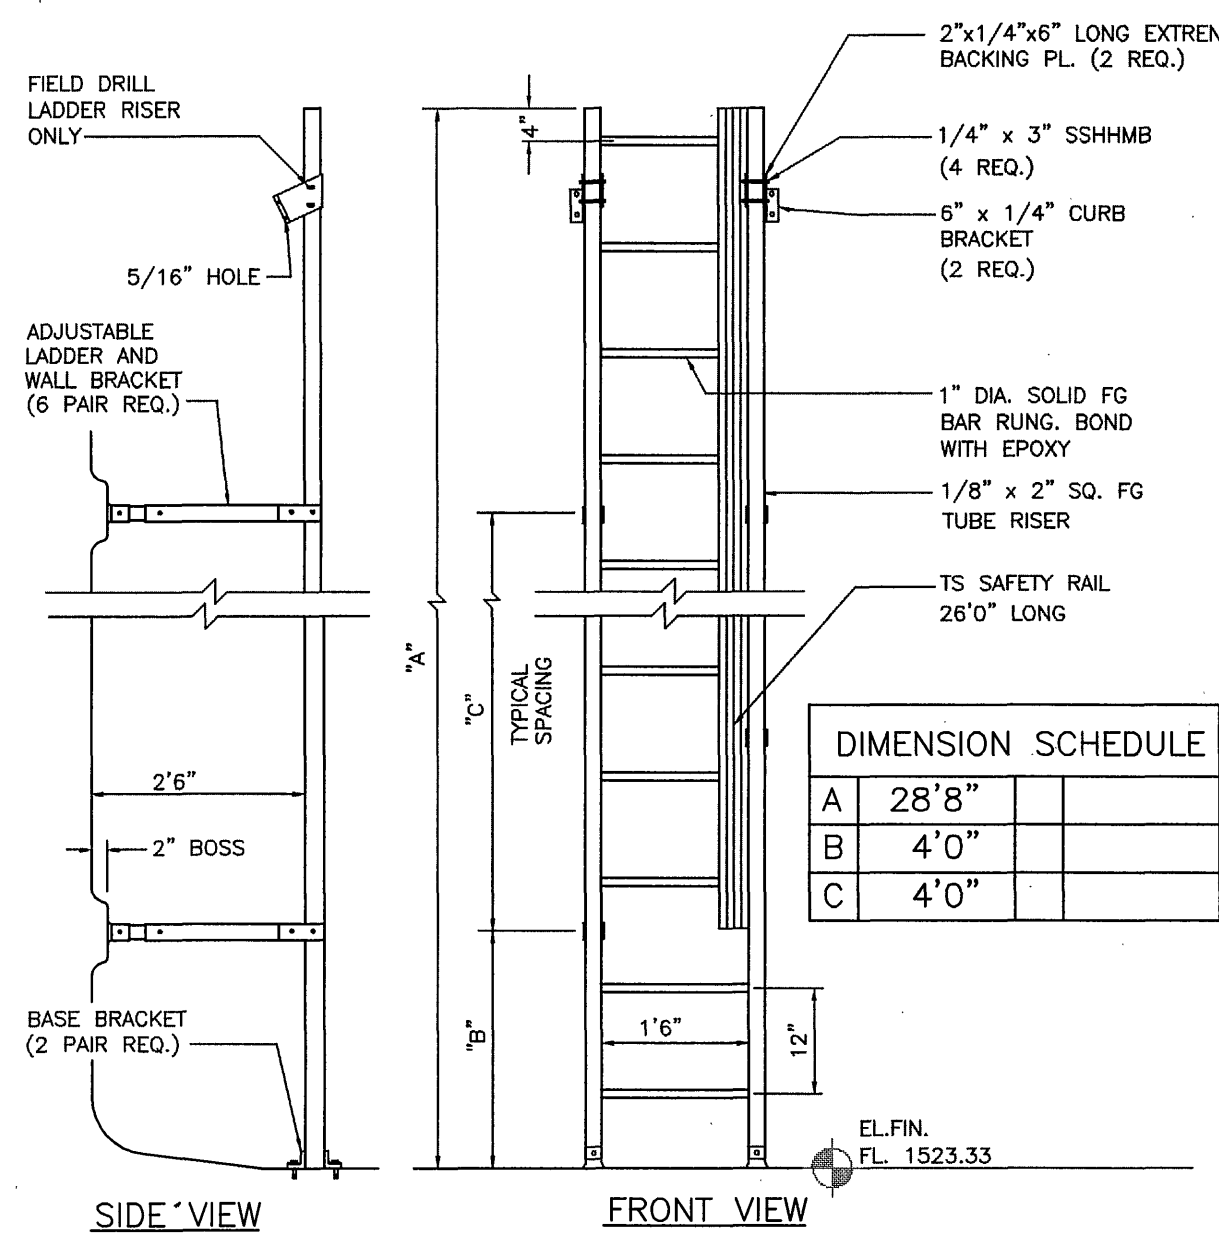


NOTE: 1/4" X 2" FLAT BAR FIBERGLASS CROSS-BRACE TO BE PROVIDED FOR BRACING WALL BRACKET SUPPORTS ON LADDERS OVER 20'0" TALL. INSTALL ON EVERY OTHER BRACKET.

INTERIOR FIBERGLASS LADDER WITH TS SAFETY RAIL

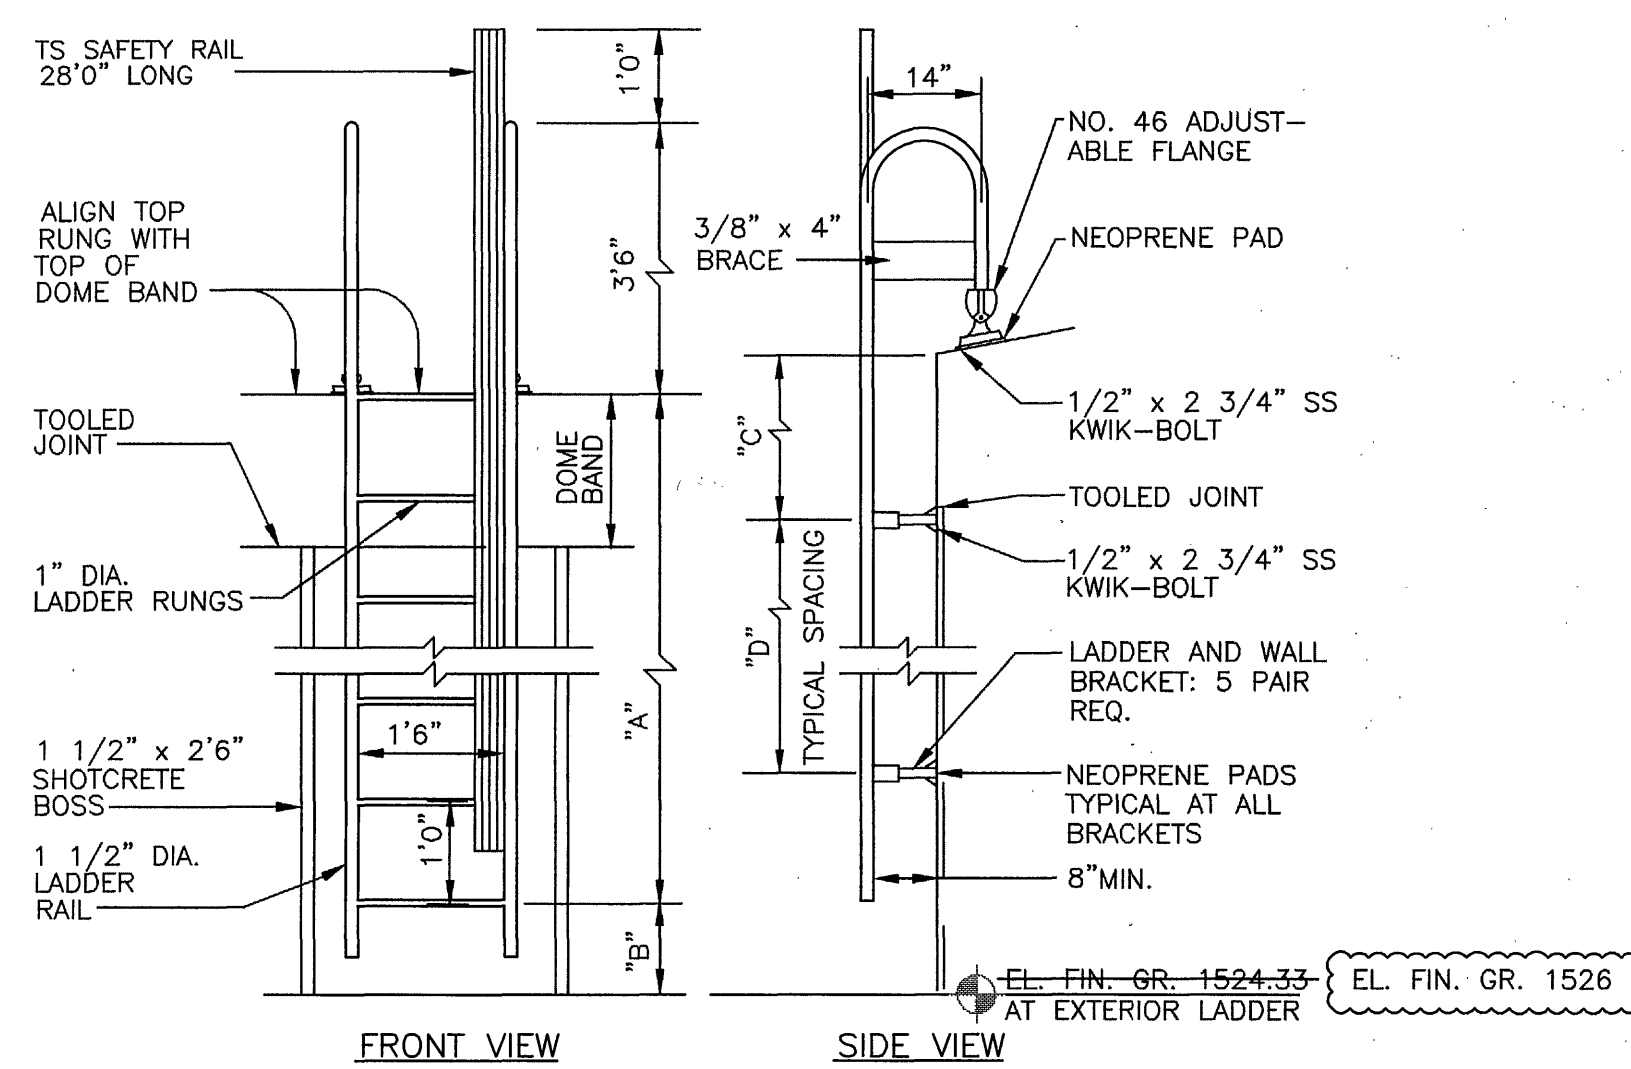


NOTES: 1. ALL TUBULAR MATERIAL TO BE NOMINAL DIAMETER SCHEDULE 40 ALUMINUM PIPE 6061-T6.
2. PLATES AND GUSSETS TO BE STRUCTURAL GRADE ALUMINUM 6061-T6.


EXTERIOR ALUMINUM LADDER WITH TS SAFETY RAIL

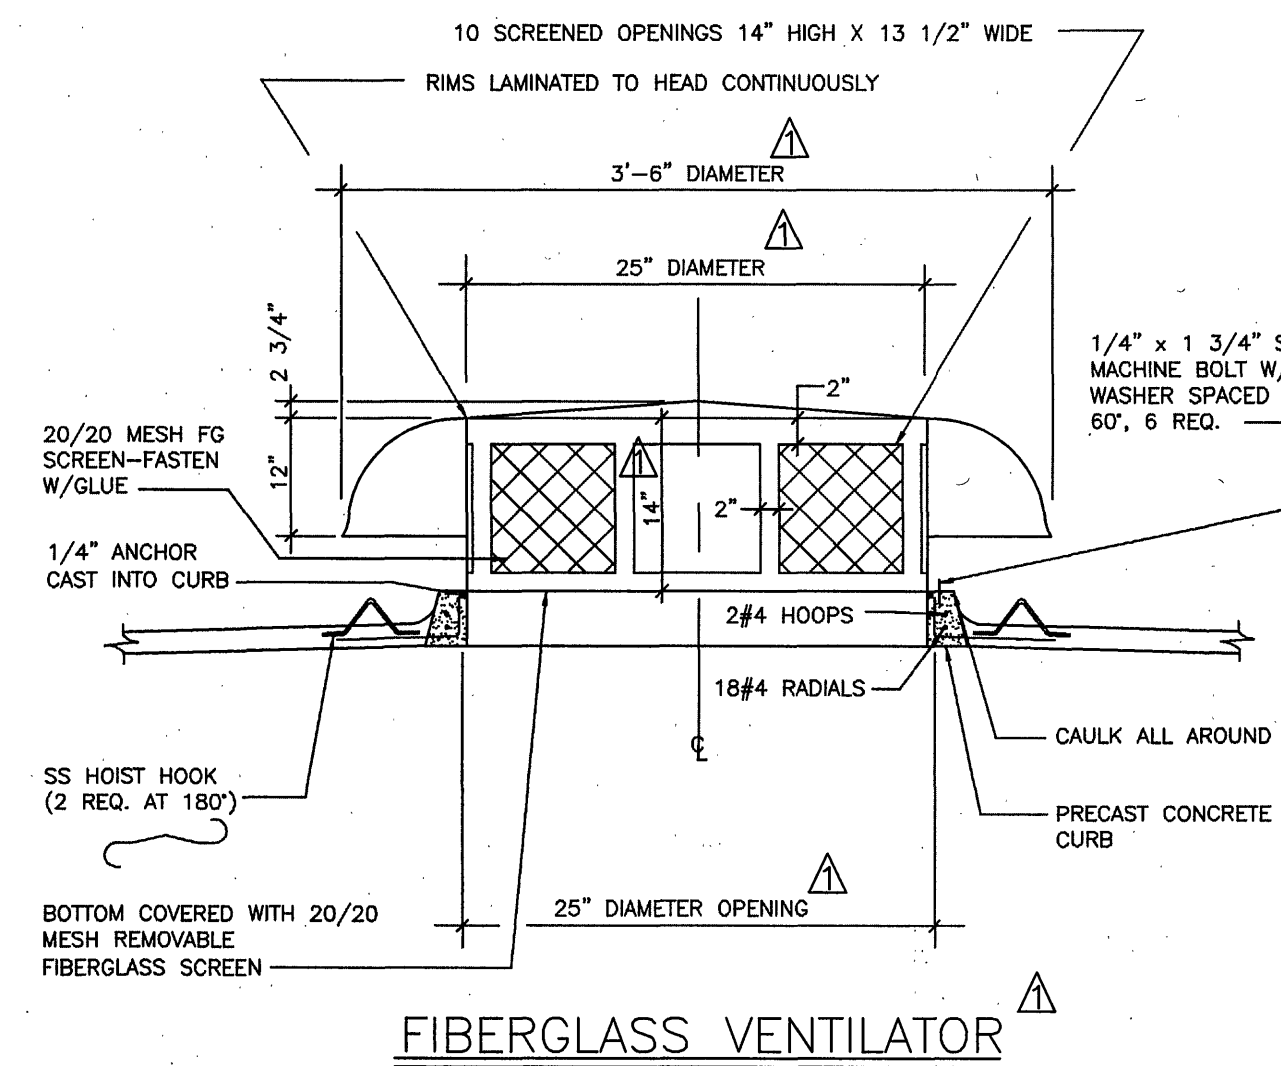


FIBERGLASS VENTILATOR

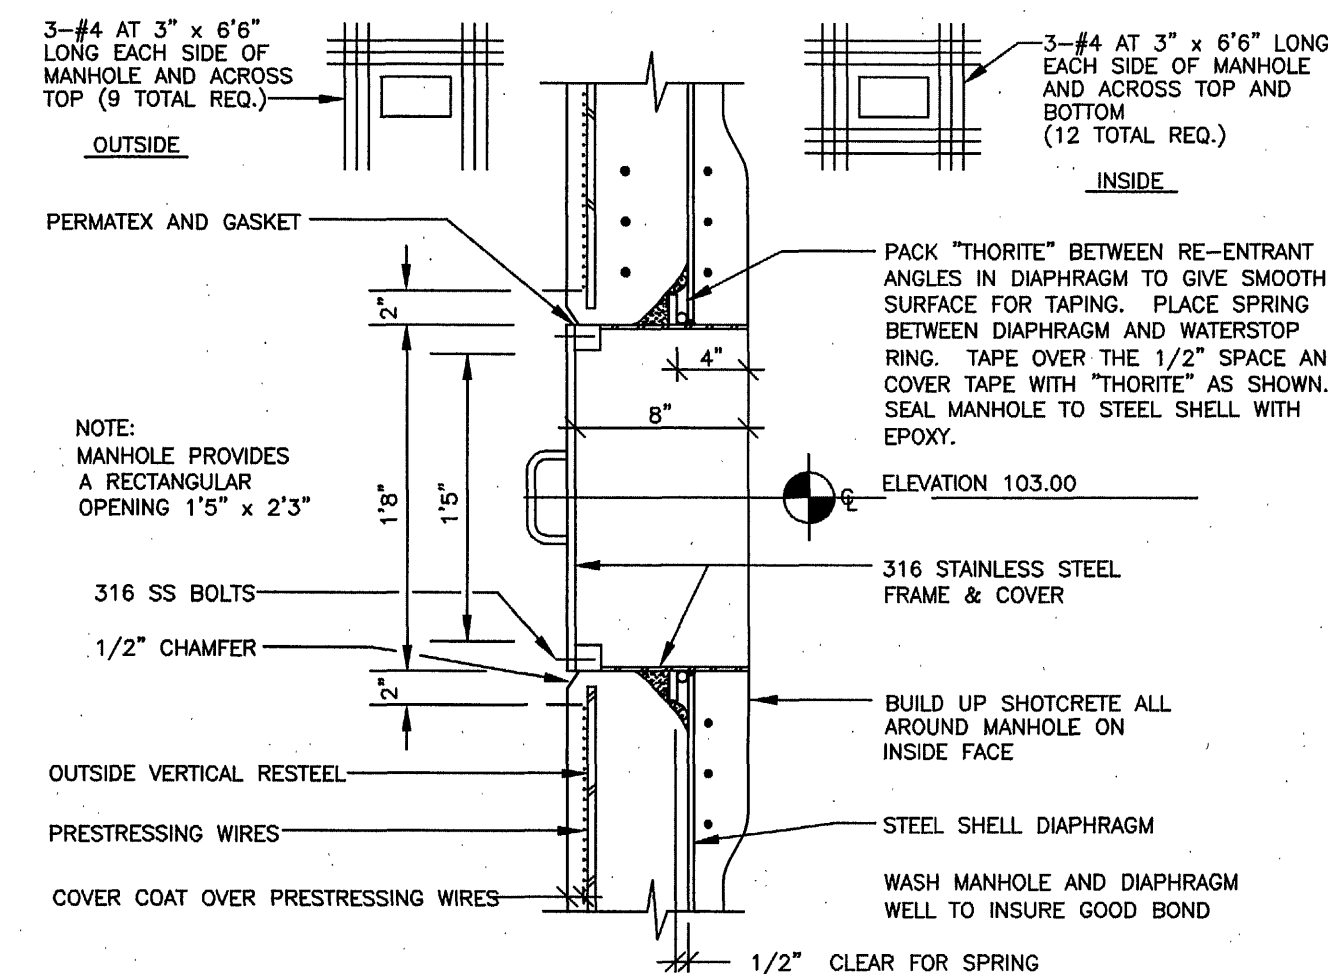


STAINLESS STEEL WALL MANHOLE

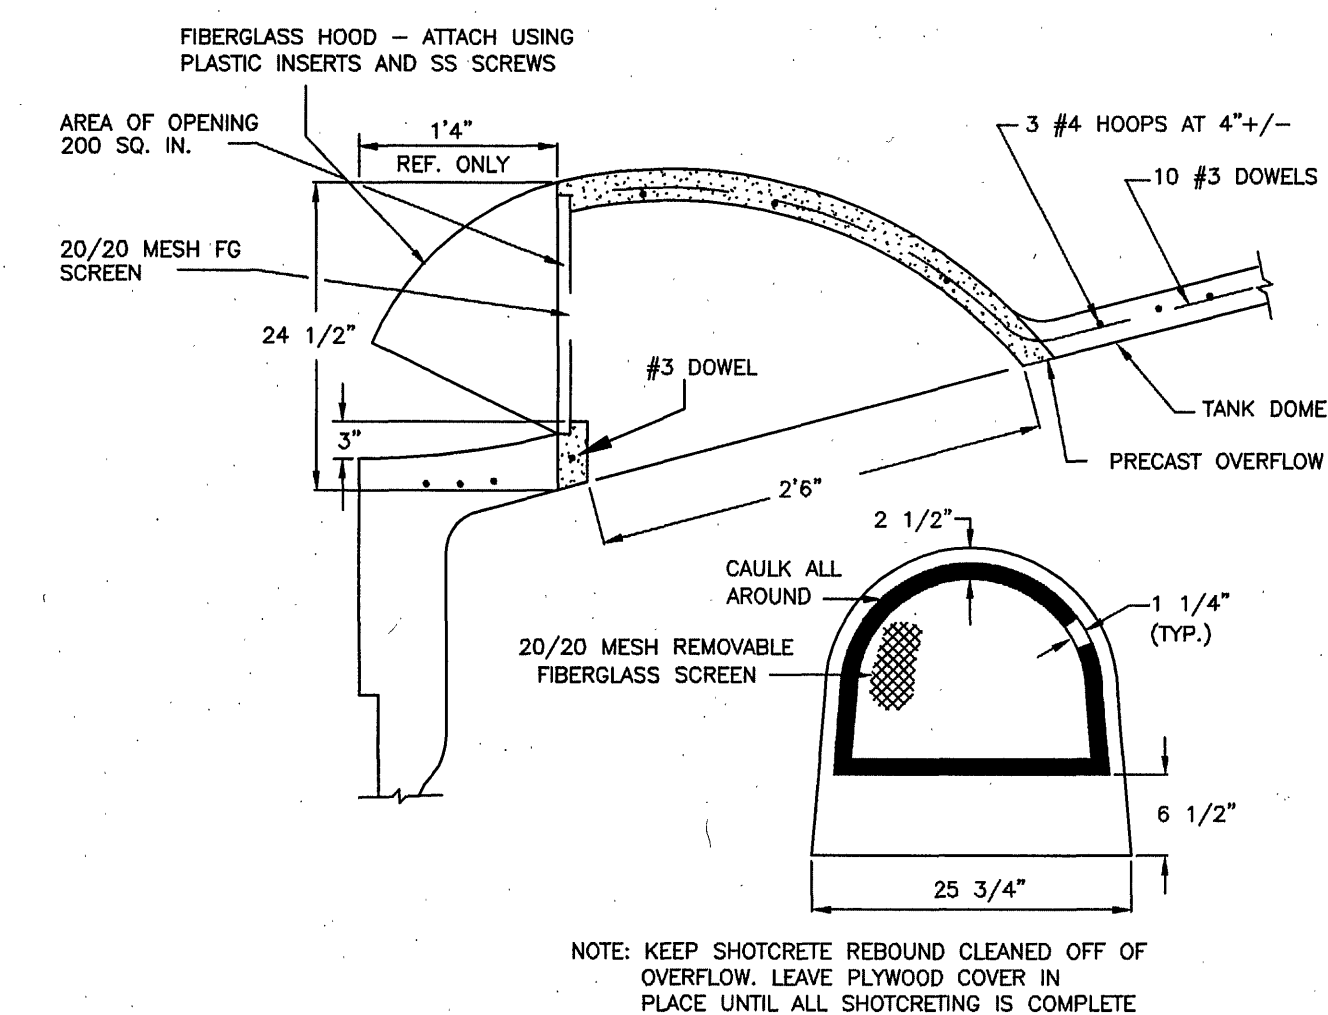

#200 PRECAST CONCRETE OVERFLOW (4 REQ.)

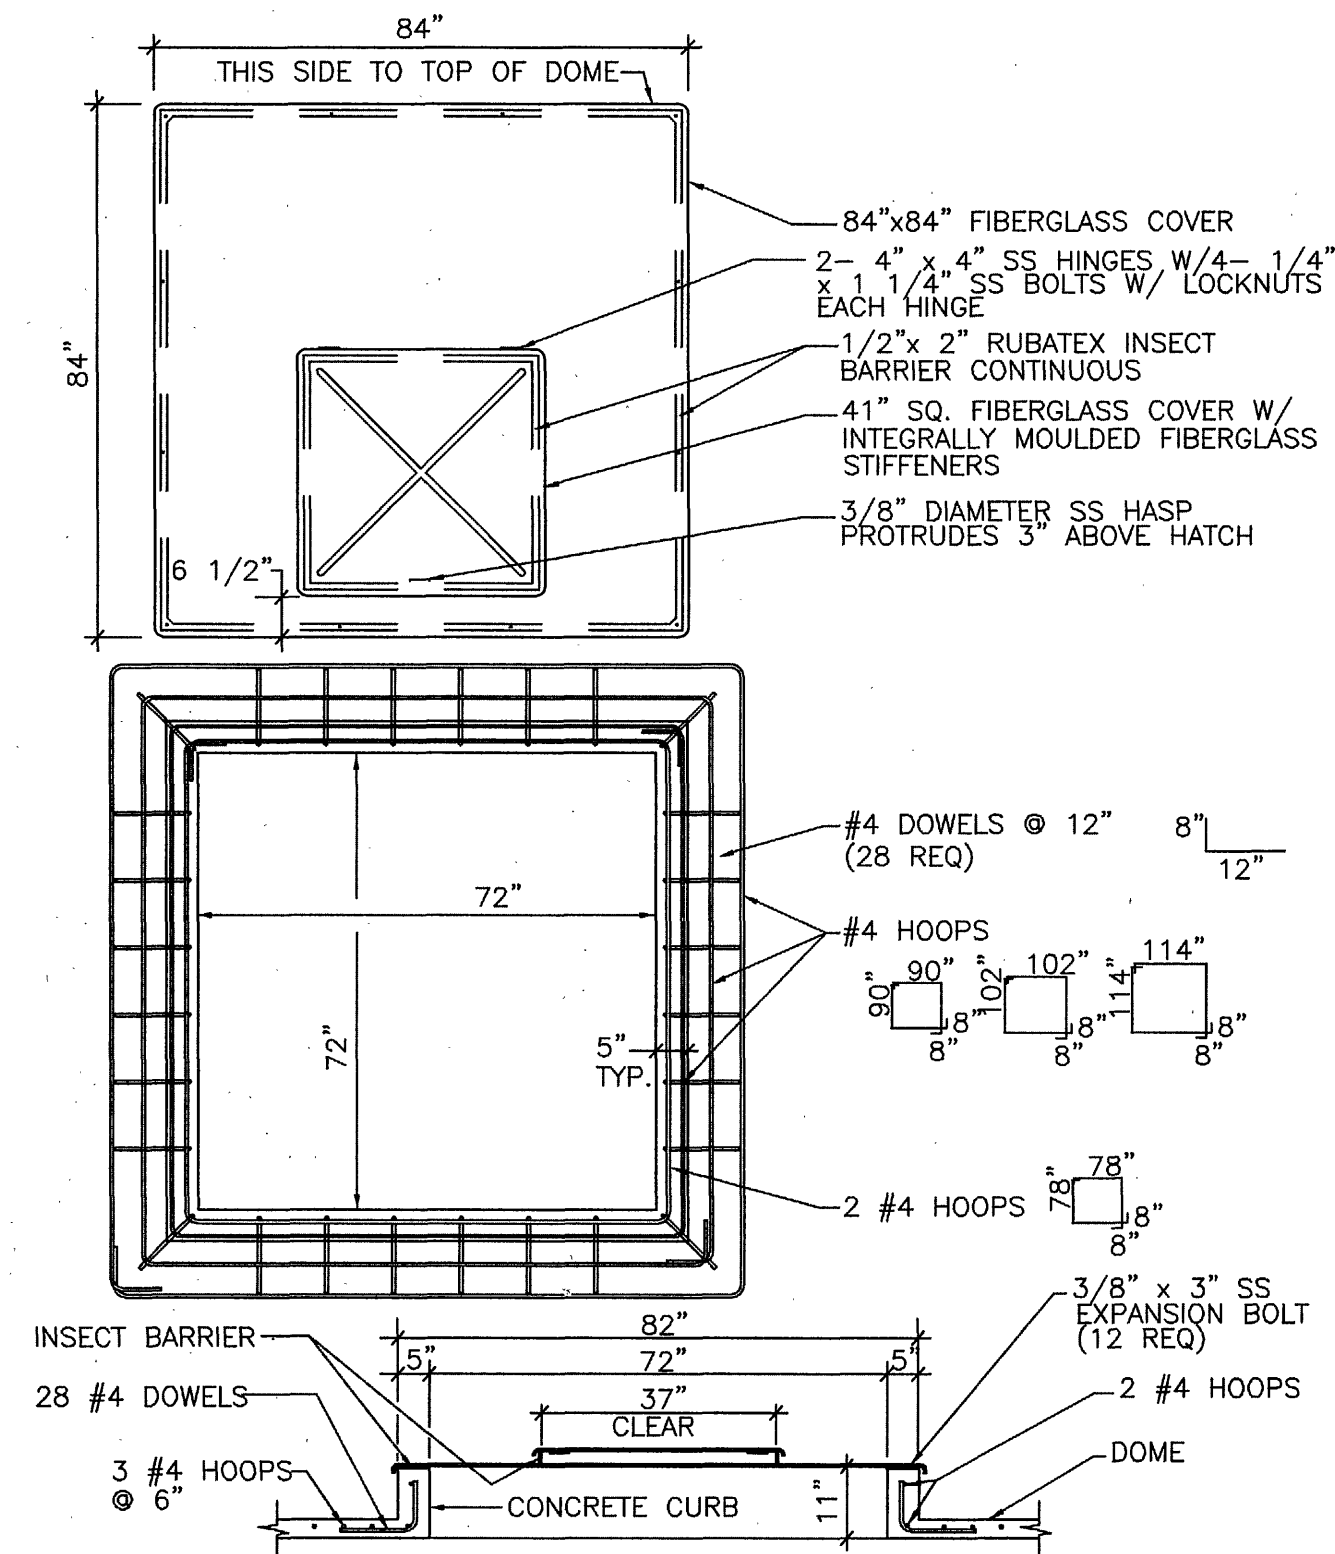

FIBERGLASS HATCH COVER

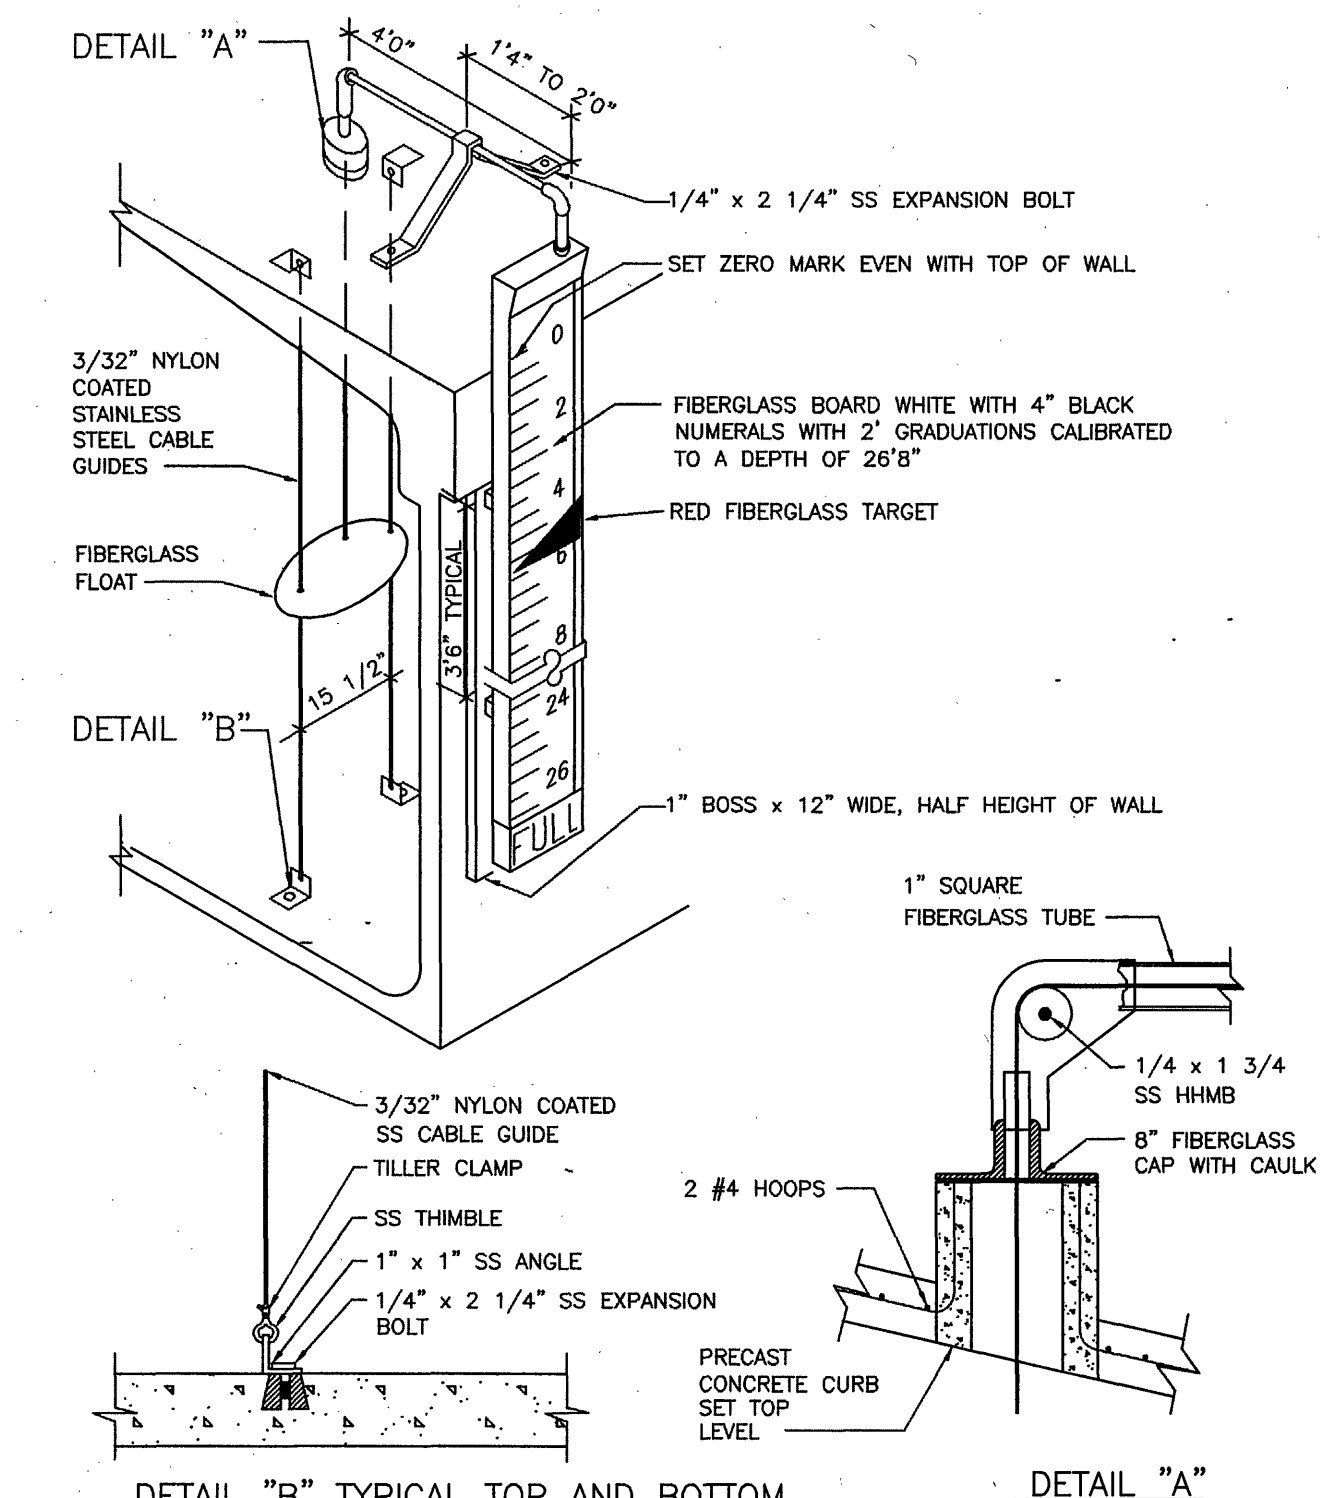

FIBERGLASS LIQUID LEVEL INDICATOR

AS-BUILT

Revisions made 10/27/08

ENGINEERING SERVICES

2012 SOUTH JEFFERSON STREET
ROANOKE, VIRGINIA 24014
PHONE: (540) 853-5641



HANGING ROCK TERRACE 1 MILLION GALLON WATER STORAGE TANK

Designed By: RRB
Drawn By: RRB
Checked By: RWB
Date: 07/13/08
Scale: NTS
Plan #: 00-00
Sheet: 4 OF 4