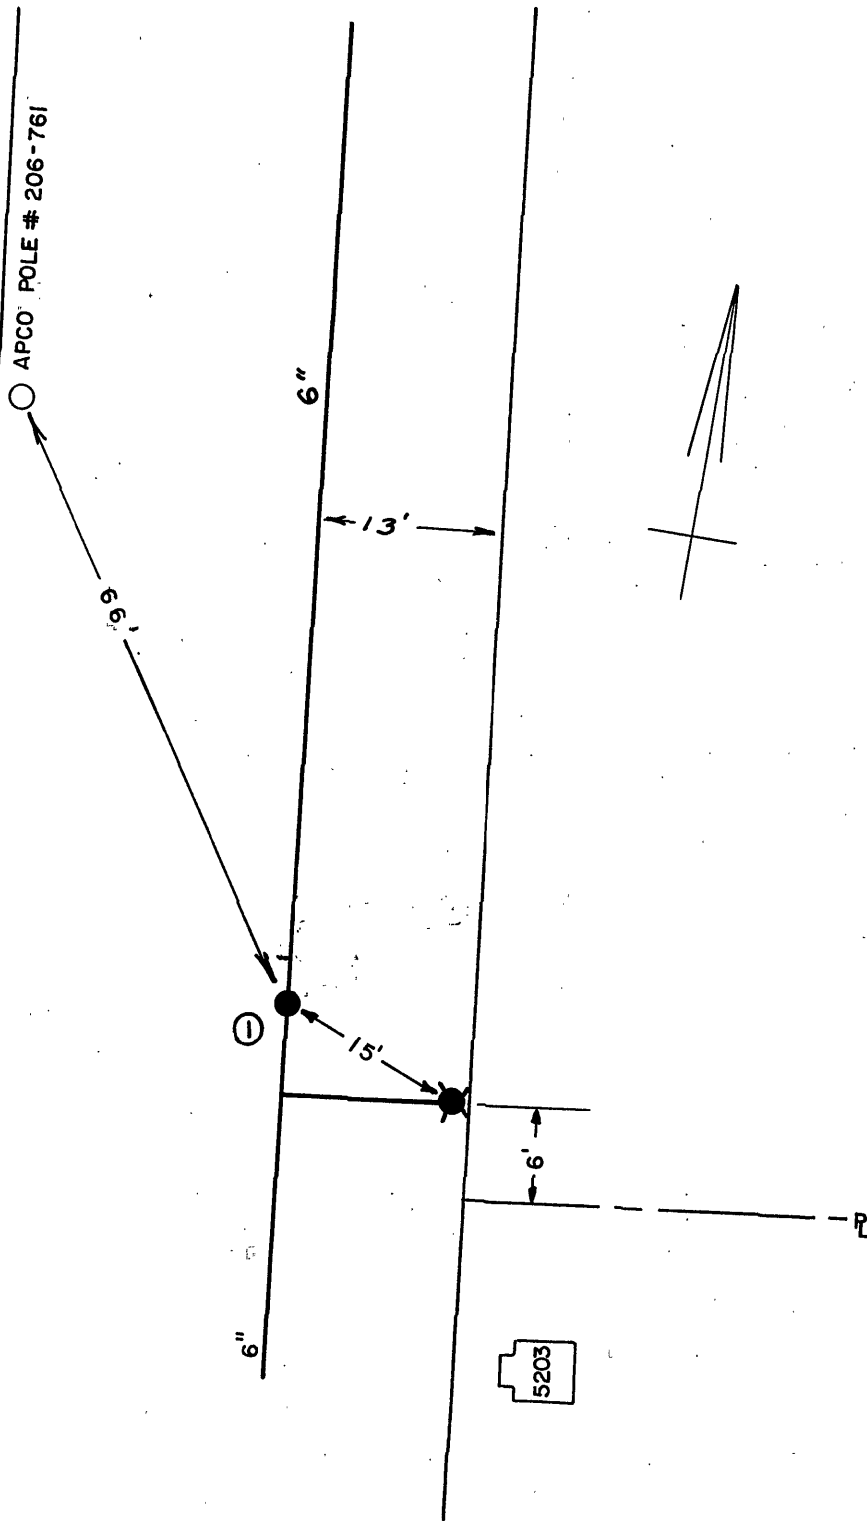


TRIAL" TRACING
X & E CO., N.Y.

5/94 NP

HEARTHSTONE ROAD

[illegible]

CITY OF ROANOKE - WATER DEPT.
VALVE DIAGRAM
HEARTHSTONE RD.
S. OF NELMS LANE N.W.

SEC. MAP 219

DATE _____

PAGE NO.