


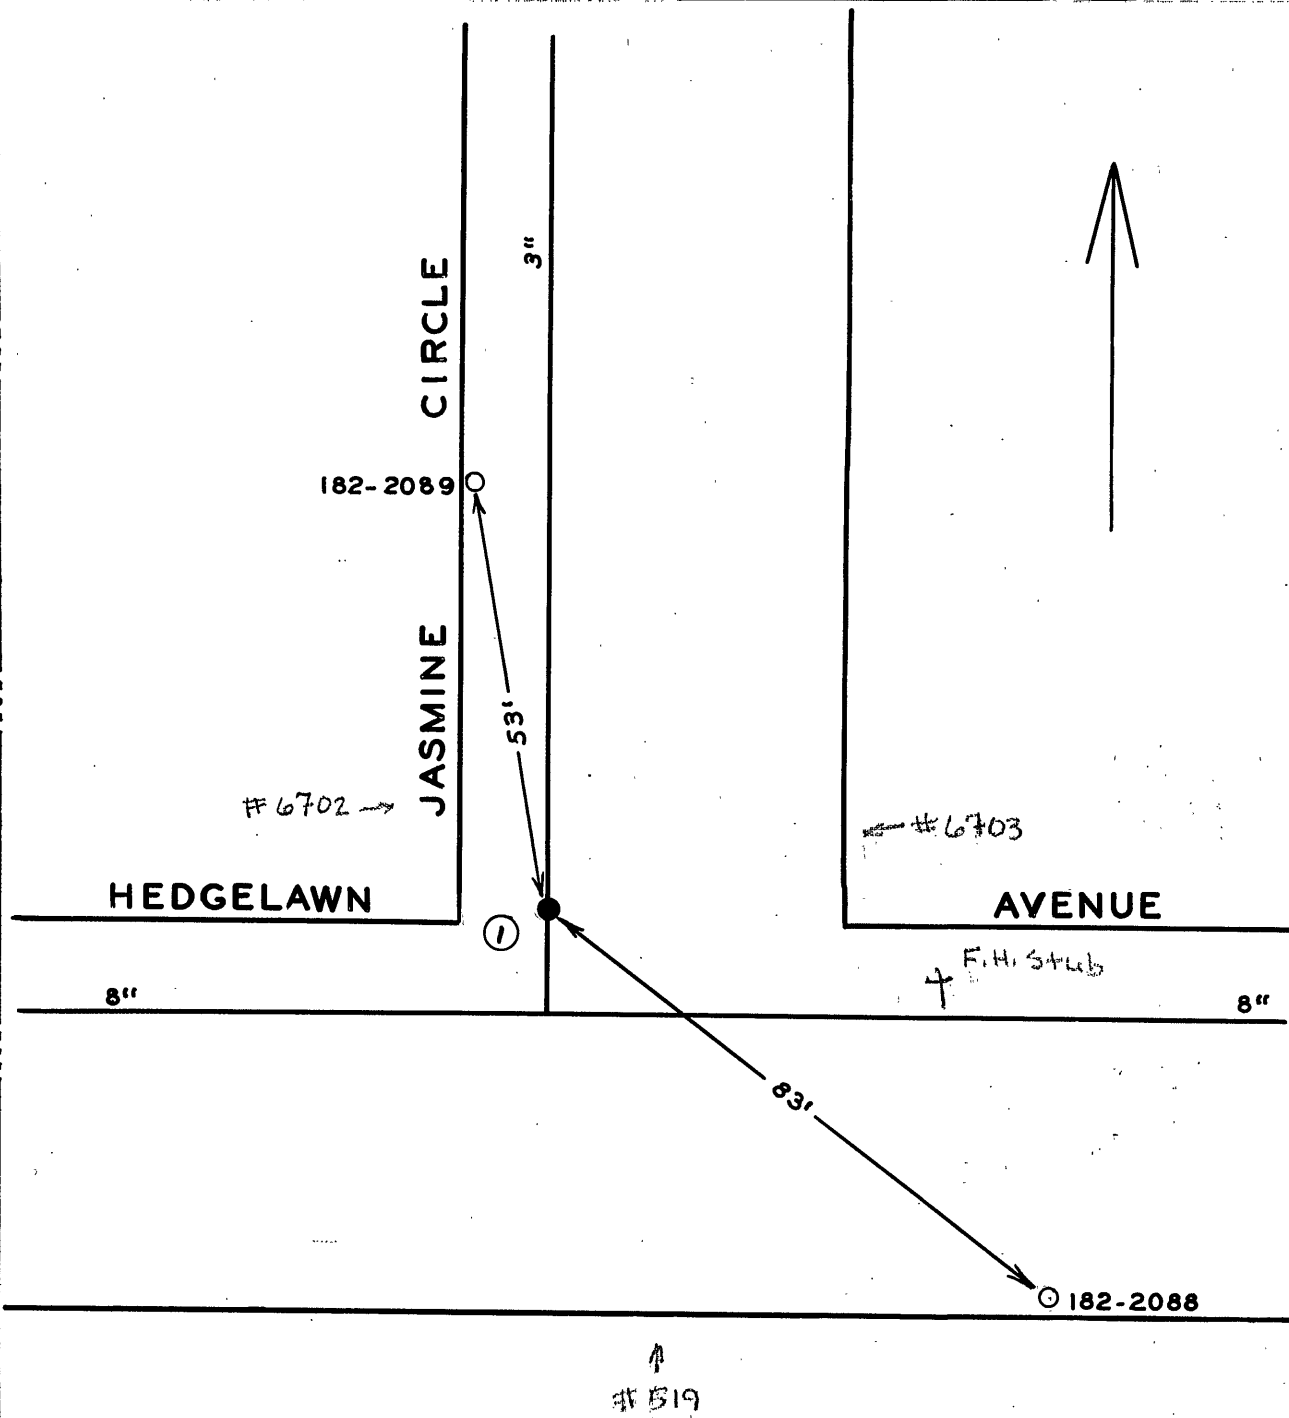

DATE	NO.	SIZE	MAKE	OPEN	TURNS
12-63	1	3"	MUELLER	R	12

CITY OF ROANOKE - WATER DEPT.	
VALVE DIAGRAM	
HEDGE LAWN AVENUE &	
JASMINE CIRCLE N.E.	
SEC. MAP 46	Roanoke County
DATE	PAGE NO.