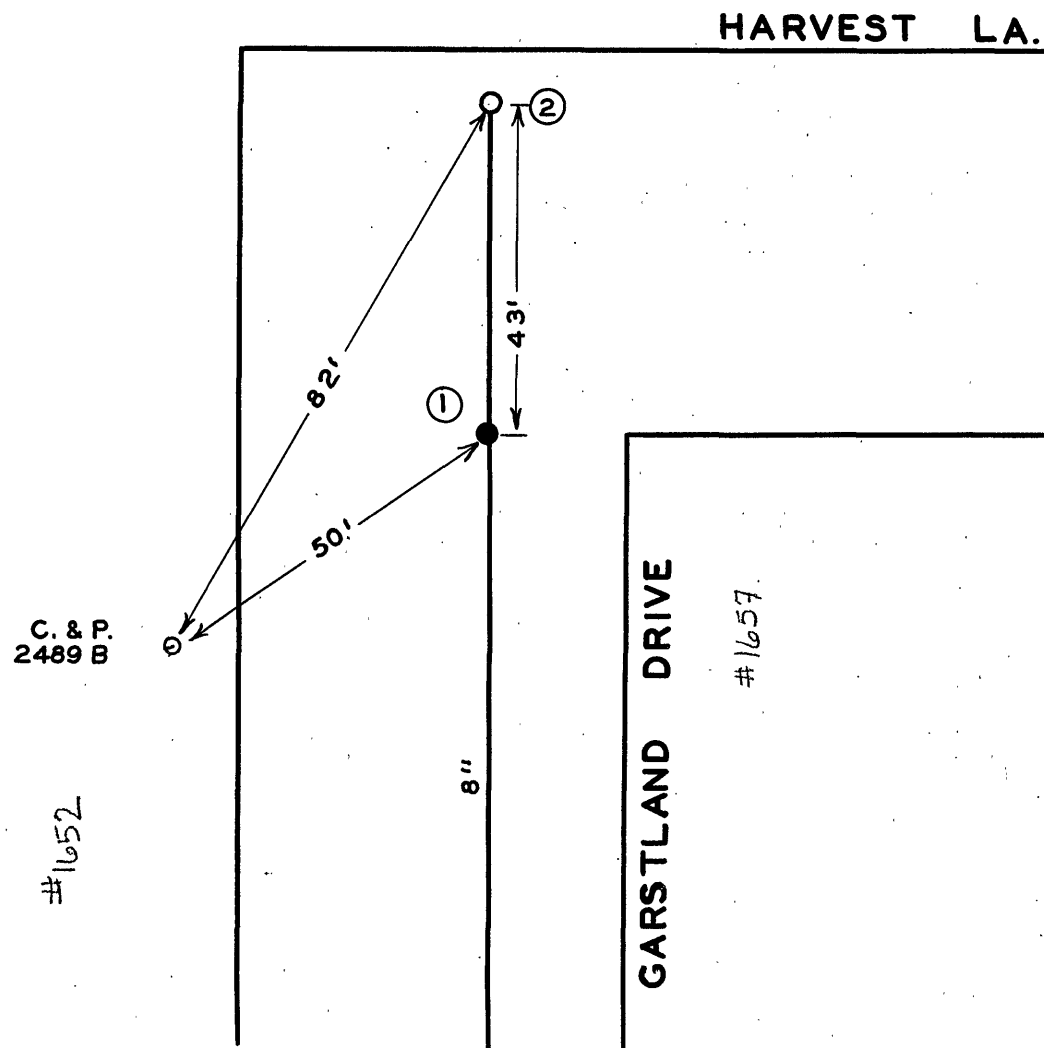


[illegible]

12/2000 JH

#1652

C. & P.
2489 B

GARSTLAND DRIVE

#1657.

HARVEST L.A.

CITY OF ROANOKE - WATER DEPT. VALVE DIAGRAM

GARSTLAND DRIVE &
HARVEST LANE

SEC. MAP 638

N.W.

DATE

PAGE NO.