


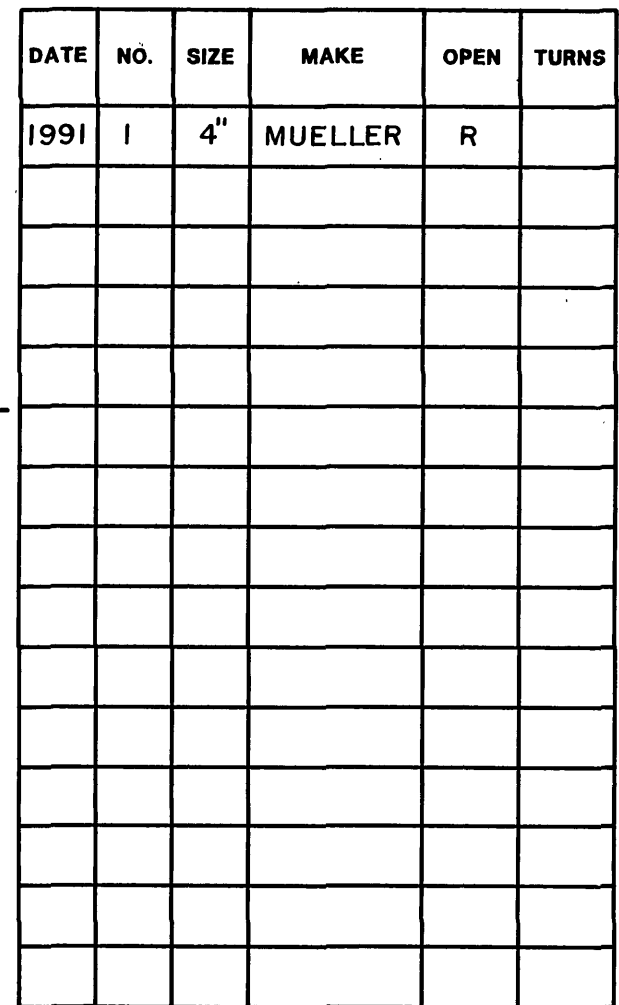

PAGE NO.

10/2000 JH