


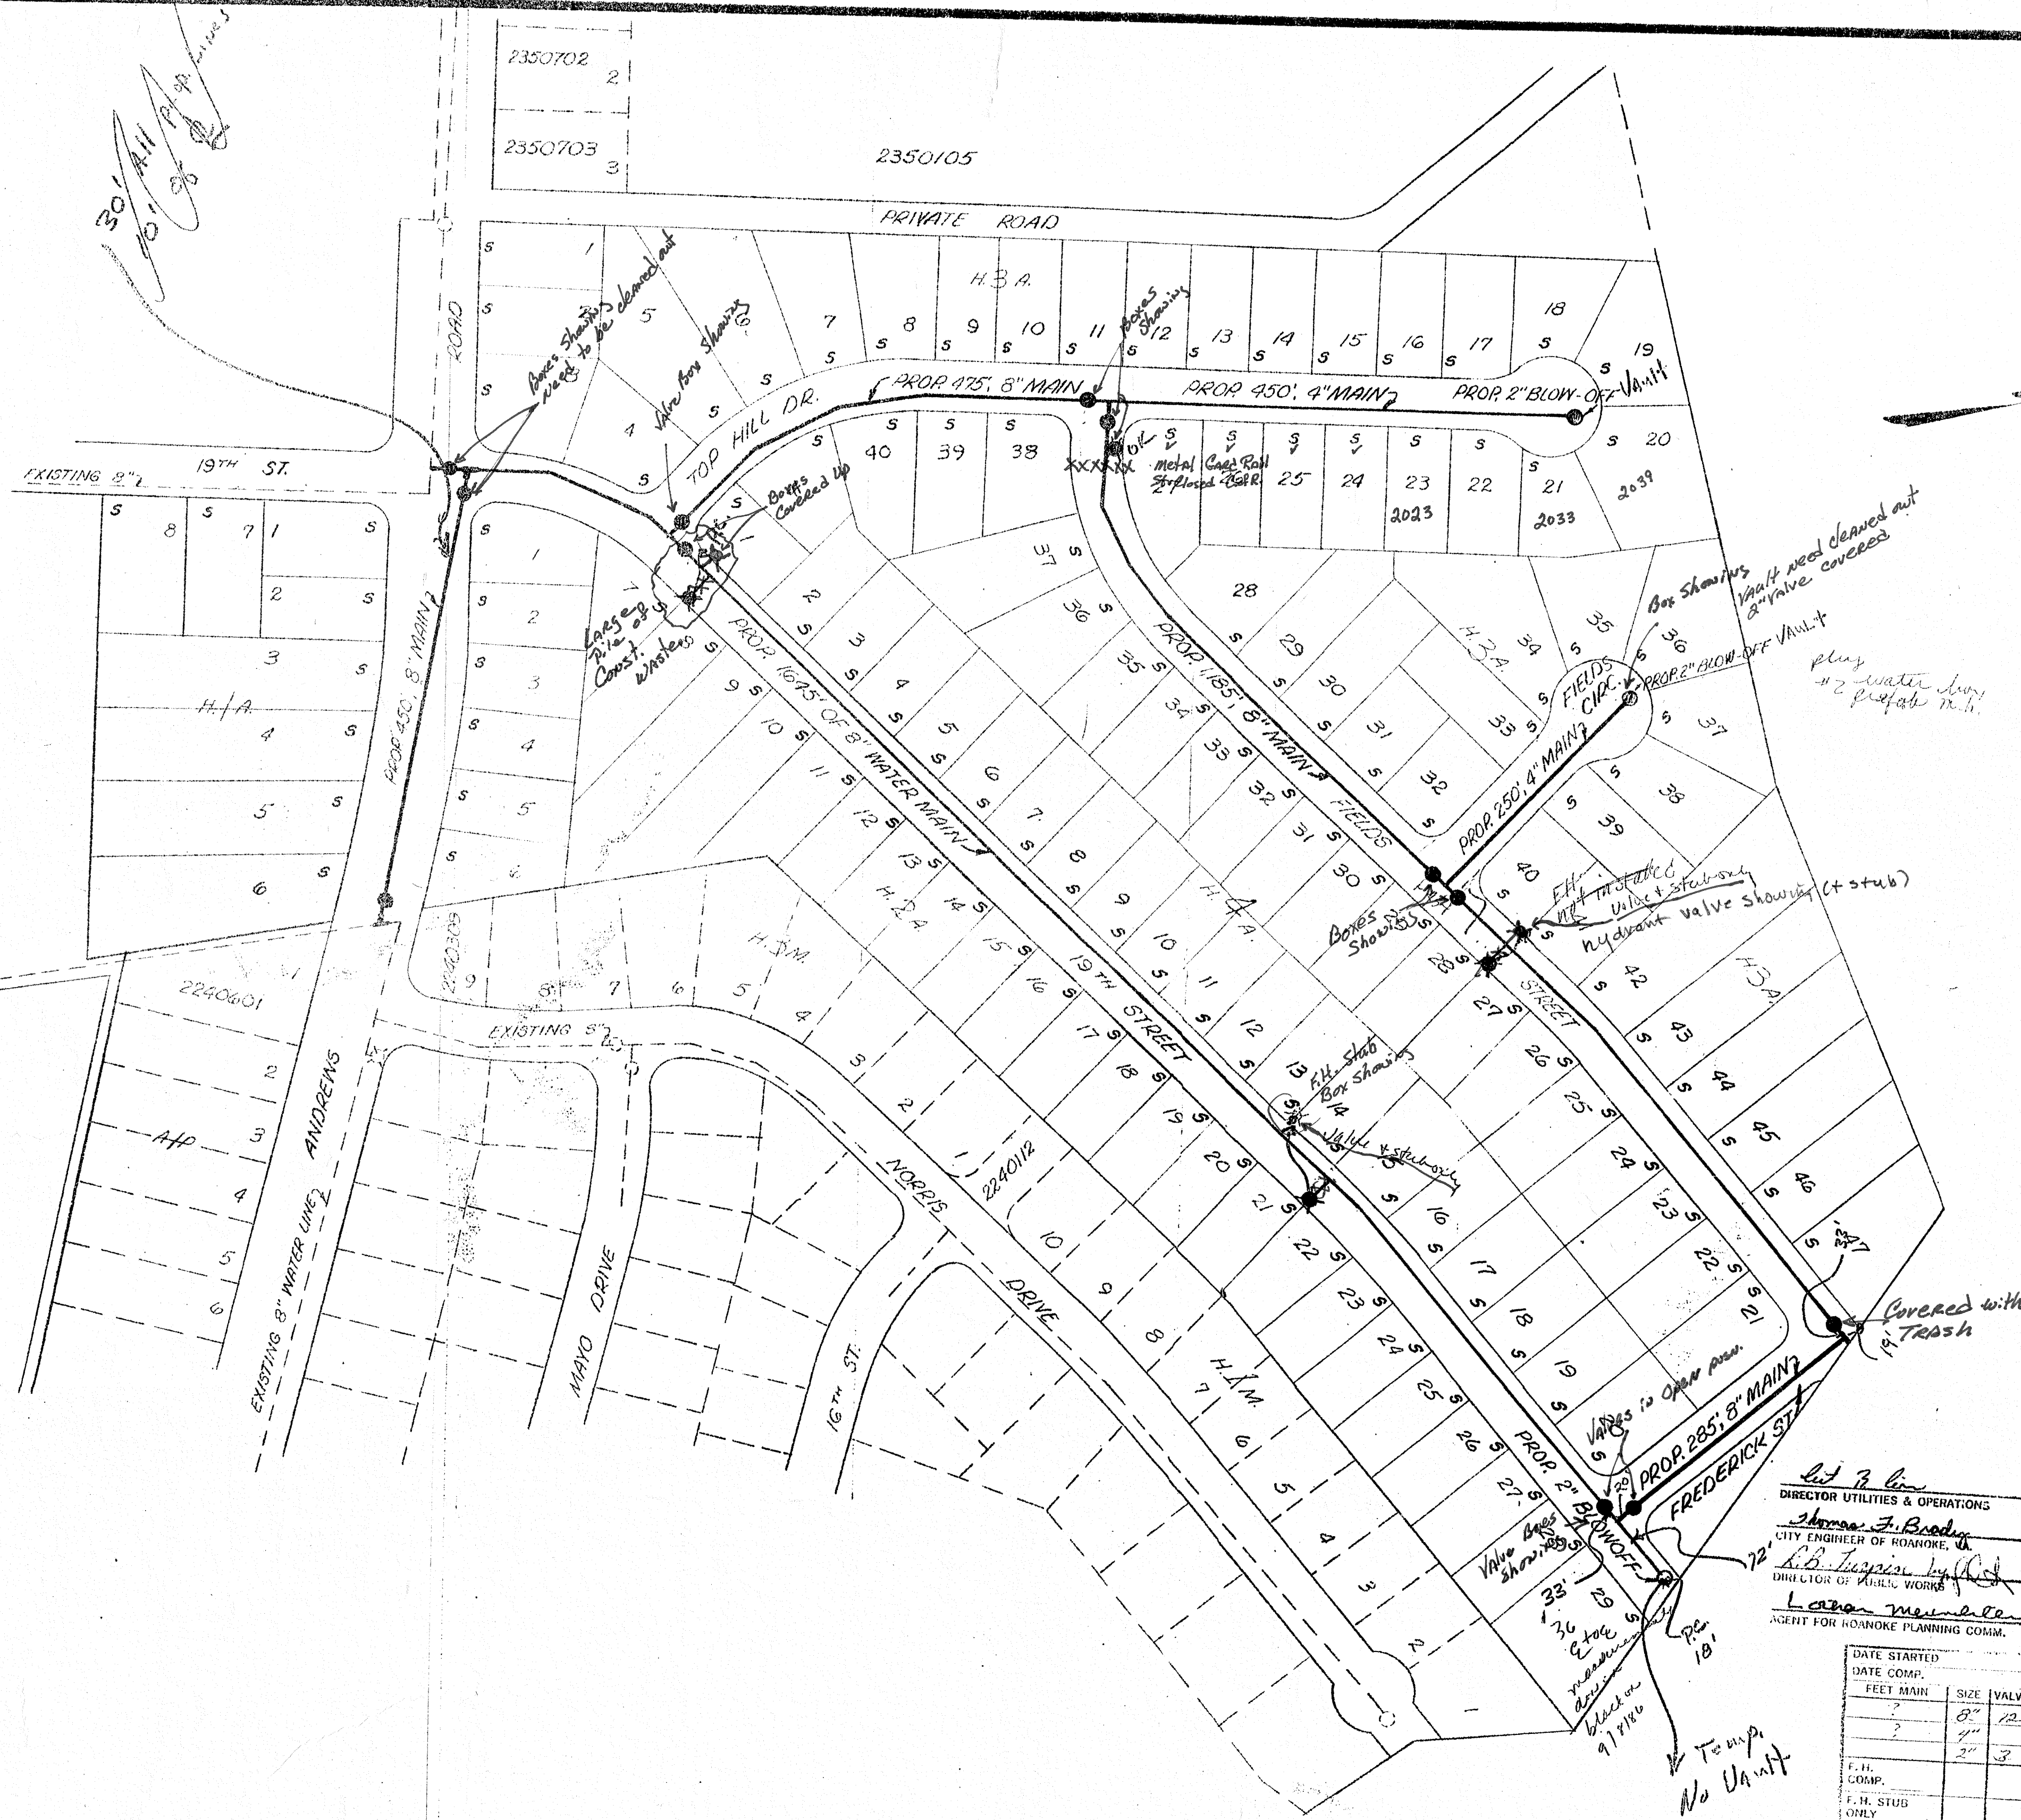

NOTE: FIRE HYDRANT LATERALS INSTALLED
BY CONTRACTOR
FIRE HYDRANTS TO BE INSTALLED
BY THE CITY OF ROANOKE.

Let & line
 DIRECTOR UTILITIES & OPERATIONS
Thomas F. Brady
 CITY ENGINEER OF ROANOKE, VA
 4-13-76
 DATE
R.B. Turpin, Jr.
 DIRECTOR OF PUBLIC WORKS
 4-13-76
 DATE
Laron Mendenhall
 AGENT FOR ROANOKE PLANNING COMM.
 4-13-76
 DATE

DATE STARTED	DATE COMP.	FEET MAIN	SIZE	VALVE	VAULT	BOX
		?	8"	12	12	
		?	4"	3	2	

AS BUILT
 WATER DEPARTMENT
 CITY OF ROANOKE, VA
 HERITAGE ACRES
 SCALE: 1"=100'
 DRAWN BY: S.B.G. APRIL 13, 1976

#5537 76-6