


PLAN	SURVEYED	BY	DATE
NOTE BOOK	FLIPPED		
NO. 455	ALIGNED CHECKED		
	INT. OF WAT. CHECKED		

PROFILE	SURVEYED	BY	DATE
NOTE BOOK	FLIPPED		
NO. 455	GRADES CHECKED		
	STRUCTURE NOTATIONS CHYC		

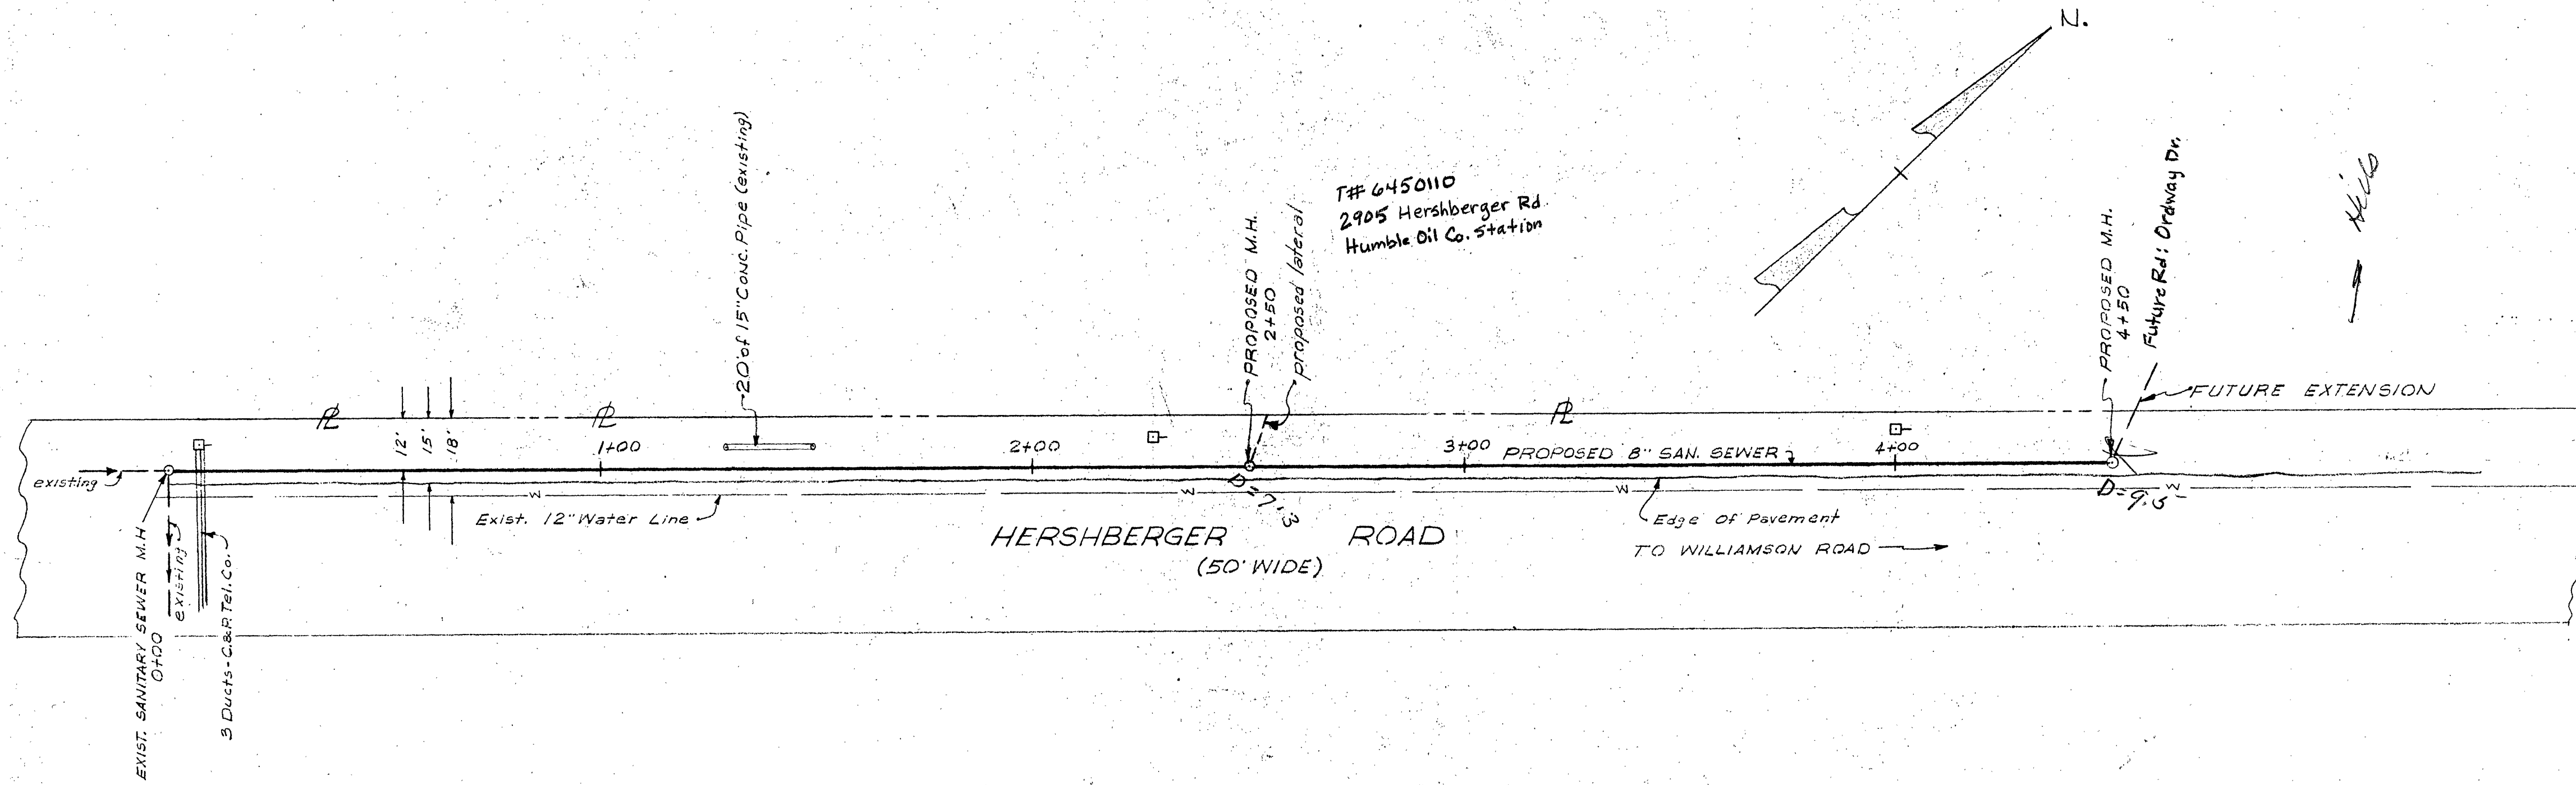

PLAN SCALE: 1"=25'

NOTE:
LINE SHALL BE CONSTRUCTED
IN ACCORDANCE WITH CITY OF
ROANOKE SPECIFICATIONS.

PROFILE SCALE: 1"=10' VERT.
1"=25' HOR.

OFFICE OF CITY ENGINEER
ROANOKE VIRGINIA
PLAN & PROFILE
SANITARY SEWER TO SERVE THE
HUMBLE OIL CO. STATION ON
HERSHBERGER ROAD
DATE: 11/20/68
SCALE: AS SHOWN
PLAN No. 4886

BENCH MARK
ASSUMED ELEV. 120.00
PINE ISLAND AS PER PLANS
PREPARED BY HUMBLE OIL CO.
(FILE No. 313)

J.H.T.
4-26-68

AS BUILT
SEWER
Amen map # 248 4645