


Water Main
6.8 + 12 DIP US Pipe + Fandry
CL 350


Water Services 1"
ADS Blue CTS 4710 Poly

Valves
6.8 + 12
AVK

Fire Hydrants
AVK model # 27-80 5 1/4
(No Hydrant Tags)

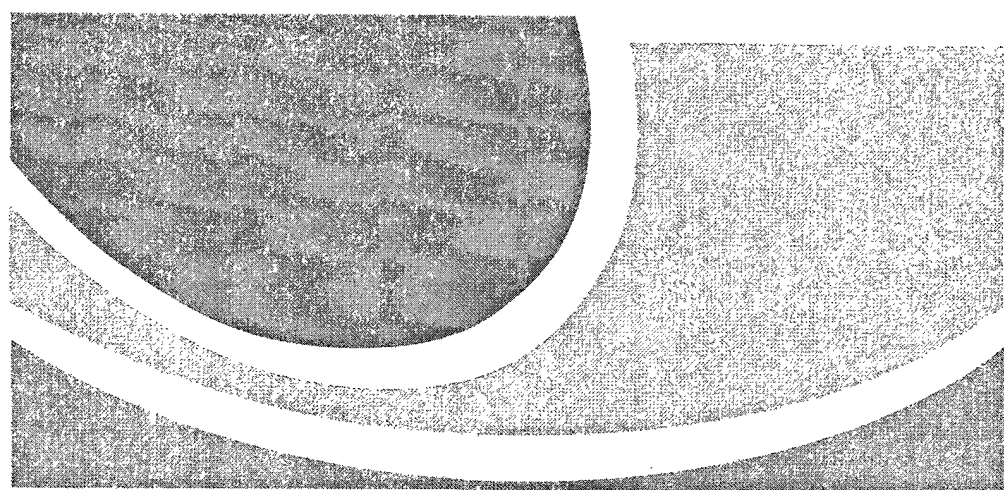


WESTERN VIRGINIA
WATER AUTHORITY

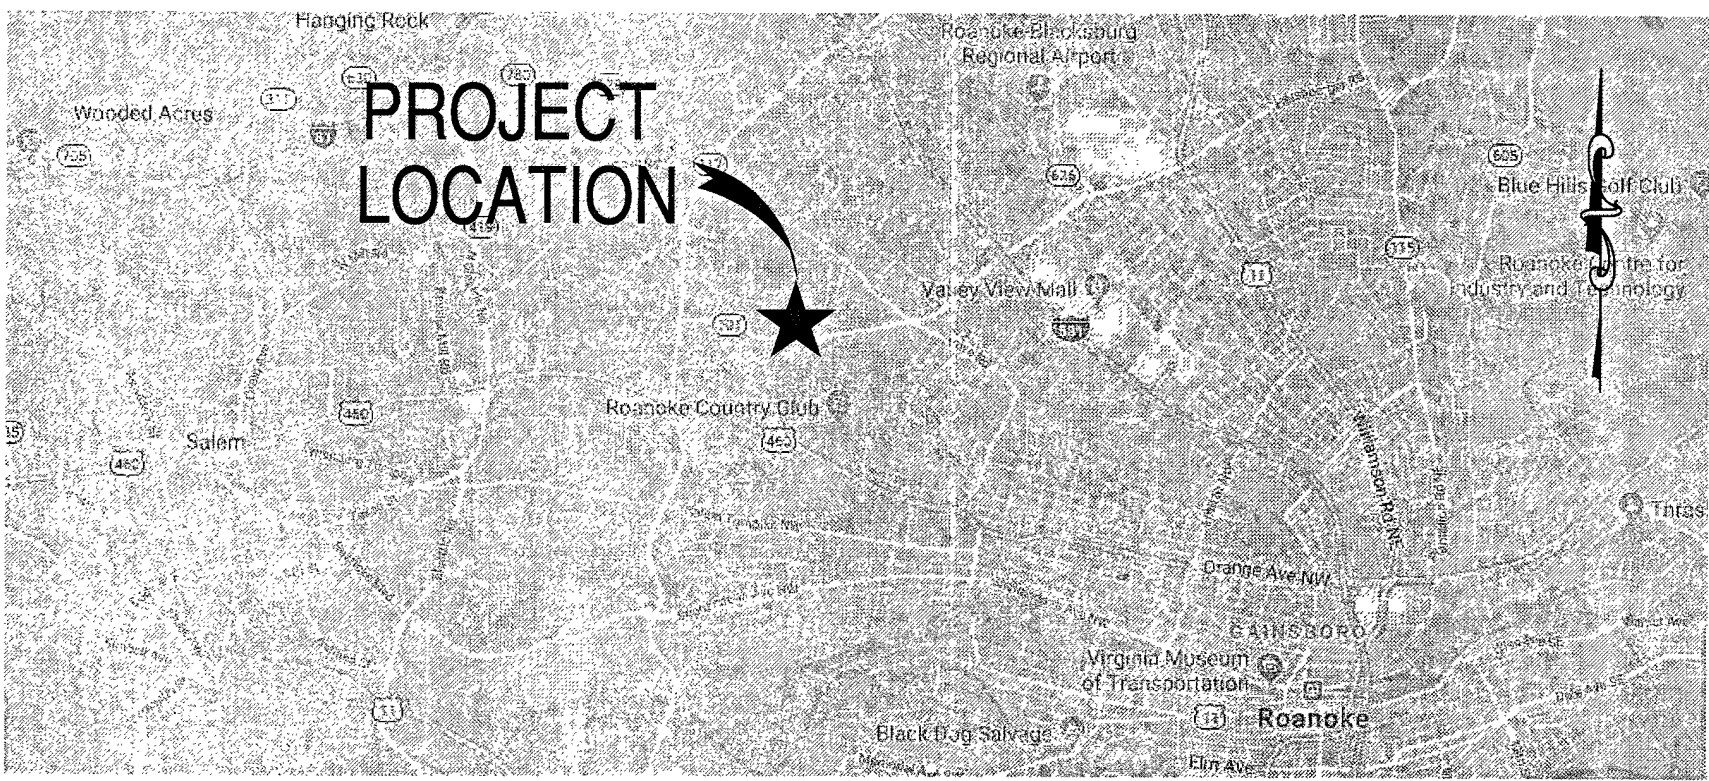

LOCATION MAP
NO SCALE

WESTERN VIRGINIA WATER AUTHORITY
HERSHBERGER ROAD
(GARSTLAND DRIVE TO FAIRHOPE ROAD)
WATER MAIN REPLACEMENT (WCIP-106)

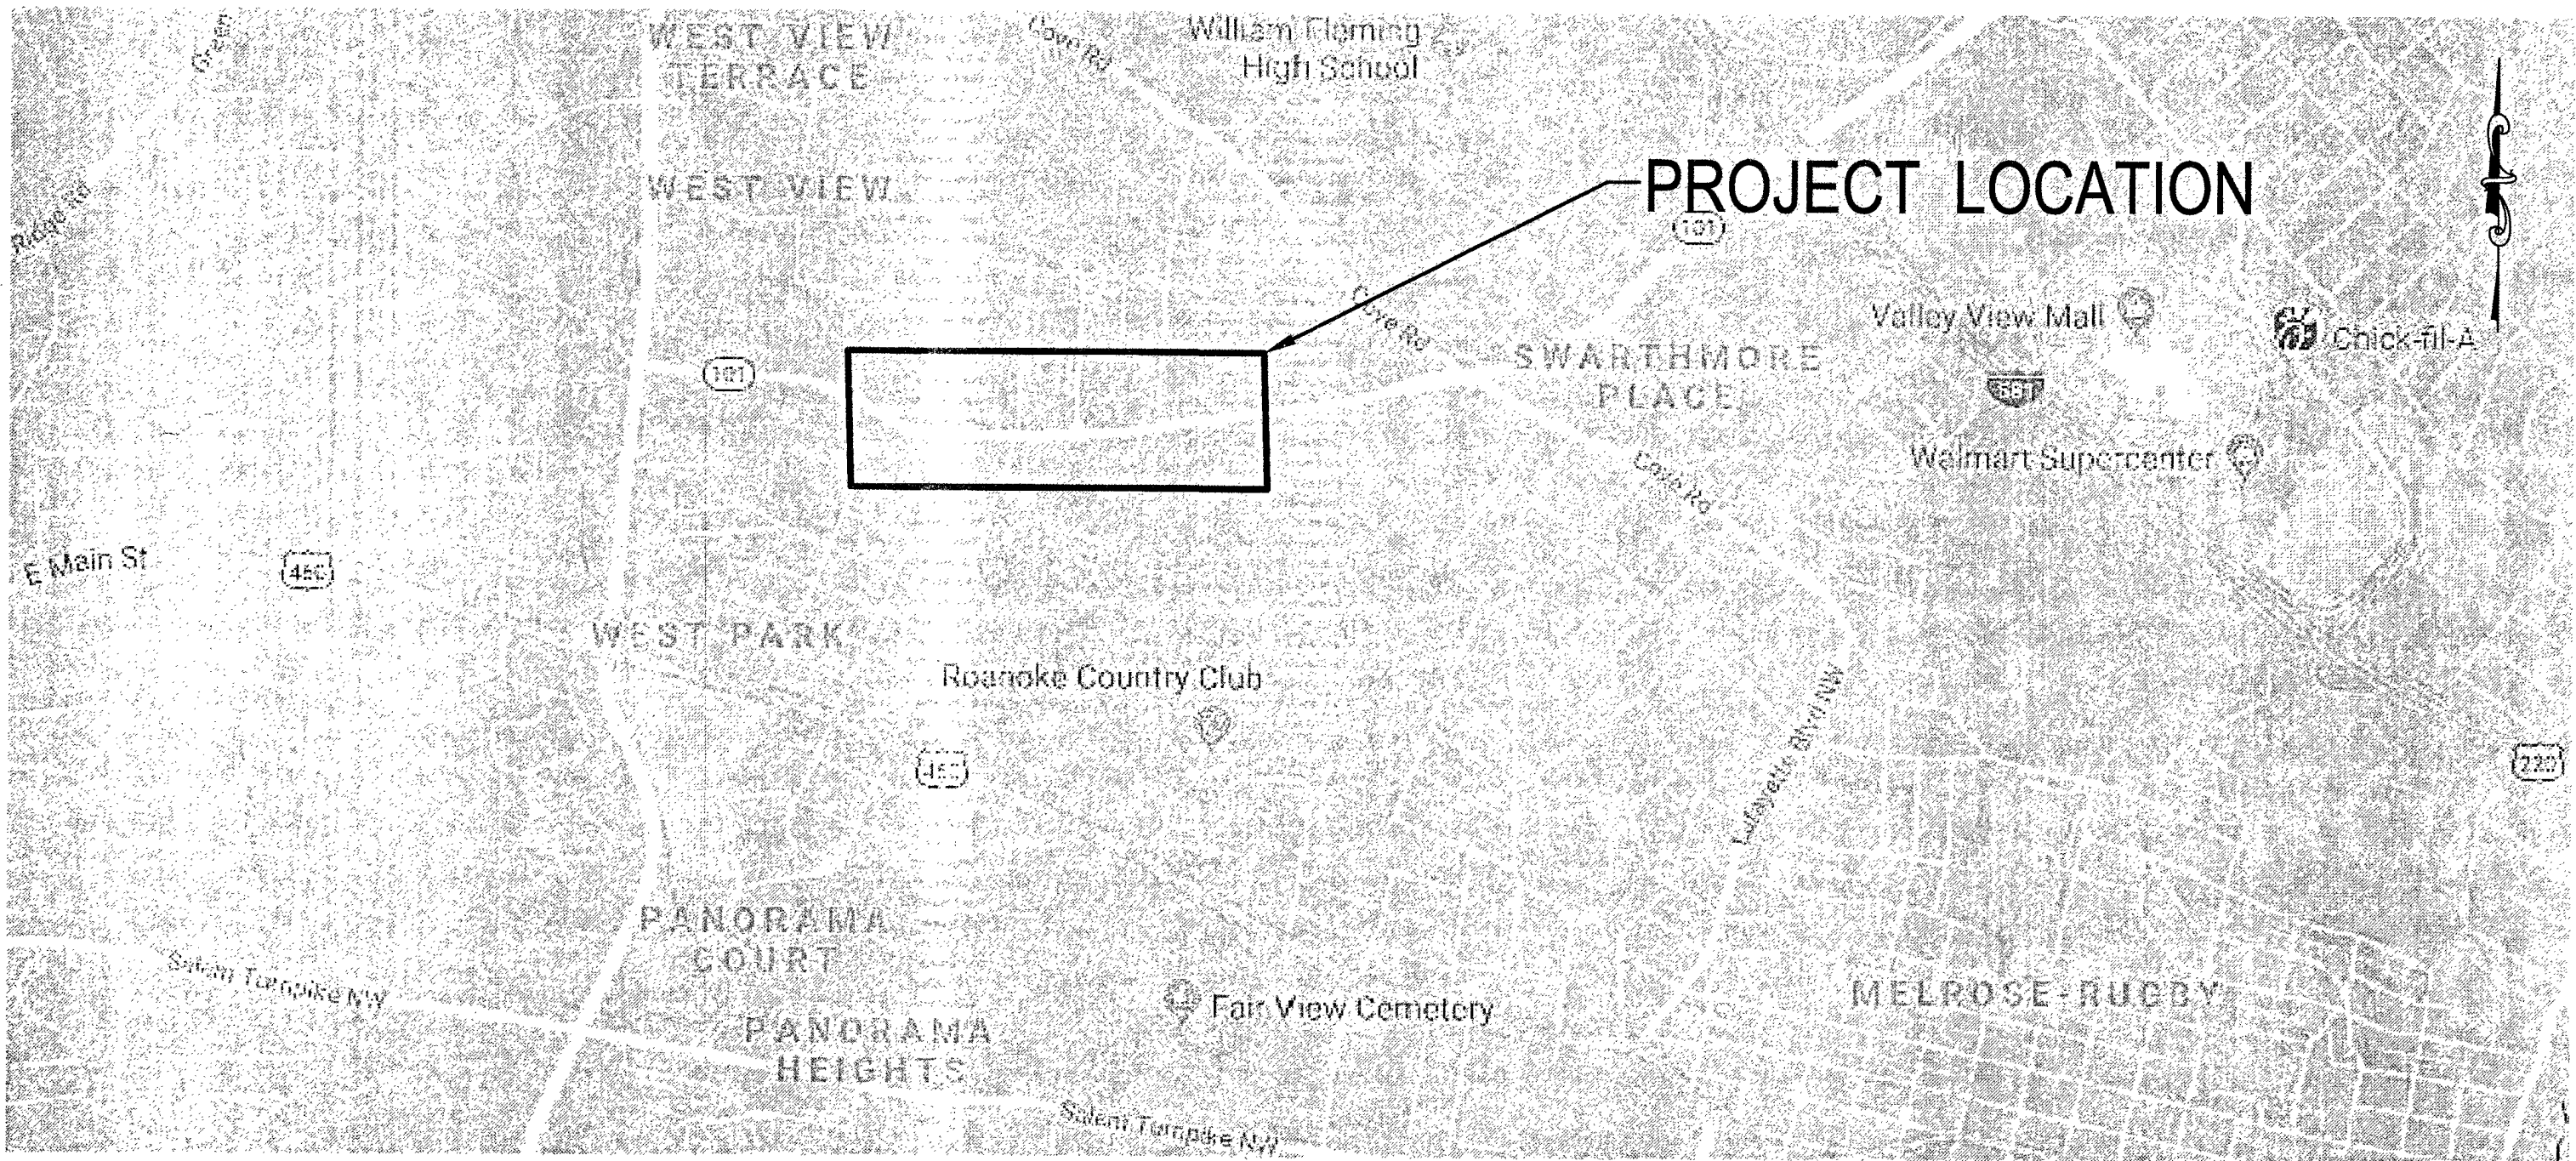


VICINITY MAP
NO SCALE

JULY 2019

DRAWING TITLE	SHEET NUMBER
COVER	1
GENERAL NOTES & PROPOSED LEGEND	2
STANDARD DETAILS	3
STANDARD DETAILS	4
EROSION & SEDIMENT CONTROL & STORMWATER NOTES	5
EROSION & SEDIMENT CONTROL DETAILS	6
SURVEY SCHEDULES, NOTES, & EXISTING LEGEND	7
SHEET LAYOUT & FIRE HYDRANT COVERAGE MAP	8
12" WATER MAIN PLAN - PROFILE, STA. 10+00 TO STA. 14+63	9
12" WATER MAIN PLAN - PROFILE, STA. 14+63 TO STA. 18+10	10
12" WATER MAIN PLAN - PROFILE, STA. 18+10 TO STA. 23+60	11
12" WATER MAIN PLAN - PROFILE, STA. 23+60 TO STA. 29+10	12
12" WATER MAIN PLAN - PROFILE, STA. 29+10 TO STA. 33+73	13
TEMPORARY TRAFFIC CONTROL PLAN NOTES	14
TEMPORARY TRAFFIC CONTROL PLAN FIGURE 1	15
TEMPORARY TRAFFIC CONTROL PLAN FIGURE 1	16
TEMPORARY TRAFFIC CONTROL PLAN FIGURE 2	17
TEMPORARY TRAFFIC CONTROL PLAN FIGURE 3	18
TEMPORARY TRAFFIC CONTROL PLAN FIGURE 4	19

As built 6/22/20
Contractor: E.C. PACE
Inspectors: Charles Crush/Brian Whitenack

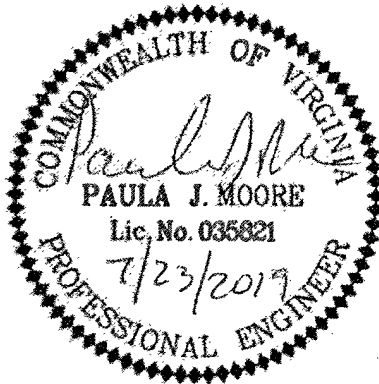

WESTERN VIRGINIA WATER AUTHORITY
601 South Jefferson Street, Suite 300
Roanoke, Virginia 24011

DES: PJM
DRAWN: JES
CHECK: GWF
DATE: 7/23/19

SCALE: N/A
HORIZ: N/A
VERT: N/A

HERSHBERGER ROAD
(GARSTLAND DRIVE TO FAIRHOPE ROAD)
WATER MAIN REPLACEMENT (WCIP-106)

COVER

APPROVED FOR CONSTRUCTION

REV	DATE	DESCRIPTION
-----	------	-------------

DRAWING	SHEET
-	1

Hershberger Water Line Replacement 2020 / E.C. PACE
AS-BUILTS - 6/22/2020 Brian Whitenack / Charles Crush