

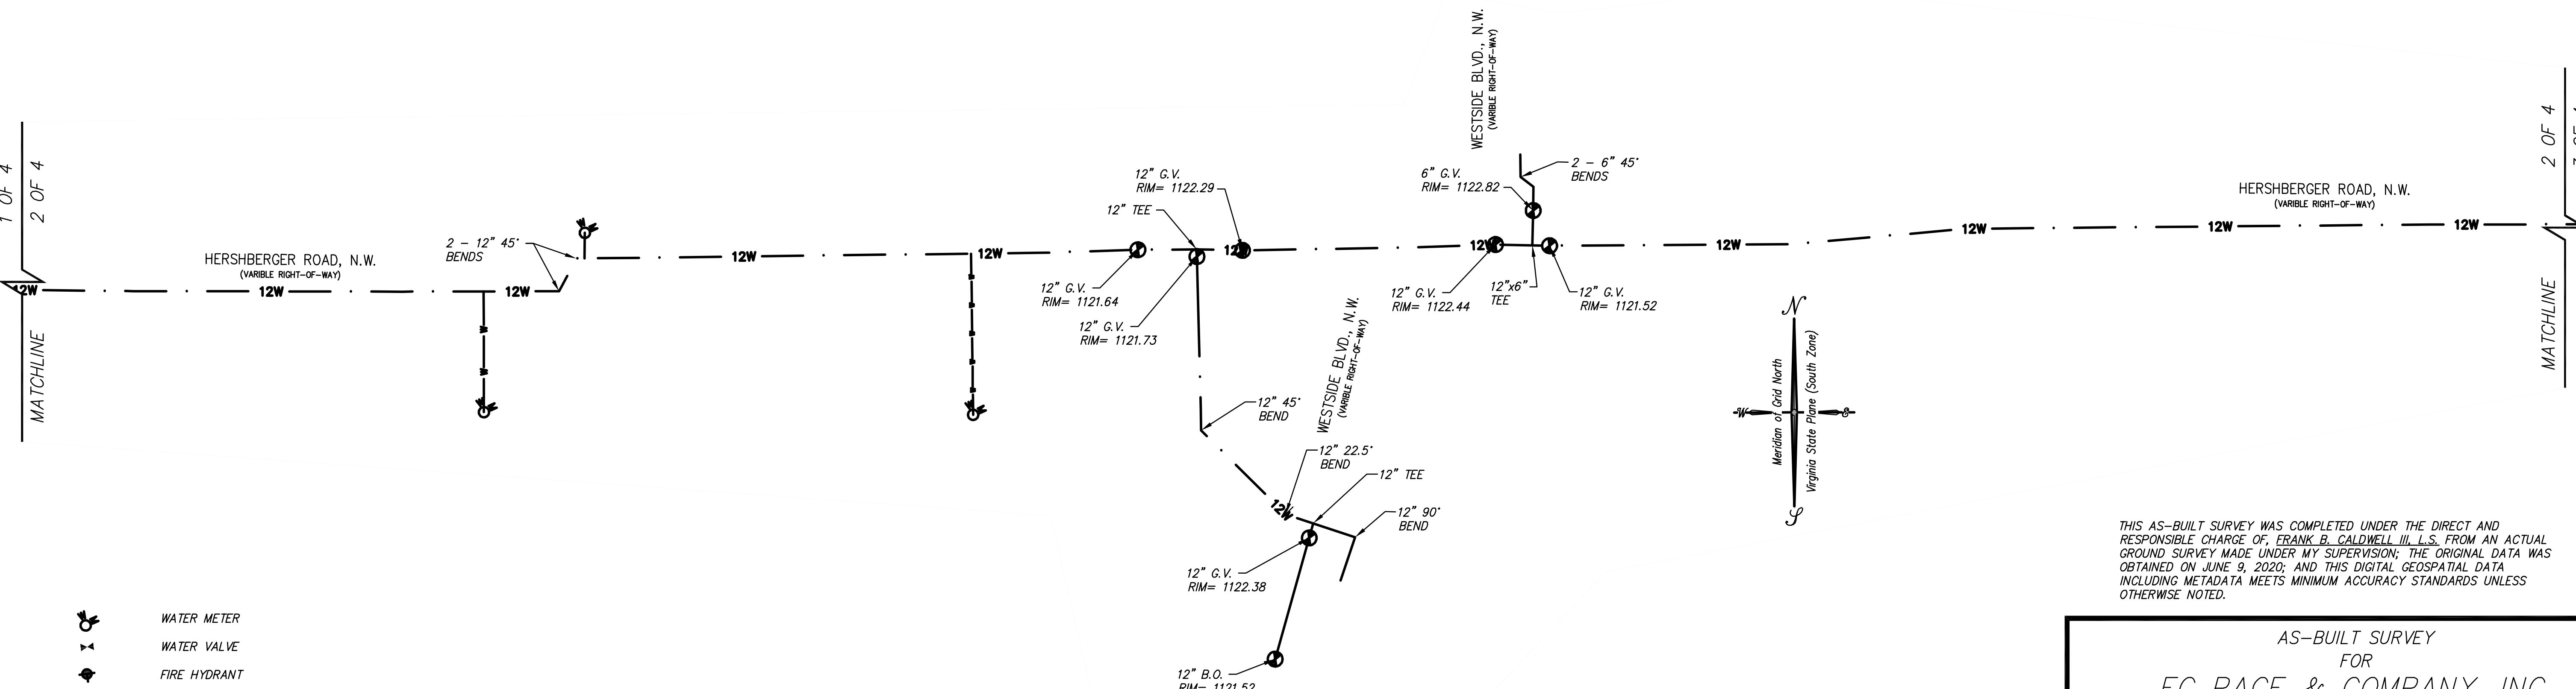


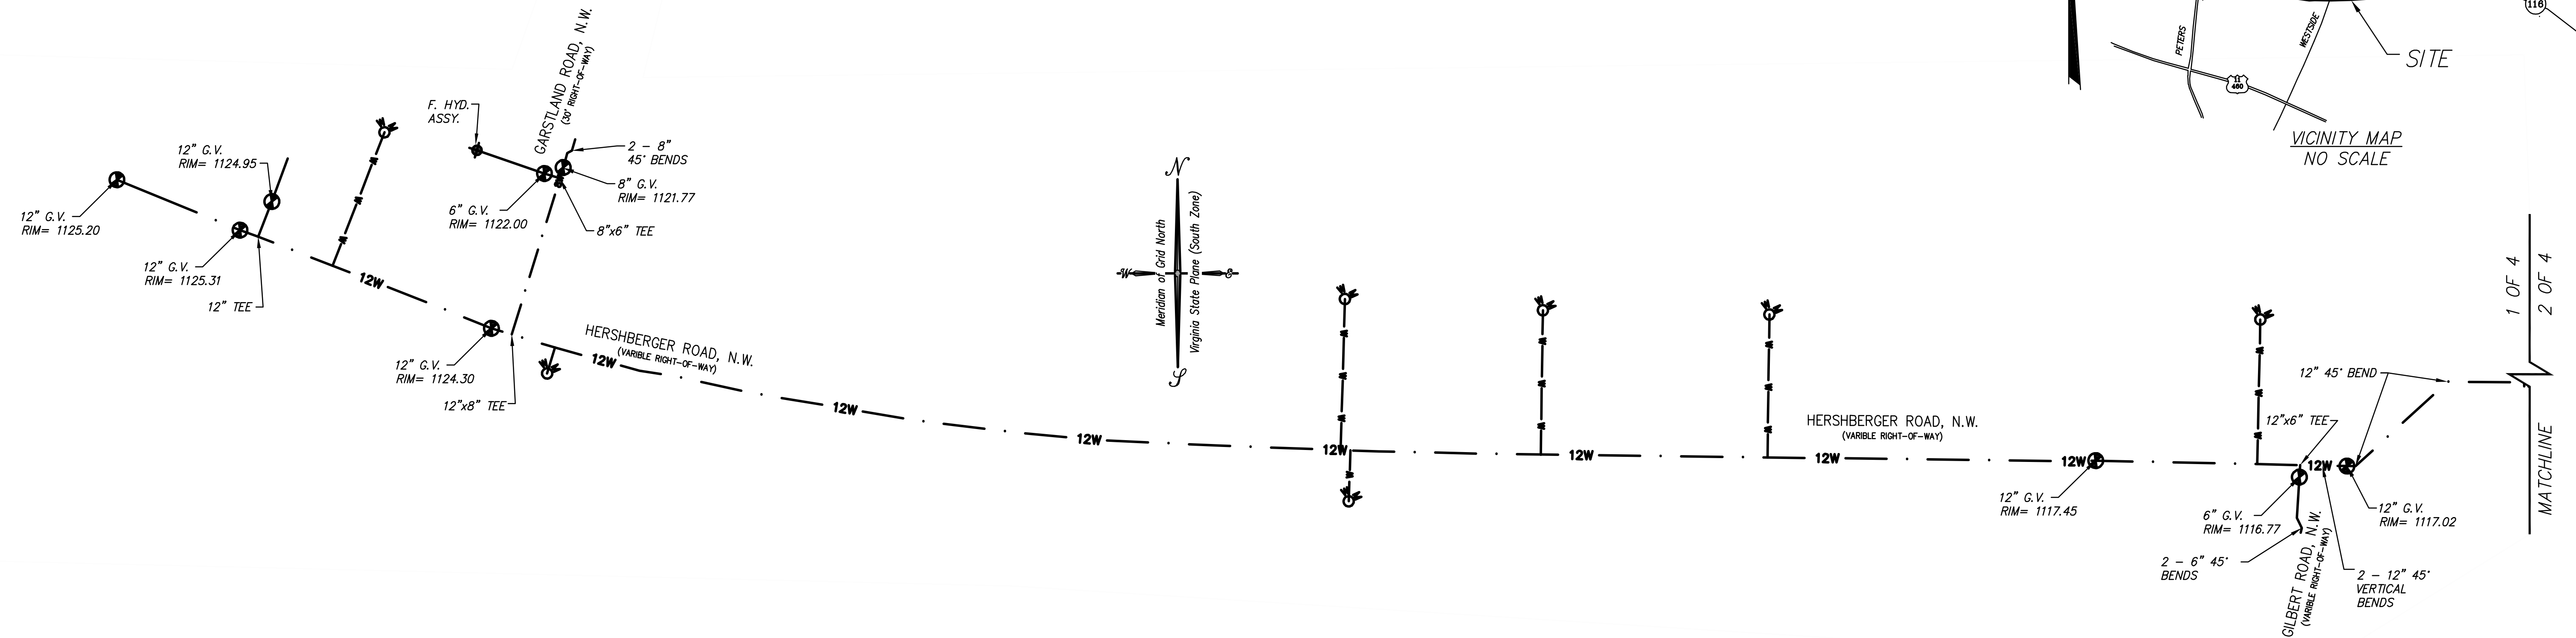


- WATER METER
- WATER VALVE
- FIRE HYDRANT
- WATER VAULT

THIS AS-BUILT SURVEY IS BASED ON THE COORDINATE SYSTEM OF PLANS BY WRA FOR THE WESTERN VIRGINIA WATER AUTHORITY TITLED HERSHBERGER ROAD (GARSTLAND DRIVE TO FAIRHOPE ROAD). WATERLINE REPLACEMENT (WCIP-106), DATED JULY 23, 2019.

THIS AS-BUILT SURVEY IS BASED ON A FIELD SURVEY OF VISIBLE WATERLINE IMPROVEMENTS AND AS-BUILT SKETCHES FROM THE CONTRACTOR FOR UNDERGROUND IMPROVEMENTS. THE FIELD SURVEY WAS COMPLETED BY CALDWELL WHITE ASSOCIATES, CONCLUDED ON JUNE 9, 2020.

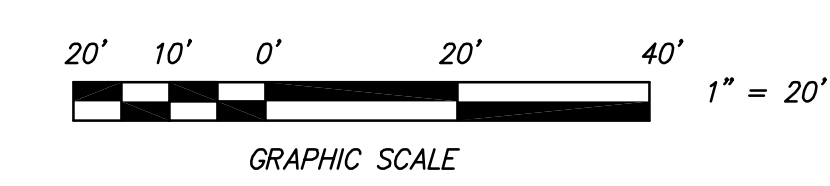

THIS AS-BUILT SURVEY WAS COMPLETED UNDER THE DIRECT AND RESPONSIBLE CHARGE OF, FRANK B. CALDWELL III, L.S., FROM AN ACTUAL GROUND SURVEY MADE UNDER MY SUPERVISION; THE ORIGINAL DATA WAS OBTAINED ON JUNE 9, 2020; AND THIS DIGITAL GEOSPATIAL DATA INCLUDING METADATA MEETS MINIMUM ACCURACY STANDARDS UNLESS OTHERWISE NOTED.

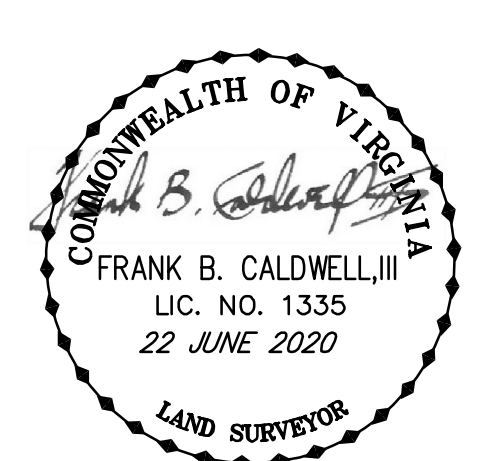

AS-BUILT SURVEY
FOR
EC PACE & COMPANY, INC.
SHOWING NEW WATERLINE LOCATION
(WCIP-106)
SITUATE HERSHBERGER ROAD, N.W.
BETWEEN GARSTLAND DRIVE, N.W. AND FAIRHOPE ROAD, N.W.
CITY OF ROANOKE, VIRGINIA

Drawn: C.L. Hurd
Checked: F.B. Caldwell
Date: JUNE 22, 2020
Scale: 1"=20'
Tax Parcel: VARIES
Field Book: CH-20
W.O.: 20-0001

CWA
CALDWELL WHITE ASSOCIATES
ENGINEERS / SURVEYORS / PLANNERS
4203 MELROSE AVENUE, N.W. P.O. BOX 6260
ROANOKE, VIRGINIA 24017-0260
Telephone: (540) 366-5400 Fax: (540) 366-5702
E-Mail: cwaroanoke@aol.com