
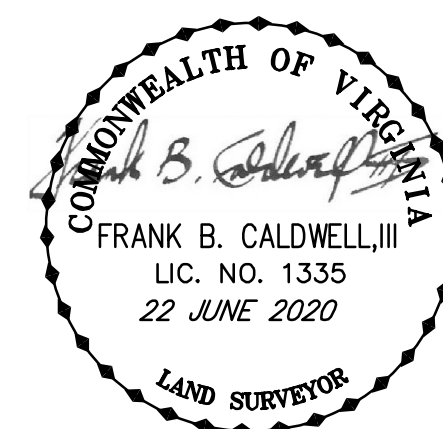


- WATER METER
- WATER VALVE
- FIRE HYDRANT
- WATER VAULT

THIS AS-BUILT SURVEY IS BASED ON THE COORDINATE SYSTEM OF PLANS BY WRA FOR THE WESTERN VIRGINIA WATER AUTHORITY TITLED HERSHBERGER ROAD (GARSTLAND DRIVE TO FAIRHOPE ROAD). WATERLINE REPLACEMENT (WCIP-106), DATED JULY 23, 2019.

THIS AS-BUILT SURVEY IS BASED ON A FIELD SURVEY OF VISIBLE WATERLINE IMPROVEMENTS AND AS-BUILT SKETCHES FROM THE CONTRACTOR FOR UNDERGROUND IMPROVEMENTS. THE FIELD SURVEY WAS COMPLETED BY CALDWELL WHITE ASSOCIATES, CONCLUDED ON JUNE 9, 2020.

THIS AS-BUILT SURVEY WAS COMPLETED UNDER THE DIRECT AND RESPONSIBLE CHARGE OF, FRANK B. CALDWELL III, L.S., FROM AN ACTUAL GROUND SURVEY MADE UNDER MY SUPERVISION; THE ORIGINAL DATA WAS OBTAINED ON JUNE 9, 2020; AND THIS DIGITAL GEOSPATIAL DATA INCLUDING METADATA MEETS MINIMUM ACCURACY STANDARDS UNLESS OTHERWISE NOTED.

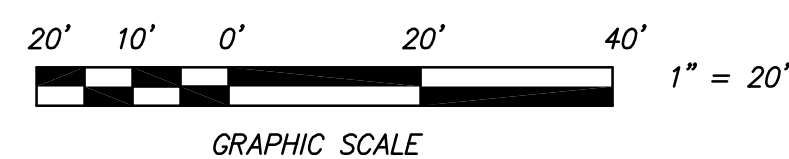

AS-BUILT SURVEY  
FOR  
**EC PACE & COMPANY, INC.**  
SHOWING NEW WATERLINE LOCATION  
(WCIP-106)  
SITUATE HERSHBERGER ROAD, N.W.  
BETWEEN GARSTLAND DRIVE, N.W. AND FAIRHOPE ROAD, N.W.  
CITY OF ROANOKE, VIRGINIA

Drawn: C.L. Hurd  
Checked: F.B. Caldwell  
Date: JUNE 22, 2020  
Scale: 1"=20'  
Tax Parcel: VARIES  
Field Book: CH-20  
W.O.: 20-0001

**CWA**  
**CALDWELL WHITE ASSOCIATES**  
ENGINEERS / SURVEYORS / PLANNERS  
4203 MELROSE AVENUE, N.W. P.O. BOX 6260  
ROANOKE, VIRGINIA 24017-0260  
Telephone: (540) 366-5400 Fax: (540) 366-5702  
E-Mail: cwaroanoke@aol.com