


NORTH  
MEAN OF HAMMOCK FIFTH  
SUBDIVISION RECORDED IN M.B. 1, P. 407

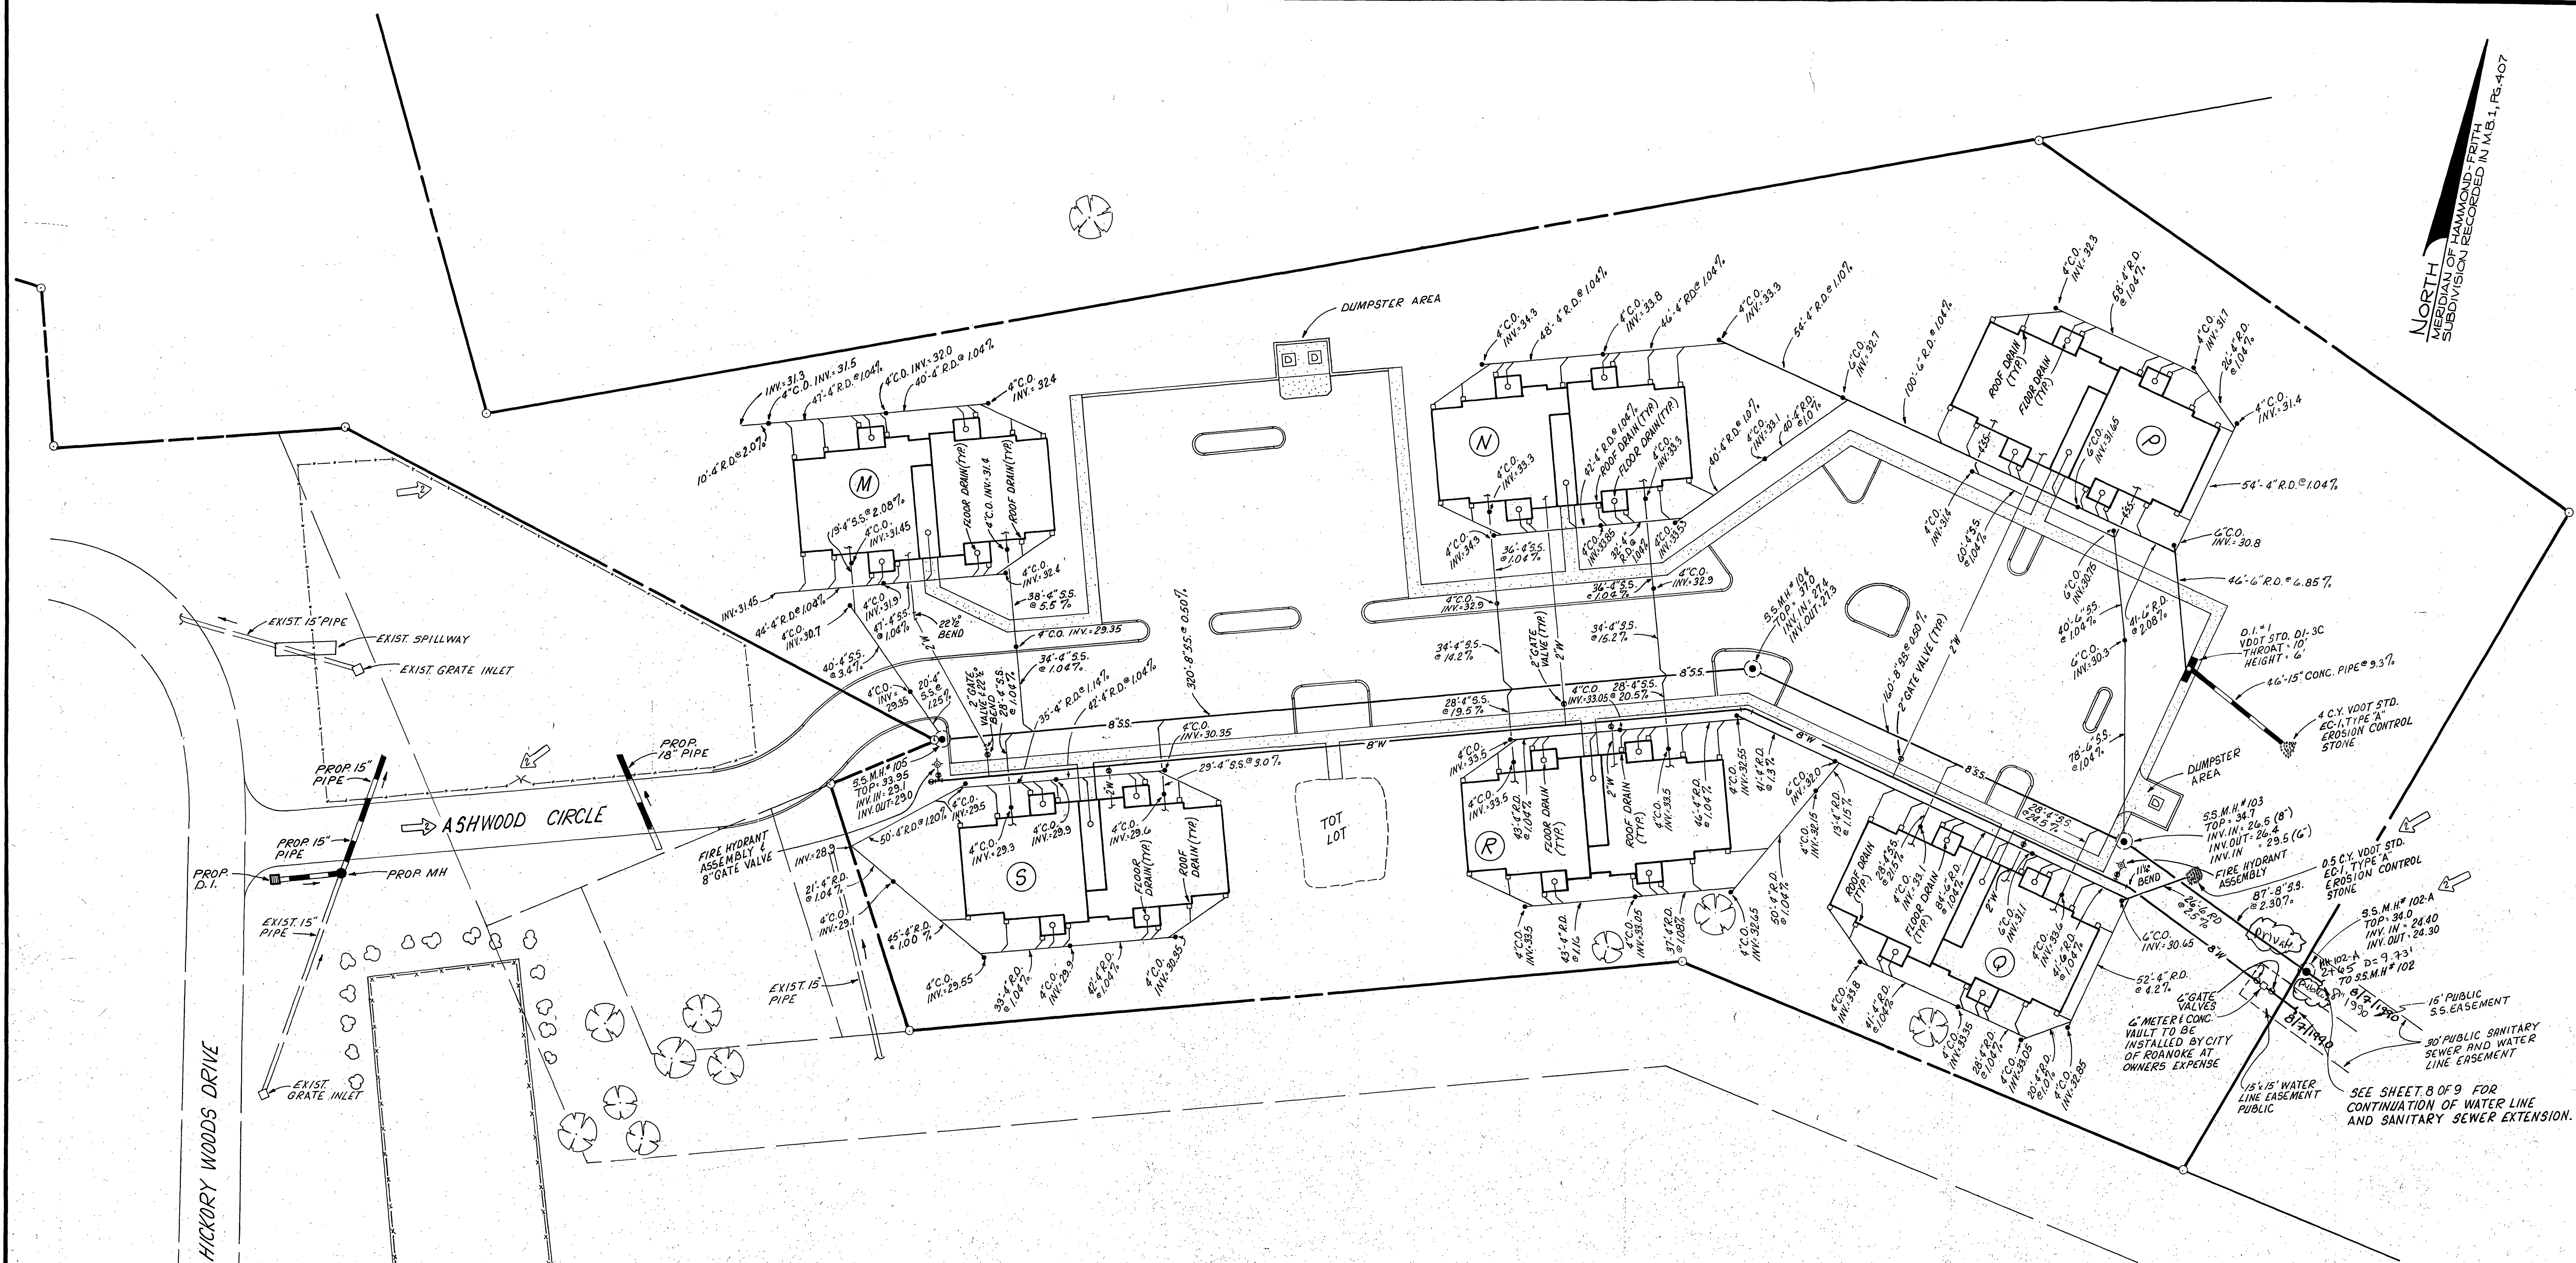

NOTE: ROOF DRAIN PIPES SHALL  
BE CONSTRUCTED USING  
P.V.C. SCHEDULE 40 PIPE


As-Built 8/7/1990

**UTILITY PLAN**  
FOR  
**HICKORY WOODS, PHASE II**

CITY OF ROANOKE, VIRGINIA

SCALE: 1"=30'

OCT. 13, 1989

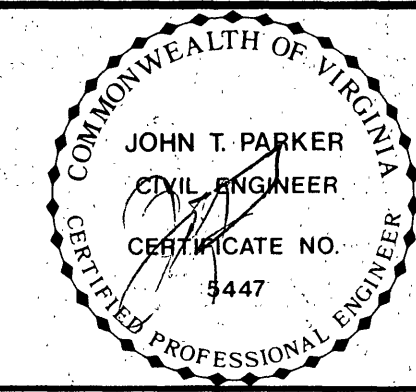

| REVISIONS |                                       |             |
|-----------|---------------------------------------|-------------|
| DATE      | BY                                    | DESIGNED BY |
| 11-20-89  | PER CITY ROANOKE EROSION CONTROL ONLY | JVP         |
| 12-18-89  | PER CITY SITE PLAN COMMENT            | JD          |

|            |         |
|------------|---------|
| DRAWN BY   | MW, JD  |
| CHECKED BY |         |
| W.O. #     | 89-1238 |
| N.B.       | H.W. #4 |
| TAX #      | 7090501 |

**T. P. PARKER & SON**  
engineers & surveyors, ltd.

TELEPHONE (703) 387-1153  
P.O. BOX 39, SALEM, VIRGINIA 24153