


BOARD OF COUNTY SUPERVISORS

ROANOKE COUNTY, VIRGINIA

PROJECT NO. 81-2-W

SCHEDULE OF DRAWING'S

SHEET	TITLE	STATIONS
1	COVER SHEET	
2	INDEX SHEET	
3	AERIAL PHOTO	
4	ACCESS ROAD	9+87 — 14+80
5	SUGAR LOAF MTN. RD.	19+93 — 25+30
6	SUGAR LOAF MTN. RD.	25+30 — 36+95
	DETAIL SHEET	

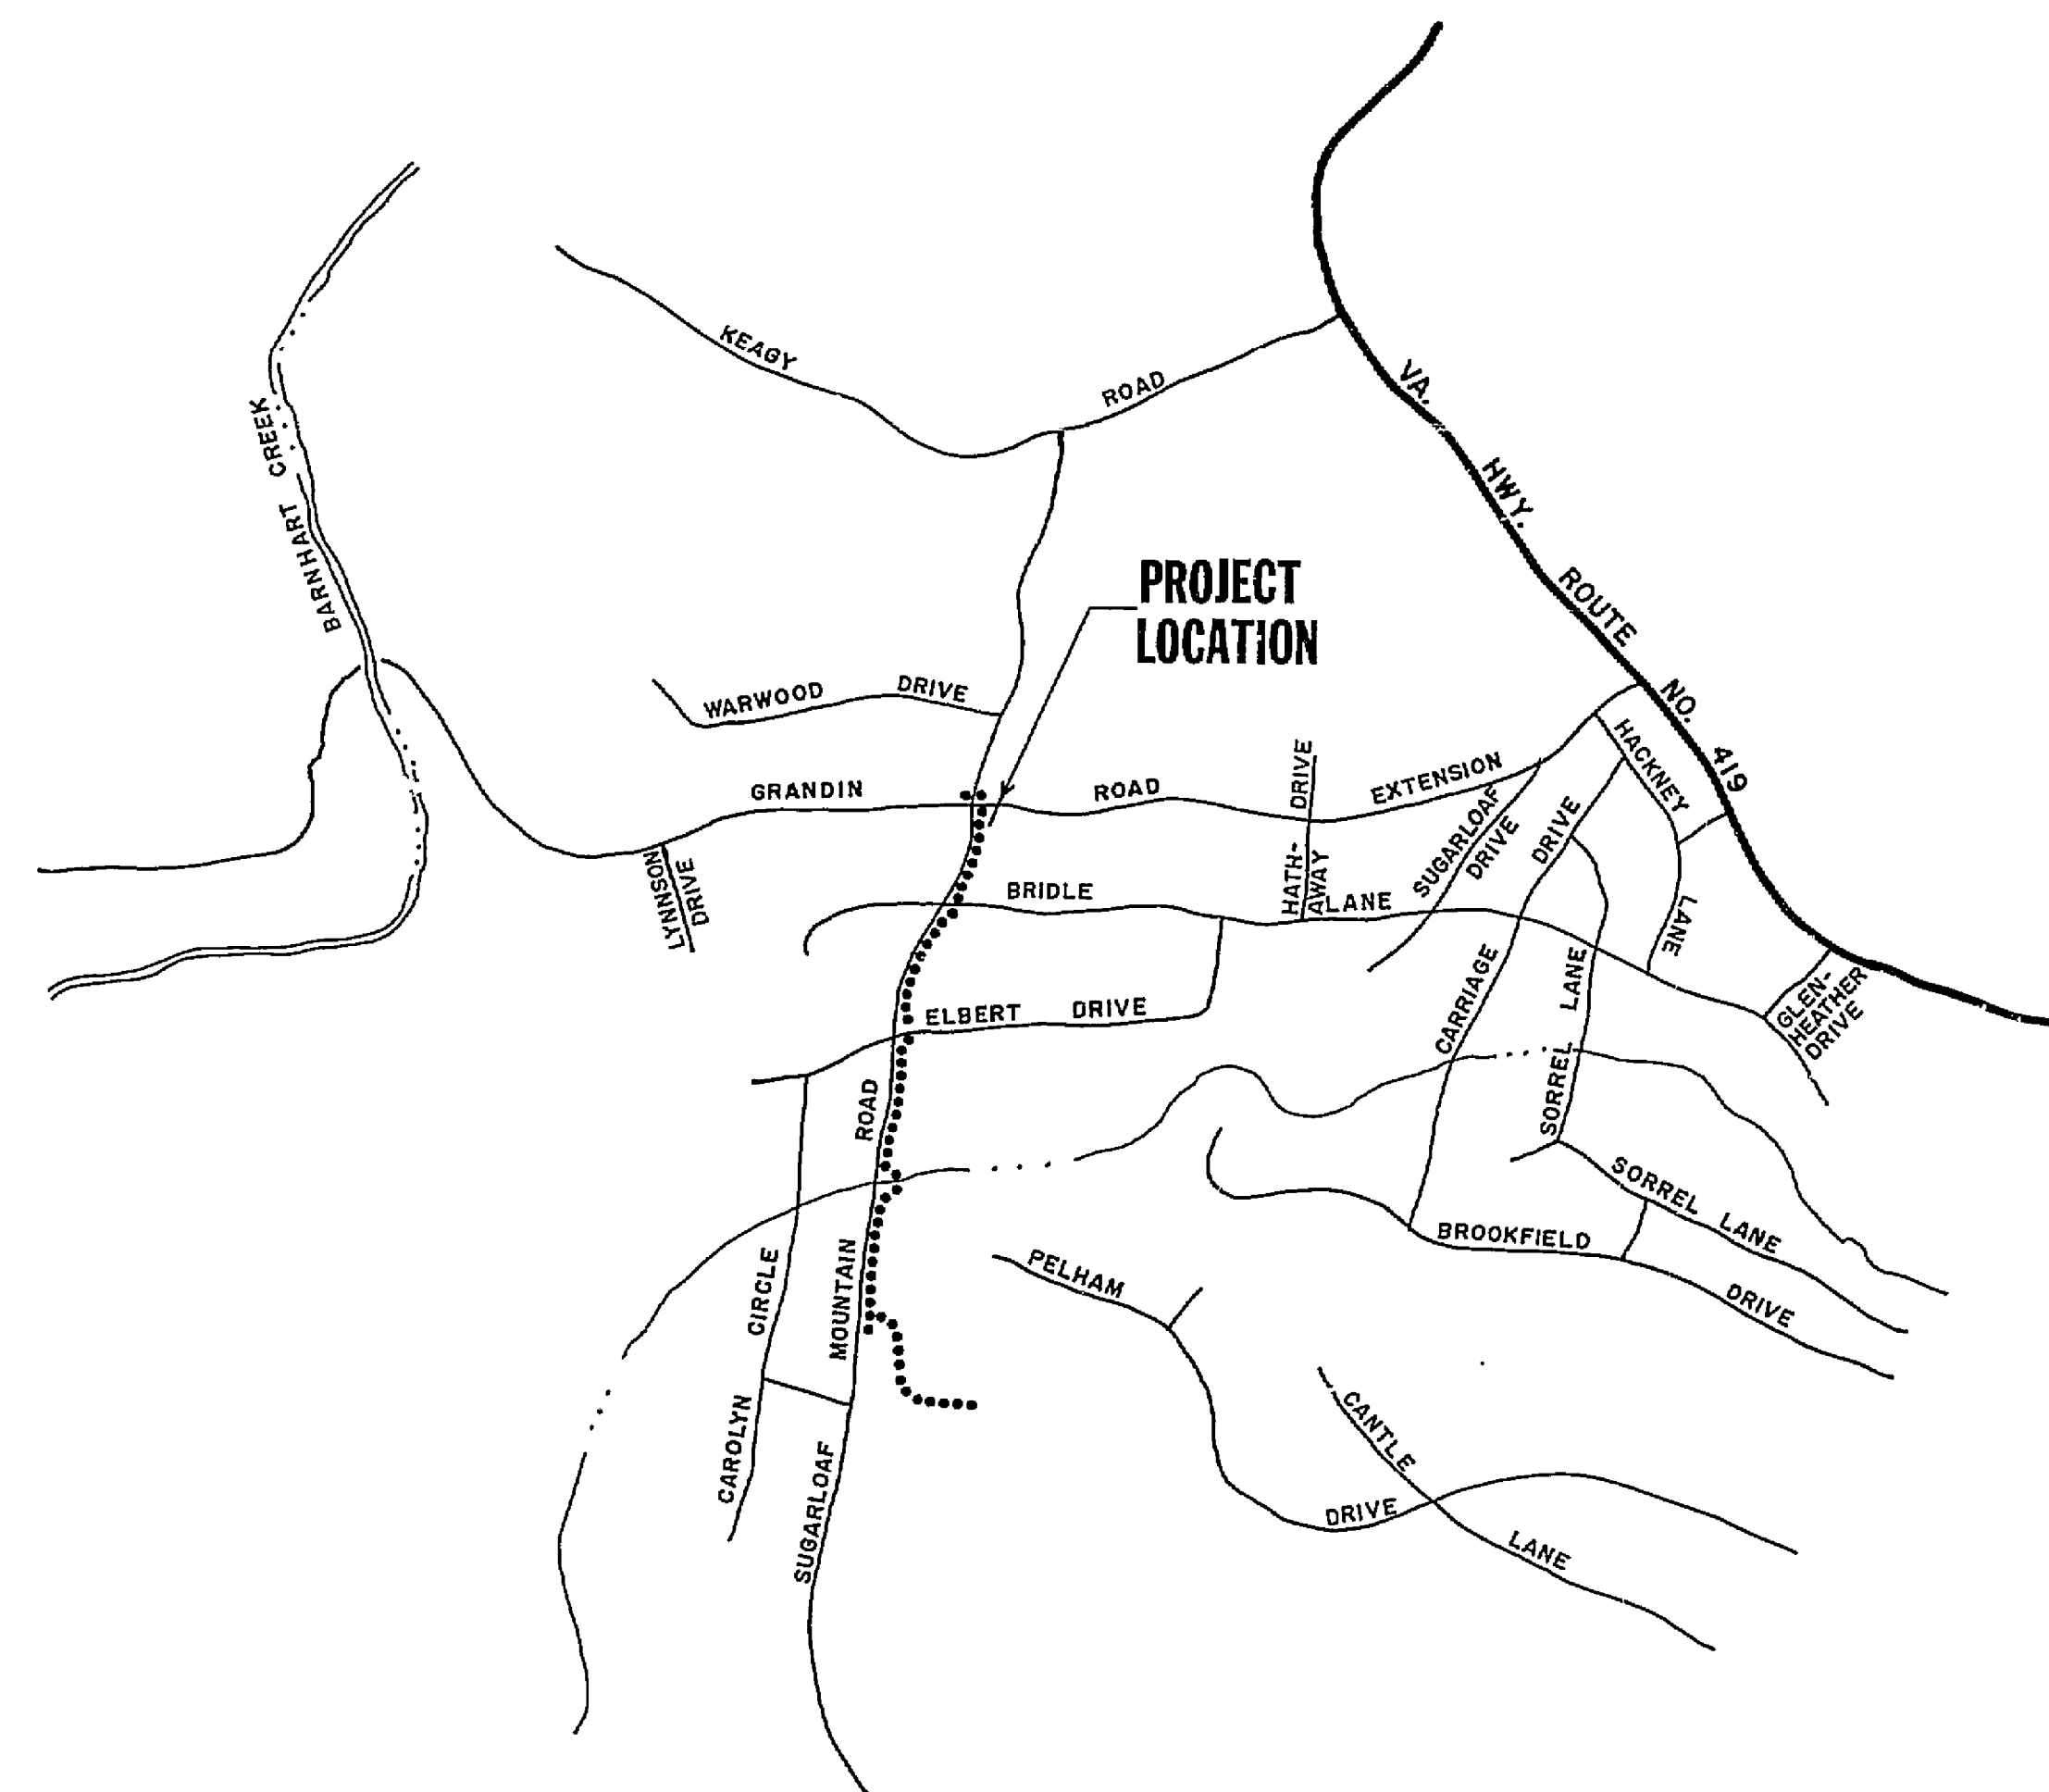

BOARD MEMBERS

MAY W. JOHNSON
ATHENA E. BURTON
ROBERT E. MEYERS
EDWARD C. PARK JR.
GARY J. MINTER

AS-BUILT

WATER FACILITY IMPROVEMENTS

HIDDEN VALLEY TRANSMISSION MAIN

MARCH 1981

