


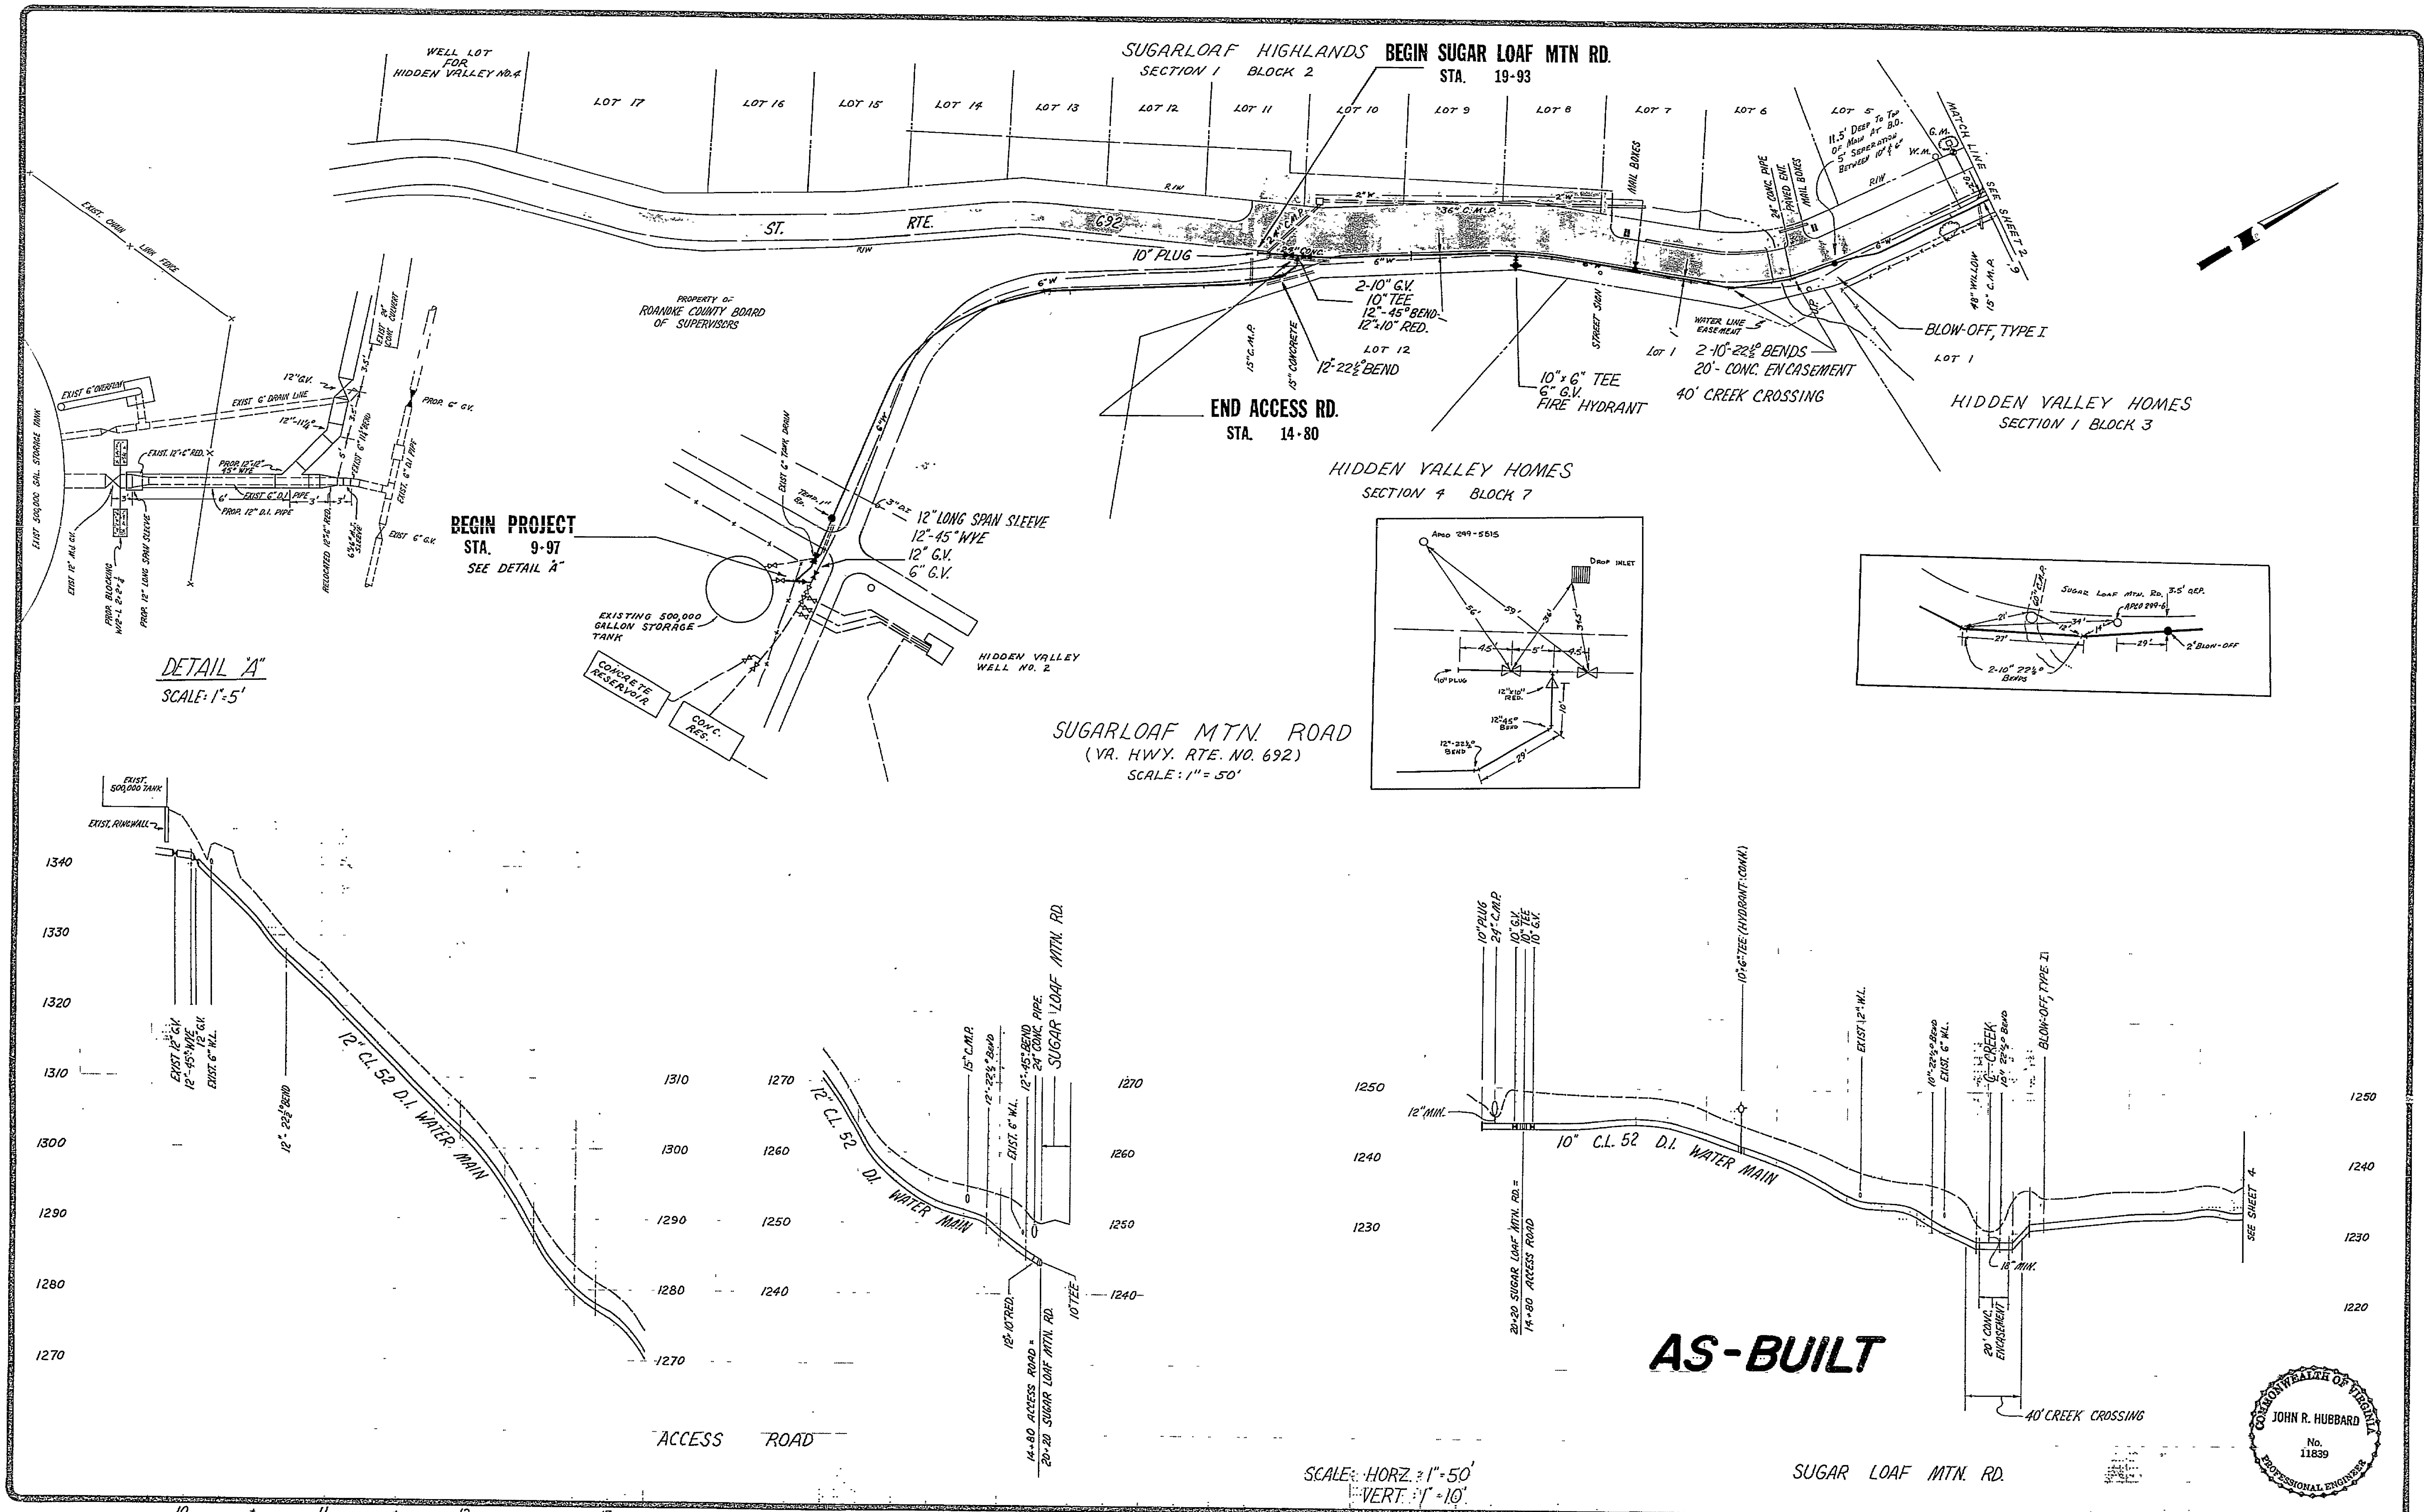

DETAIL 'A'
SCALE: 1" = 5'

BEGIN PROJECT
STA. 9-97
SEE DETAIL 'A'

END ACCESS RD.
STA. 14-80

HIDDEN VALLEY HOMES
SECTION 4 BLOCK 7

SUGARLOAF MTN. ROAD
(VA. HWY. RTE. NO. 692)
SCALE: 1" = 50'

AS-BUILT

SCALE: HORIZ. 1" = 50'
VERT. 1" = 10'

SUGAR LOAF MTN. RD.



**ROANOKE COUNTY
UTILITY DEPARTMENT**

NO.	REVISIONS	DATE

HIDDEN VALLEY TRANSMISSION MAIN

81-2-W

DATE:	MARCH 1, 1981
SCALE:	HORIZ. 1" = 50' VERT. 1" = 10'
DRAWING BY:	M.A.G.
DESIGNED BY:	M.S.W.
APPROVED BY:	J.R.H.

PLAN & PROFILE

SHEET

4

OF

6

