


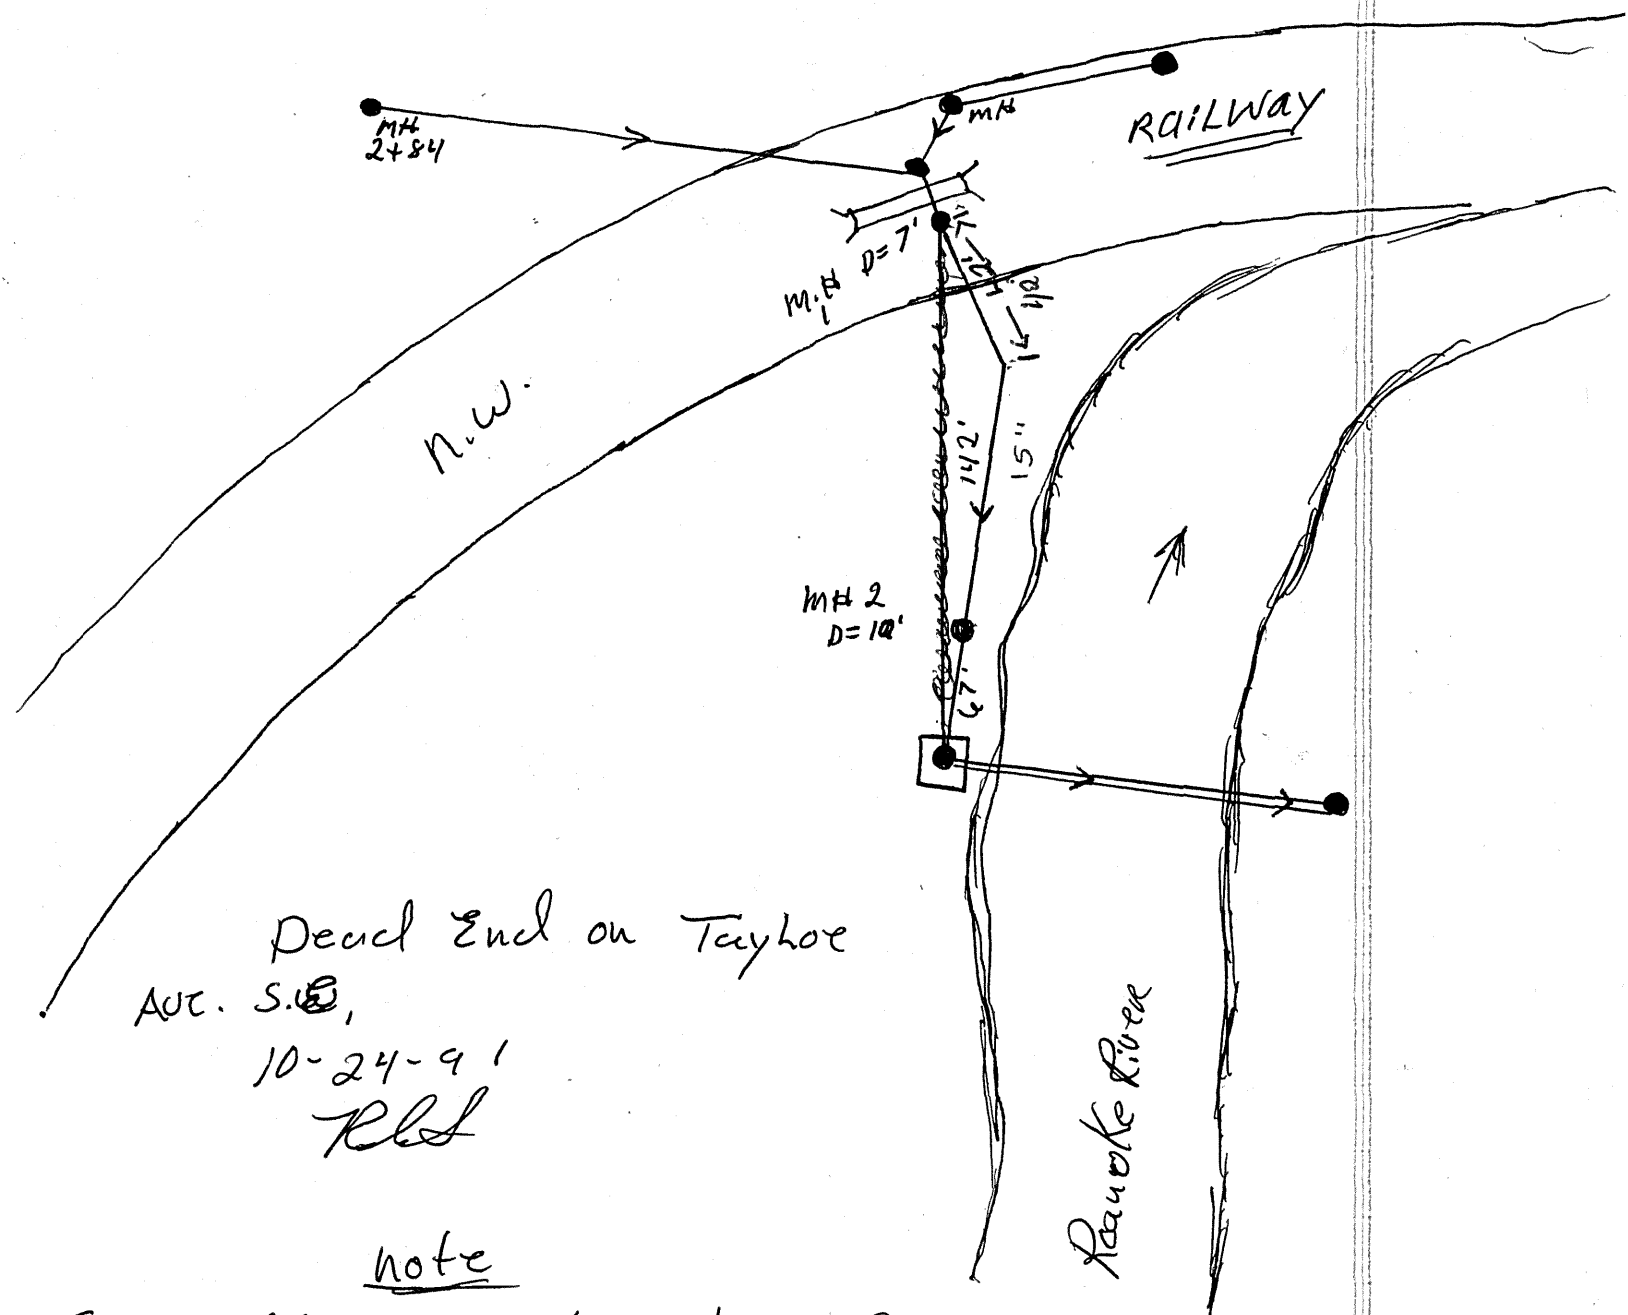

note

Sewer Main is 12' East of ~~of~~
 where Sewer Lines up from M.H. to M.H.
 42' Down Stream to Bend in Sewer main
 142' Between M.H. 1 and M.H. 2.

#423