
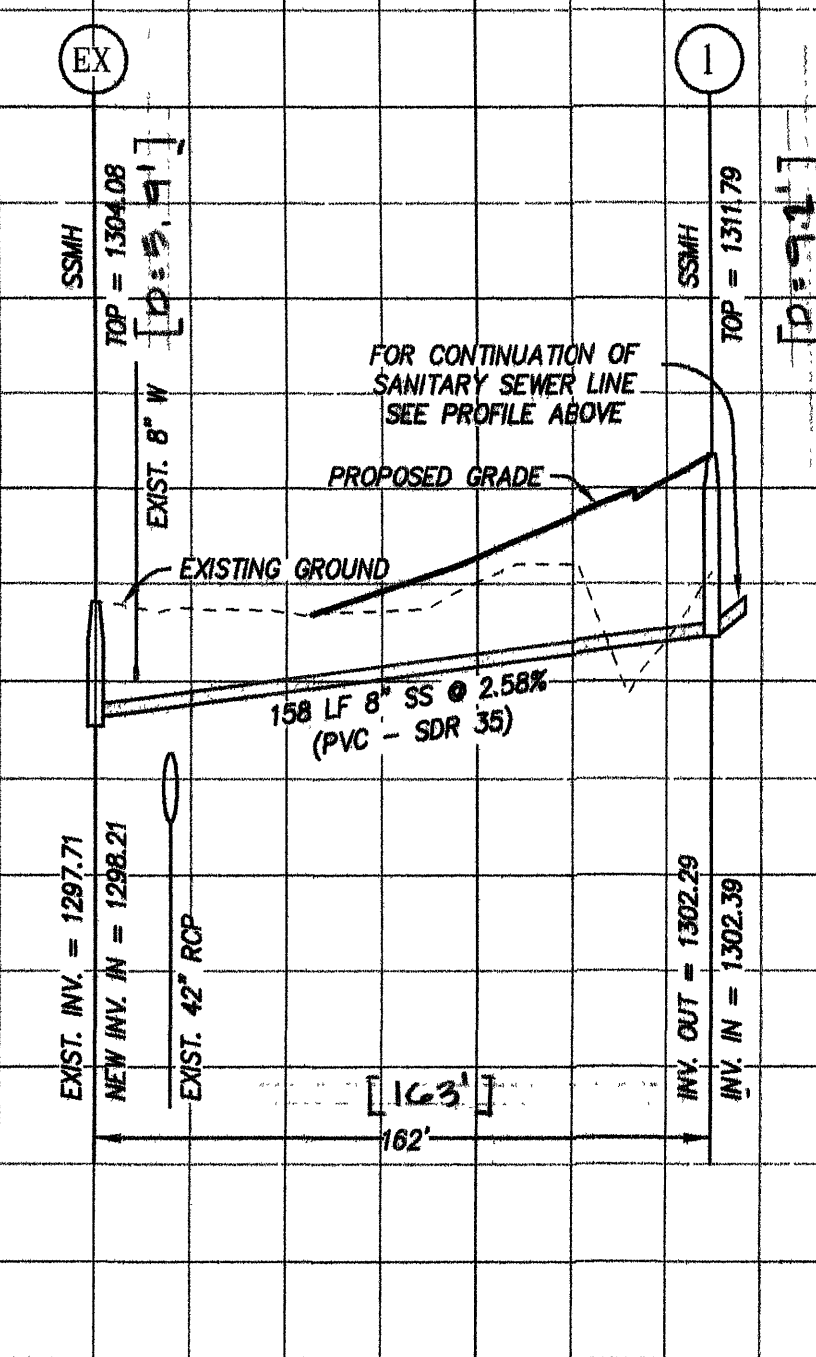



[illegible]

WATER LINE PROFILE

SANITARY SEWER PROFILE

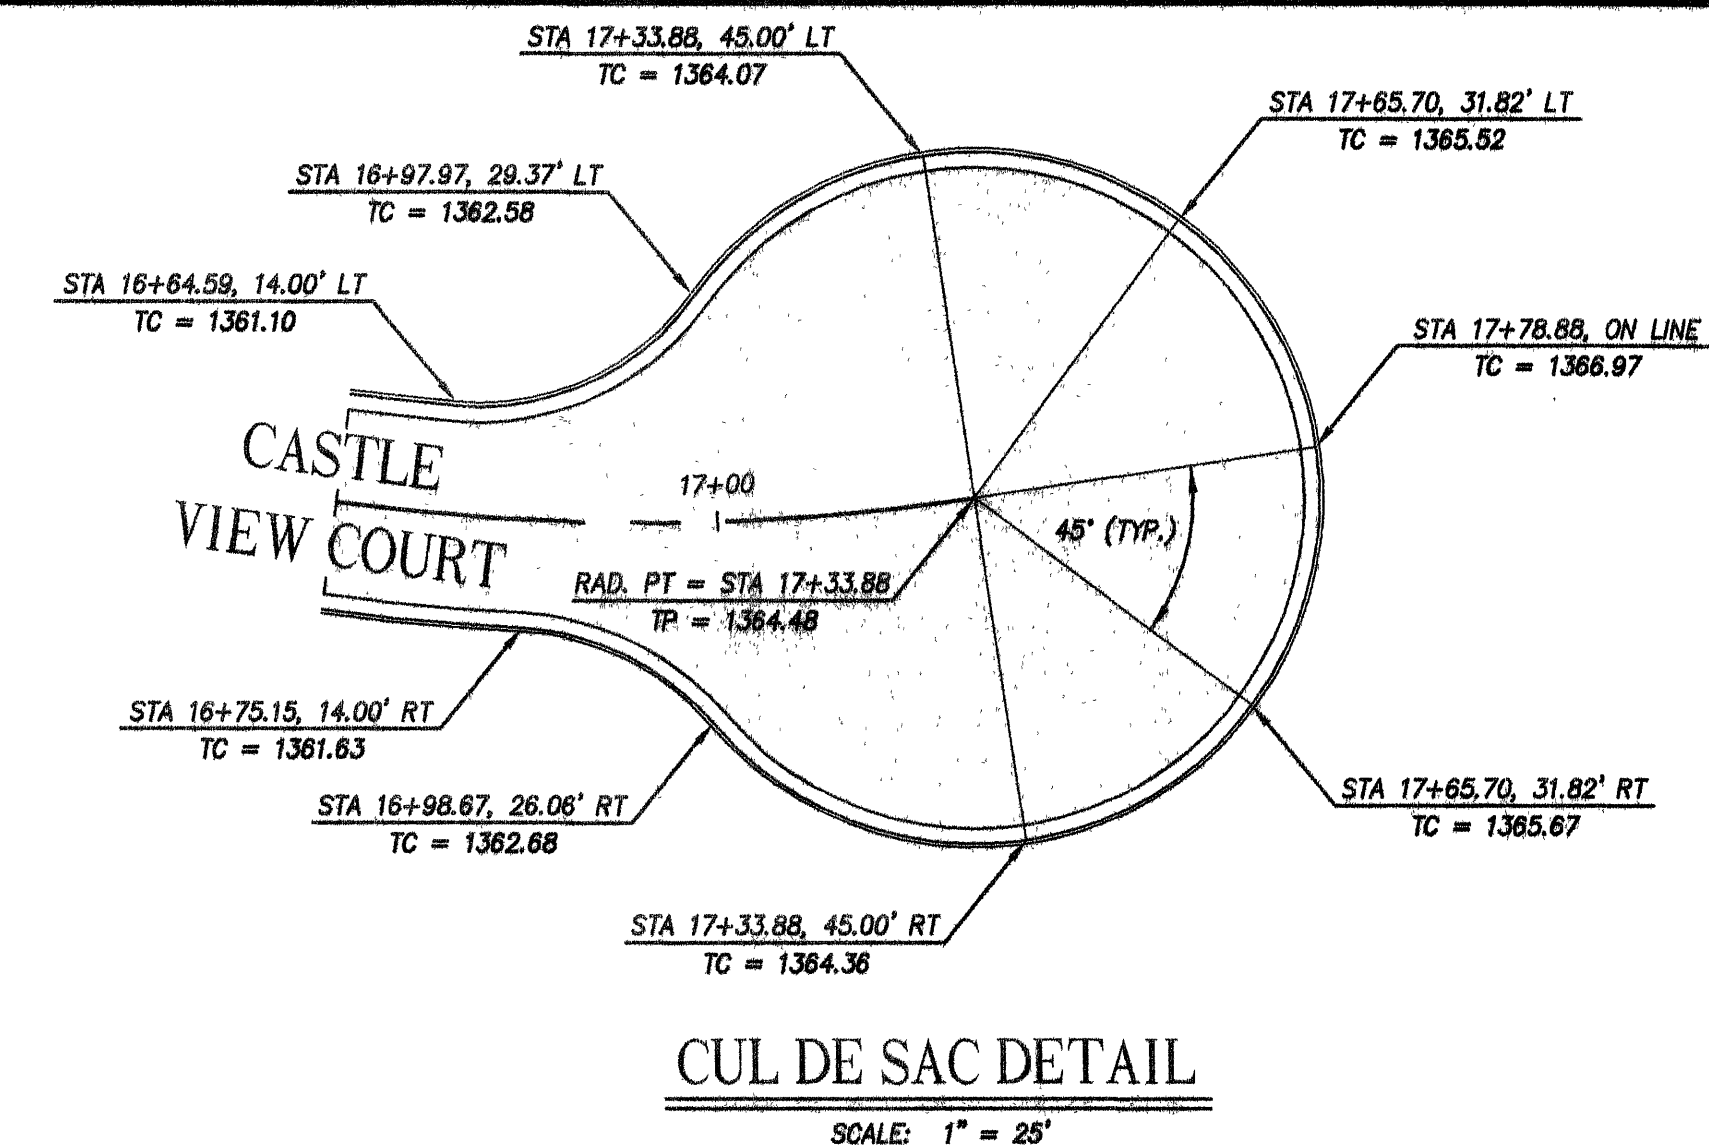

CUL DE SAC DETAIL

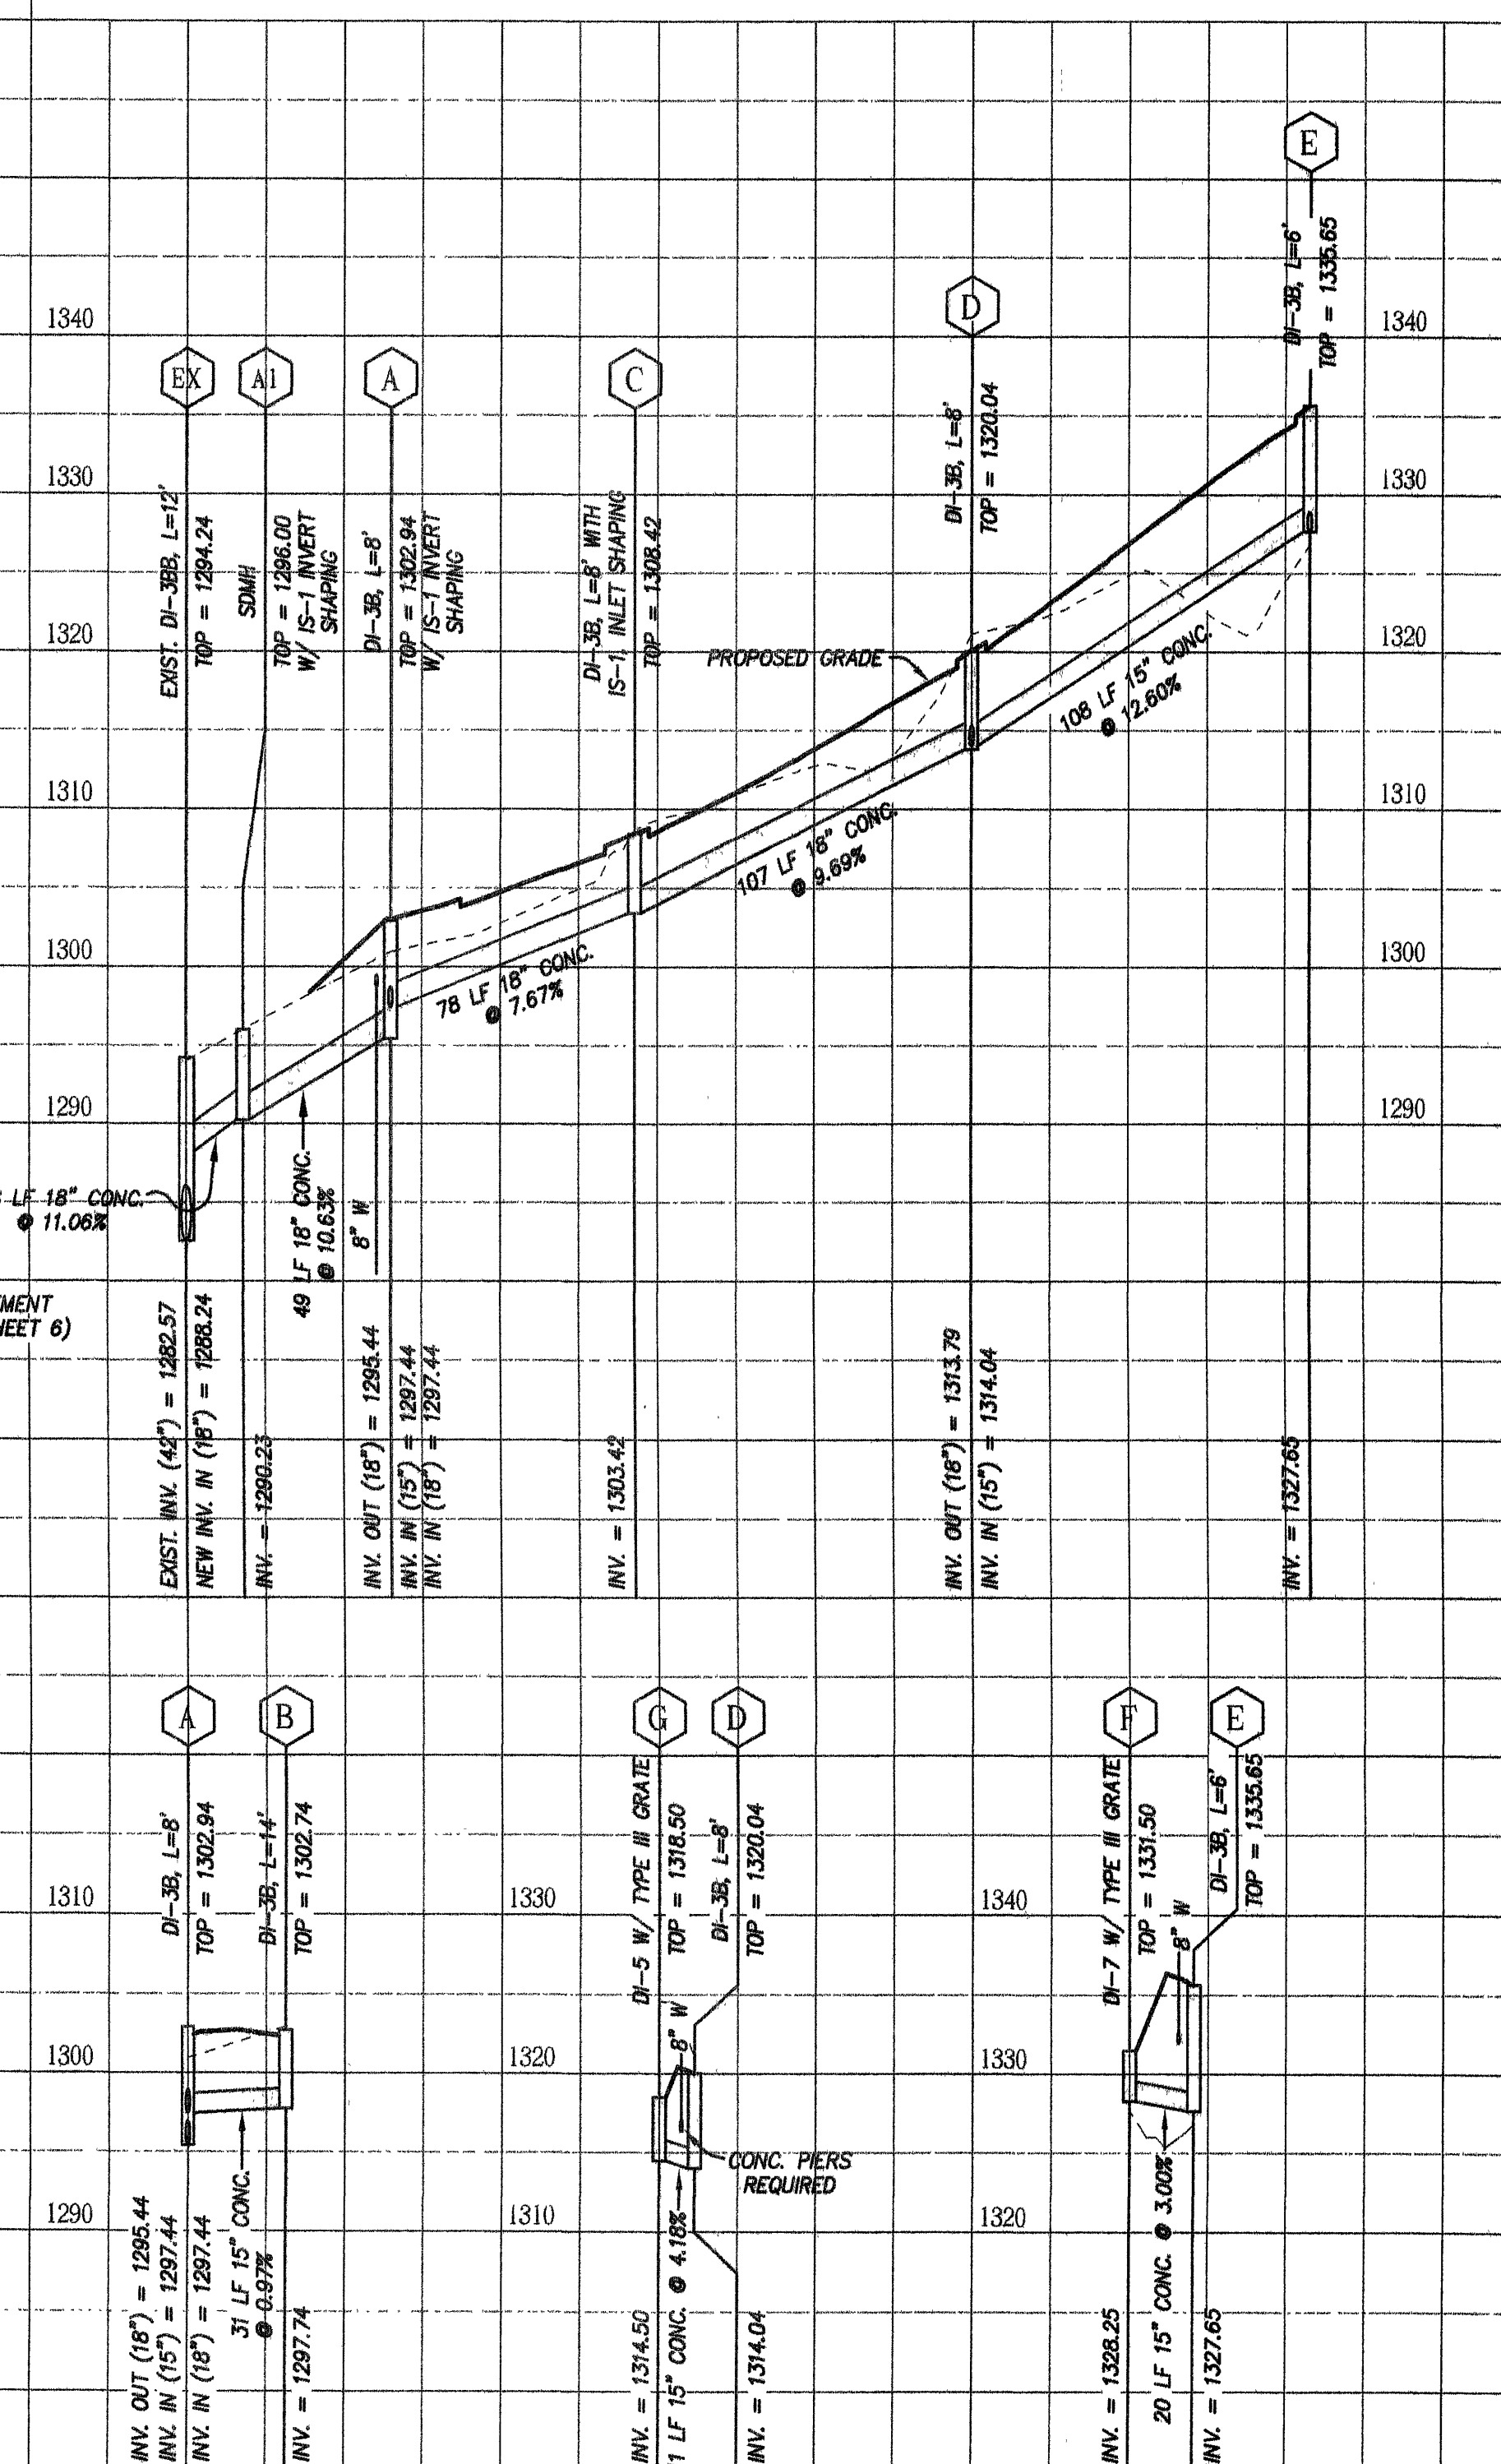


STORM DRAIN PROFILES


LUMSDEN ASSOCIATES, P.C.
ENGINEERS-SURVEYORS-PLANNERS
ROANOKE, VIRGINIA

PHONE: (540) 774-4411
FAX: (540) 772-9445
E-MAIL: MAIL@LUMSDENPC.COM

4078

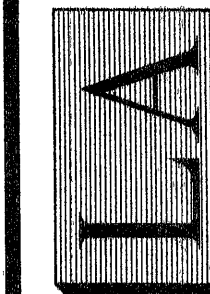

4664 BRAMBLETON AVENUE
P.O. BOX 20669
ROANOKE, VIRGINIA 24018
PHONE: (540) 774-4411
FAX: (540) 772-9445
E-MAIL: MAIL@LUMSDENPC.COM

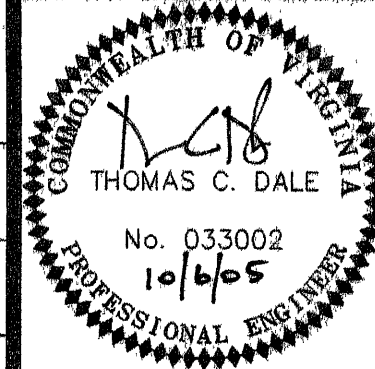

PROFILES

"THE HILLS AT CASTLE ROCK"
PREPARED FOR
PARK PLACE DEVELOPERS, INC.
WINDSOR HILLS MAGISTERIAL DISTRICT
ROANOKE COUNTY, VIRGINIA

REVISIONS		DESCRIPTION
NO.	DATE	
1	7/18/05	COUNTY COMMENTS AND REWSE TO ZERO LOT LINE SUBDIVISION
2	10/16/05	REVISED STORMSEWER SYSTEM FROM EX TO A
3	10/19/05	WATER & SANI SLAK AS-BUILT
4		
5		

DATE: JUNE 14, 2004

SCALE:
1"=50' (H) 1"=10' (V)

COMMISSION NO: 2002-312

SHEET 7 OF 11