

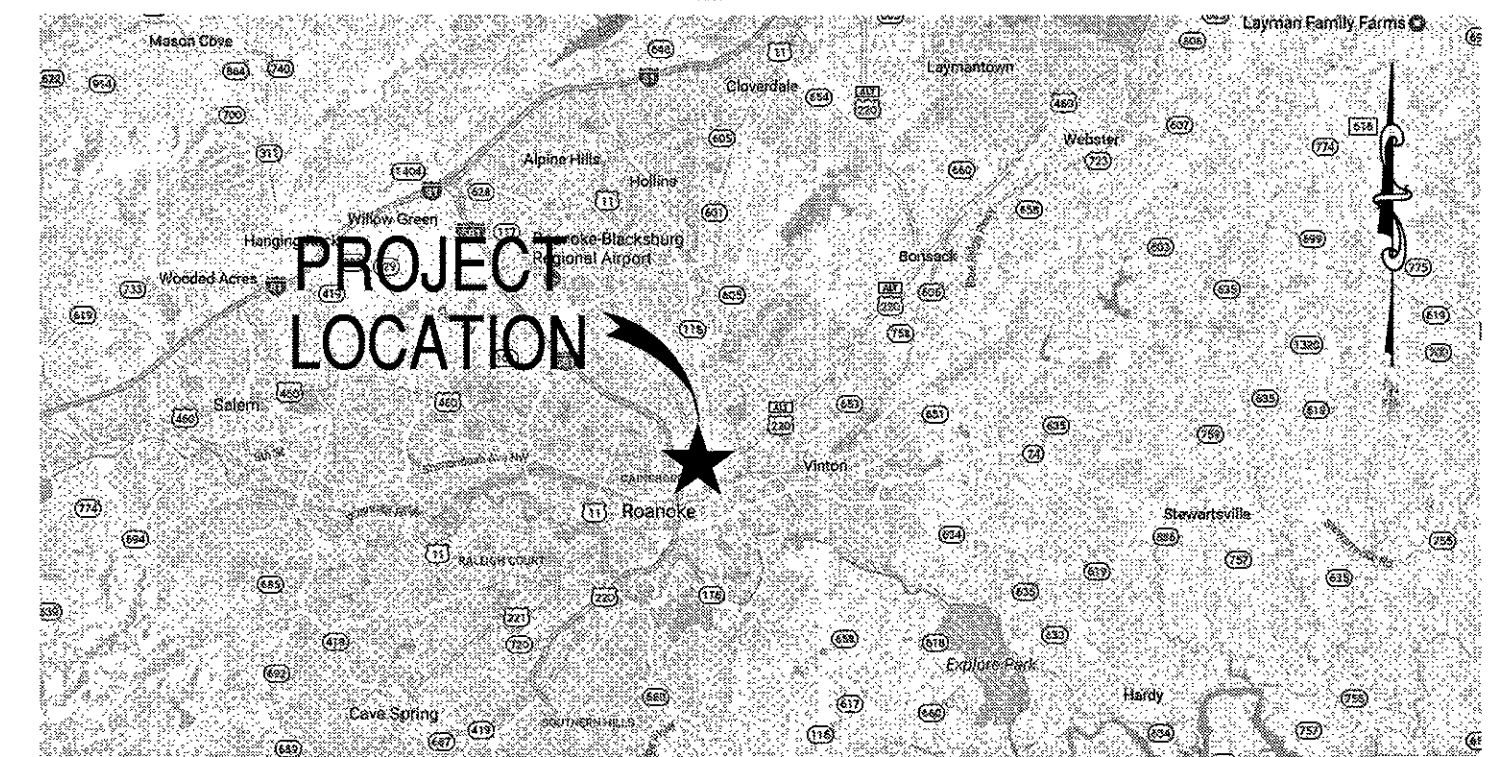


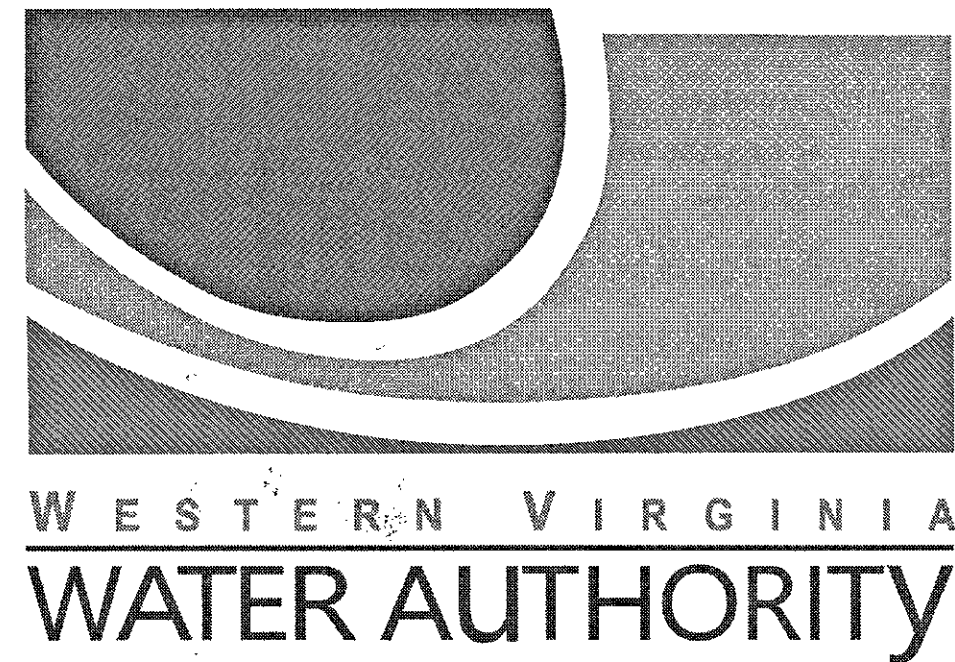

LOCATION PLAN
NO SCALE

WESTERN VIRGINIA WATER AUTHORITY HOLLINS ROAD WATER MAIN REPLACEMENT - PHASE 2

SHEET	TITLE
1.	COVER
2.	GENERAL NOTES, PROPOSED LEGEND, & SUGGESTED SEQUENCE OF CONSTRUCTION
3.	SURVEY SCHEDULES, NOTES, & EXISTING LEGEND
4.	SHEET LAYOUT
5.	PLAN - PROFILE, STA. 9+90 TO STA. 14+62
6.	PLAN - PROFILE, STA. 14+62 TO STA. 20+13
7.	PLAN - PROFILE, STA. 20+13 TO STA. 25+64
8.	PLAN - PROFILE, STA. 25+64 TO STA. 31+14
9.	PLAN - PROFILE, STA. 31+14 TO STA. 36+64
10.	PLAN - PROFILE, STA. 36+64 TO STA. 42+13
11.	PLAN - PROFILE, STA. 42+13 TO STA. 46+82
12.	TEMPORARY TRAFFIC CONTROL PLAN NOTES
13.	TEMPORARY TRAFFIC CONTROL PLAN FIGURE 1
14.	TEMPORARY TRAFFIC CONTROL PLAN FIGURE 1

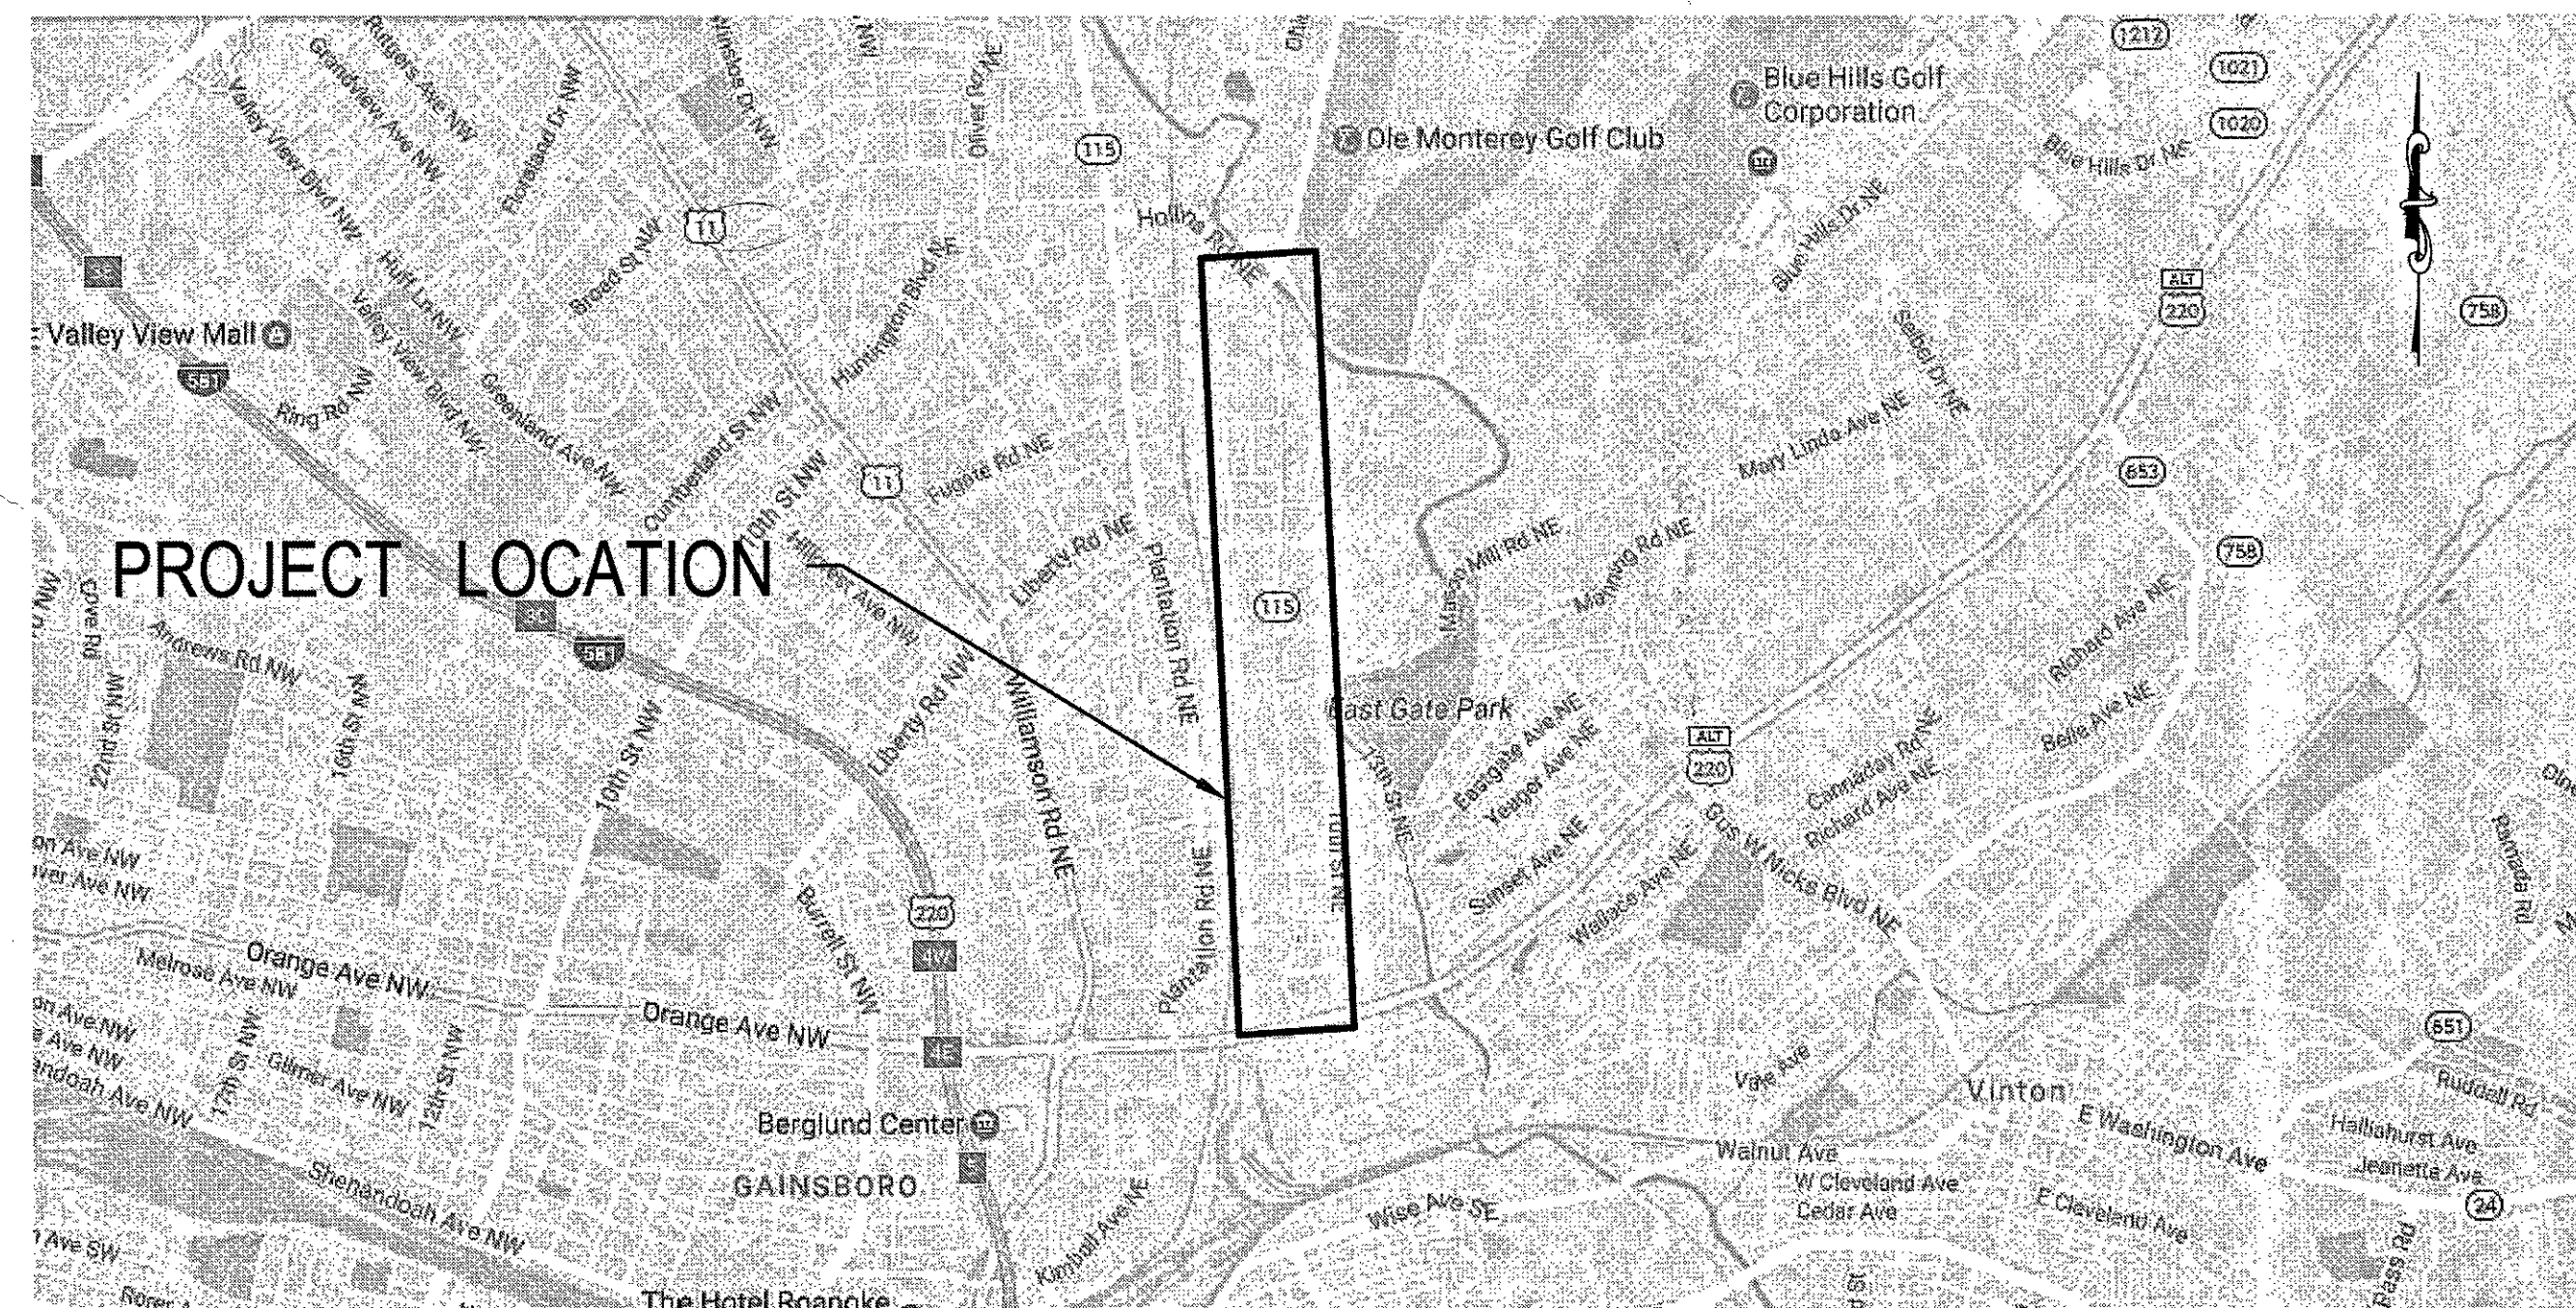

VICINITY MAPS
NO SCALE

SEPTEMBER 2017

Materials - 12" HDPE - Flying "J"
6", 8", 12" DFP - AMERICAN

Values - 6" 12" 8" - AFC Resilient Seat Gate Valves
Turns - 18, 36, 24

2" pipe - polytech
1" pipe - polytech

All DFP HAS BEEN Restrained w/ 4k Field Lok Gaskets

1-hydrant
A.D
2017
Hydrant # 11626
68 PSI

P.M. - Earl Smith

Inspector: Brian Whitenack / B. White


Contractor: Rick HAMM / Rick Hamm

Robert W. Pennington

APPROVED FOR CONSTRUCTION

REV	DATE	DESCRIPTION

DRAWING	SHEET
-	1

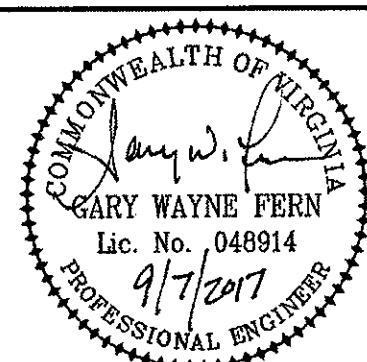

WESTERN VIRGINIA WATER AUTHORITY
601 South Jefferson Street, Suite 300
Roanoke, Virginia 24011

DES: PJM
DRAWN: JES
CHECK: GWF
DATE: 9/07/17

SCALE: N/A
HORIZ: N/A
VERT: N/A

HOLLINS ROAD WATER MAIN REPLACEMENT - PHASE 2

COVER

10/30/18 AS-Built