


DEVELOPMENT PLANS
FOR
HOLLINS ROAD WATER LINE

SITUATED IN
HOLLINS MAGISTERIAL DISTRICT
ROANOKE COUNTY, VIRGINIA

DATE: 17 JUNE 1994
"AS-BUILT" 18 AUGUST 1995
PREPARED FOR

ROANOKE COUNTY UTILITY DEPARTMENT

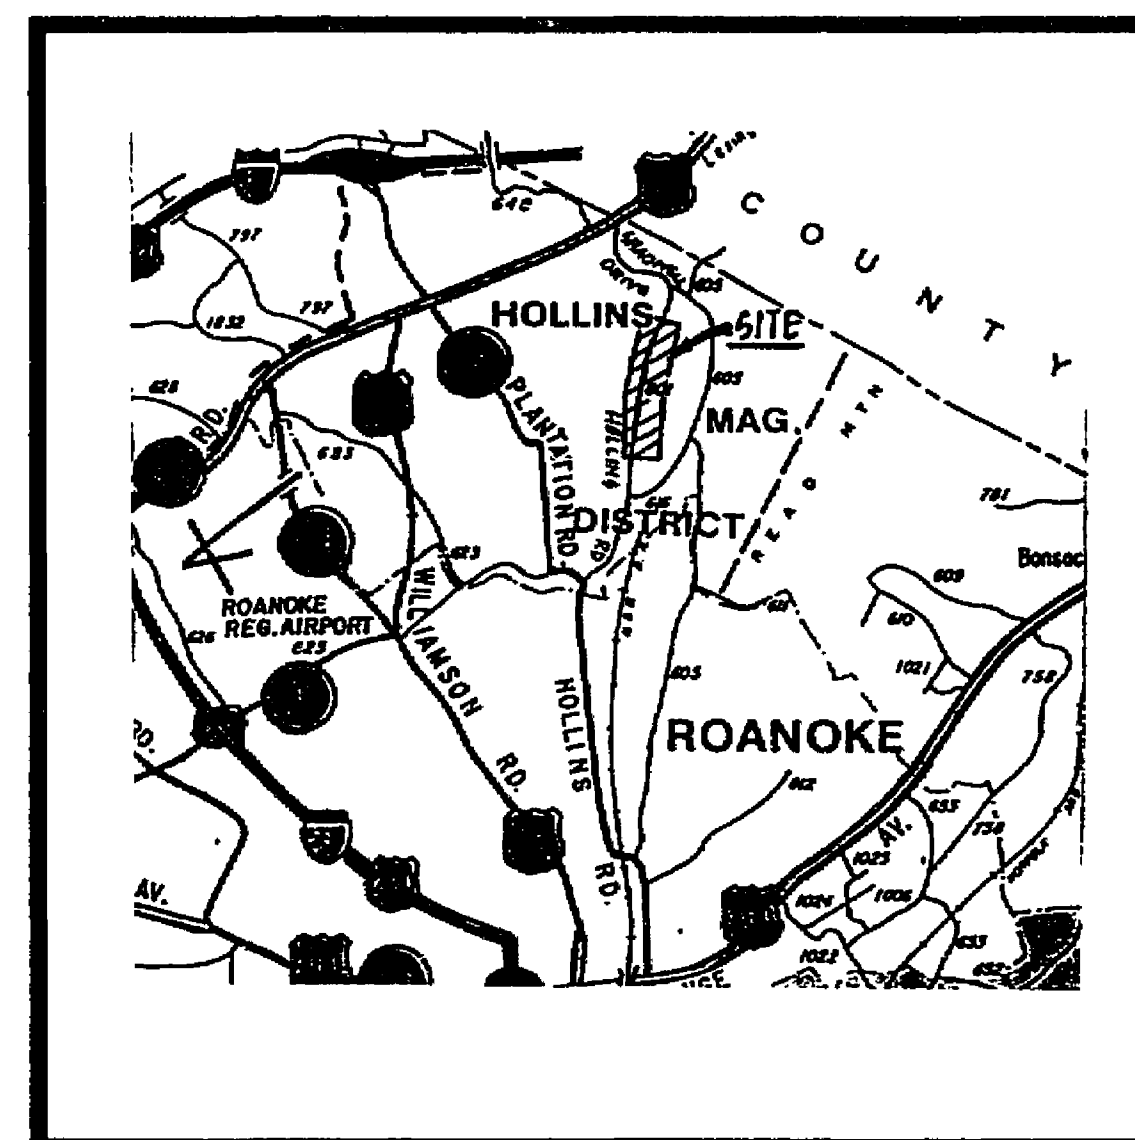

INDEX OF DRAWINGS

SHEET No.	DESCRIPTION
1.	LUMSDEN ASSOCIATES COVER SHEET
2.	PLAN & PROFILE SHEET LAYOUT
3.-7.	PLAN & PROFILE
8.	WATER DETAILS

LUMSDEN ASSOCIATES, P.C.
ENGINEERS-SURVEYORS-PLANNERS
ROANOKE, VIRGINIA

"AS-BUILT"

NOTE:

- 1) "AS-BUILT" INFORMATION TAKEN FROM
PLANS FURNISHED BY ROANOKE COUNTY
UTILITY DEPARTMENT.