
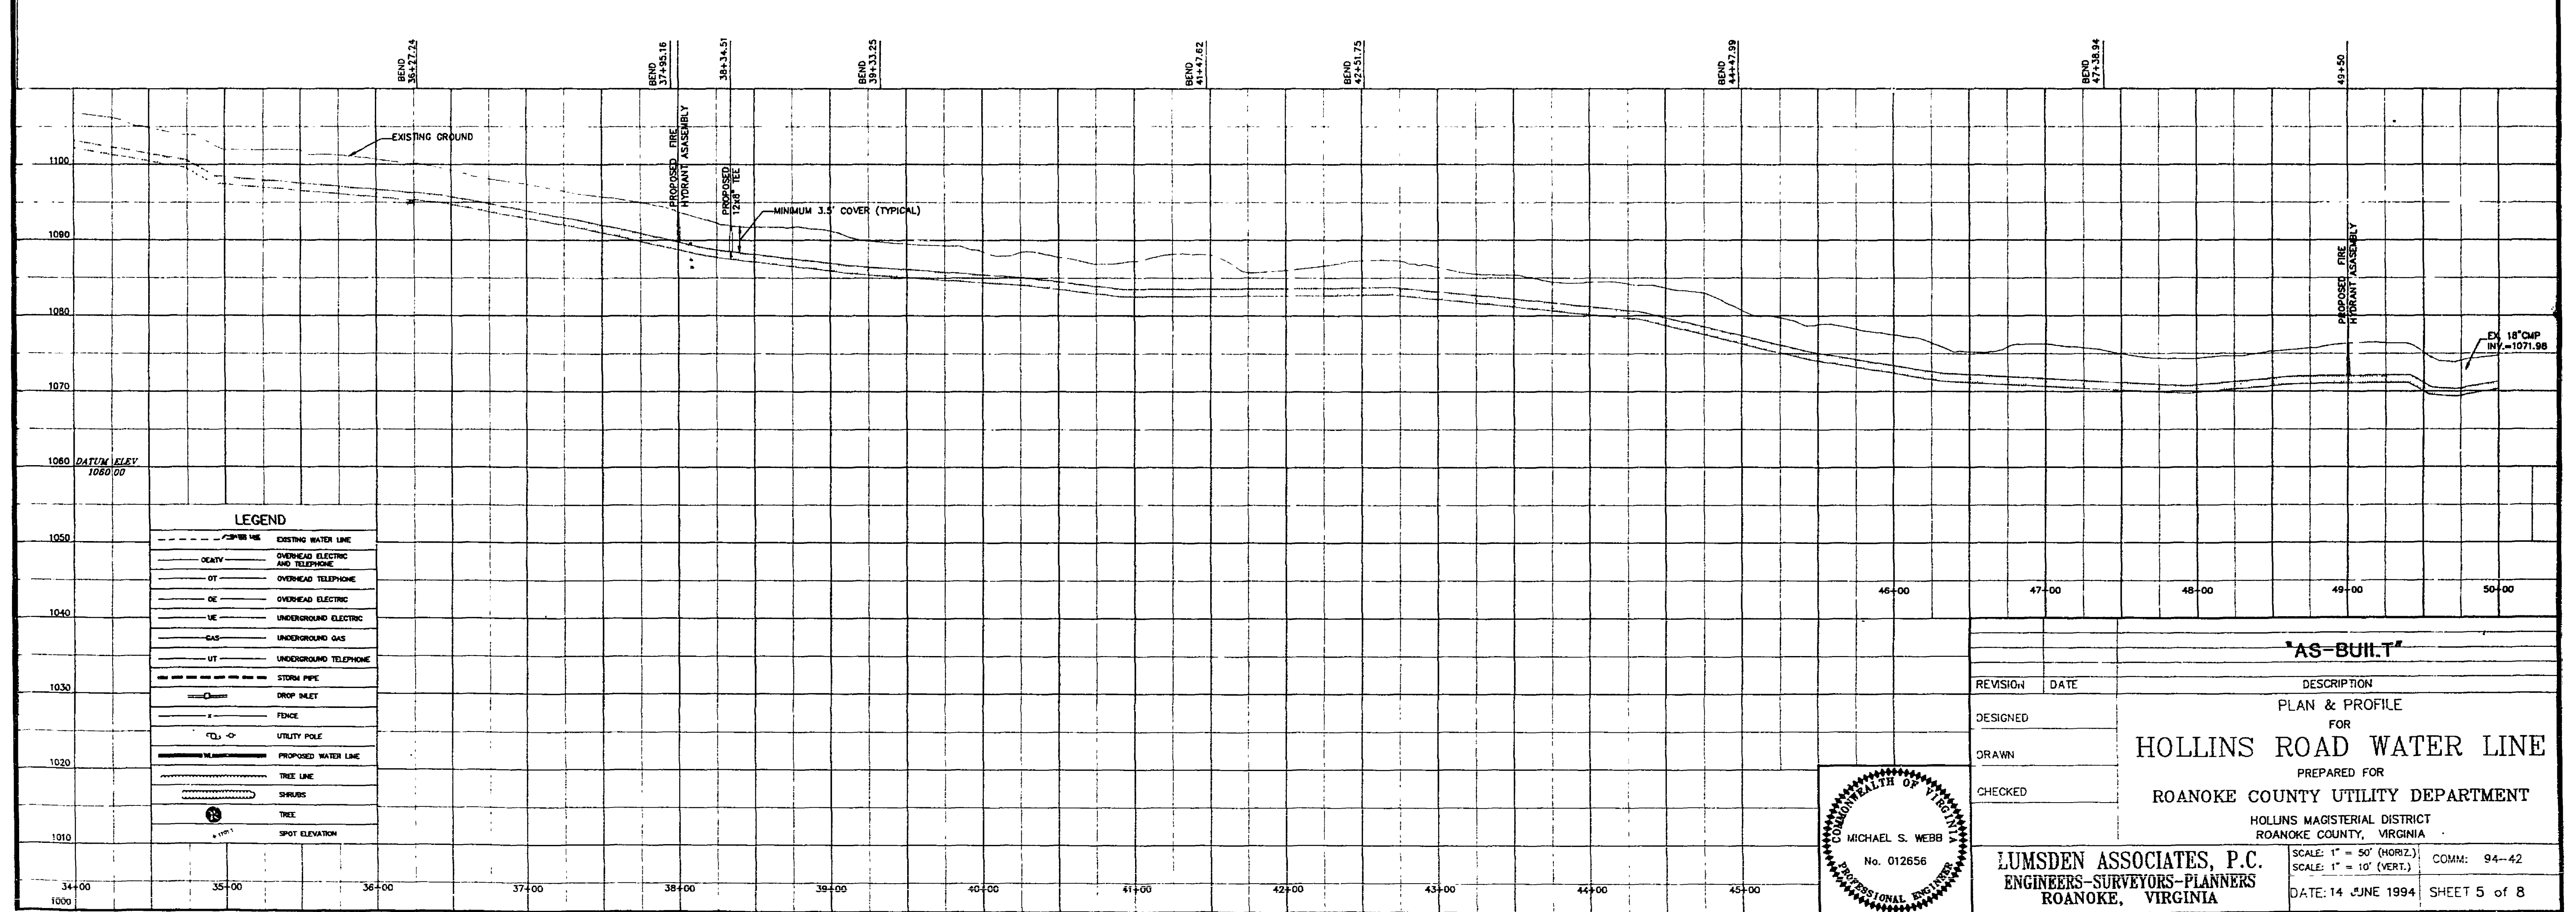


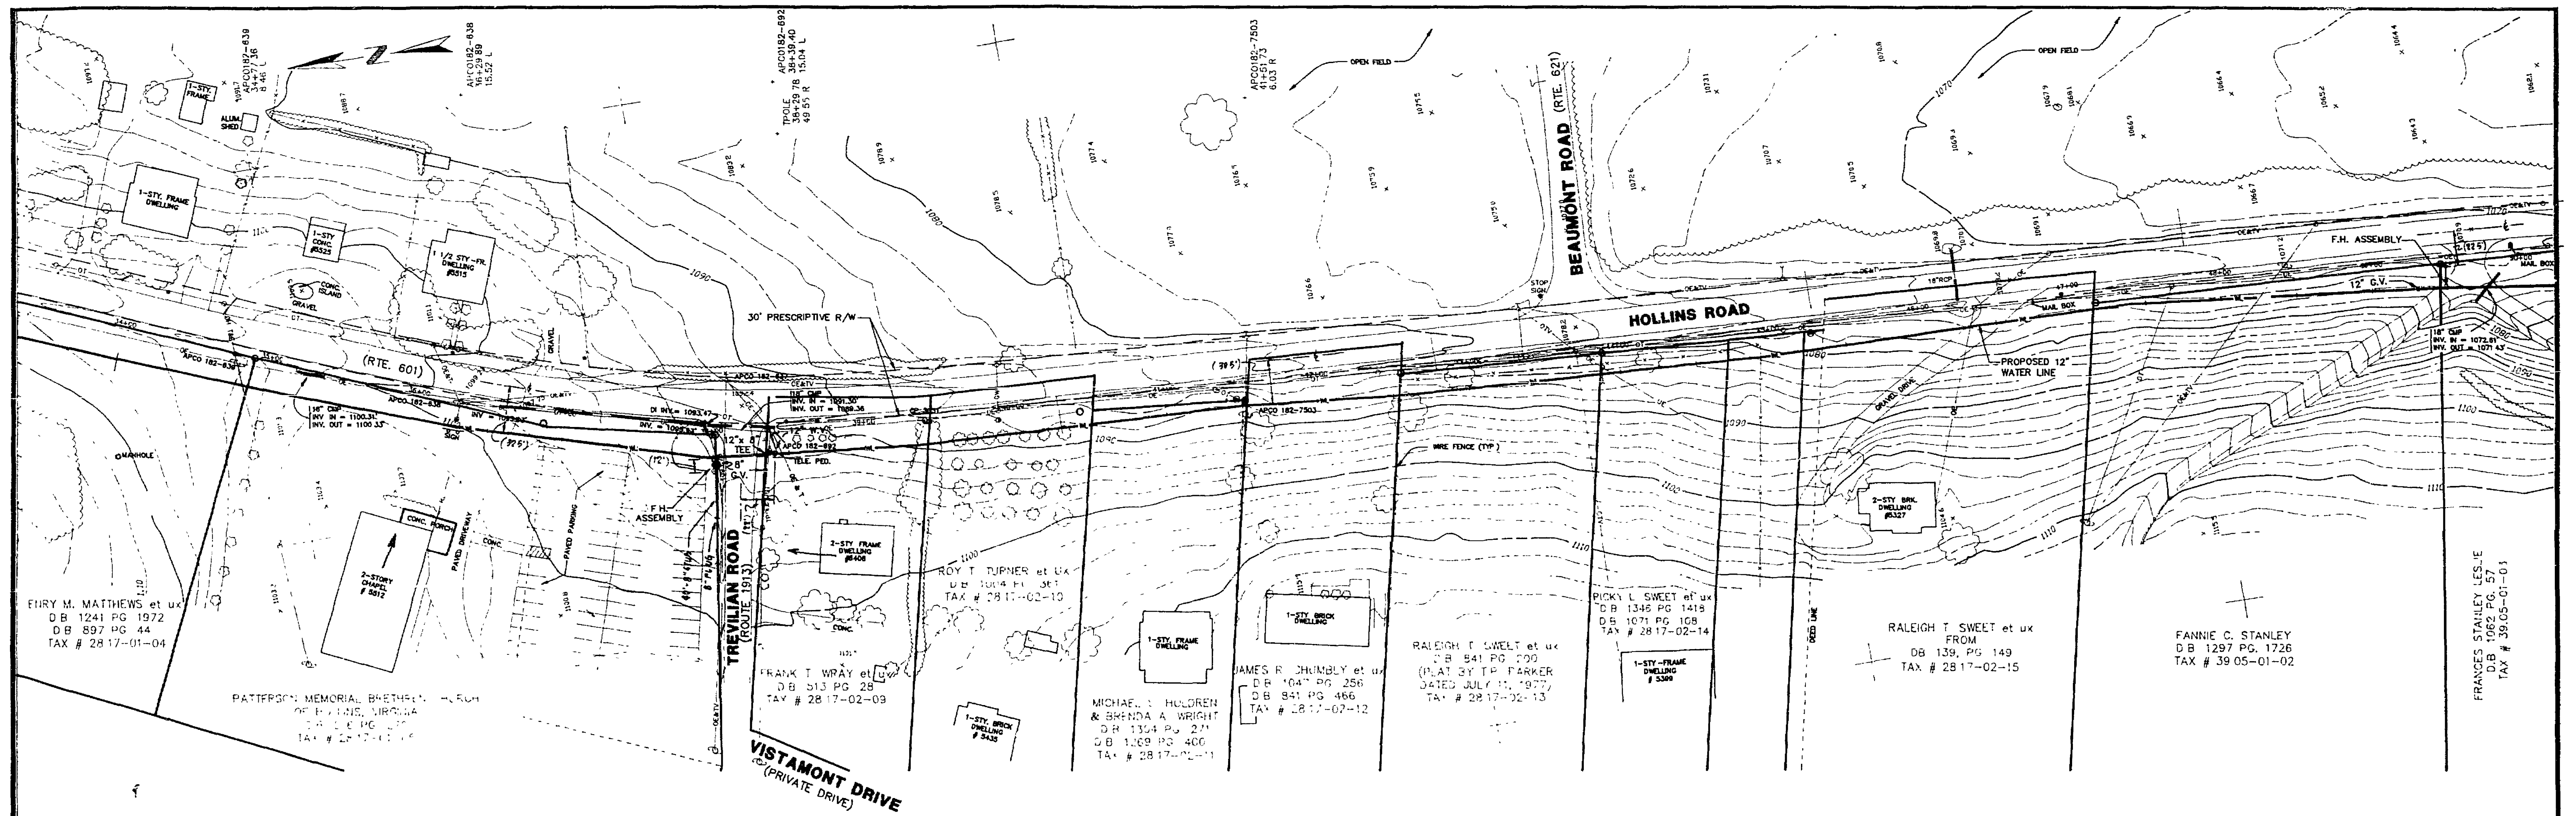

AS-BUILT

REVISION DATE DESCRIPTION

DESIGNED

DRAWN

CHECKED

HOLLINS ROAD WATER LINE

PREPARED FOR

ROANOKE COUNTY UTILITY DEPARTMENT

HOLLINS MAGISTERIAL DISTRICT

ROANOKE COUNTY, VIRGINIA

LUMSDEN ASSOCIATES, P.C.

ENGINEERS-SURVEYORS-PLANNERS

ROANOKE, VIRGINIA

SCALE: 1" = 50' (HORIZ.)

SCALE: 1" = 10' (VERT.)

DATE: 14 JUNE 1994

SHEET 5 of 8