

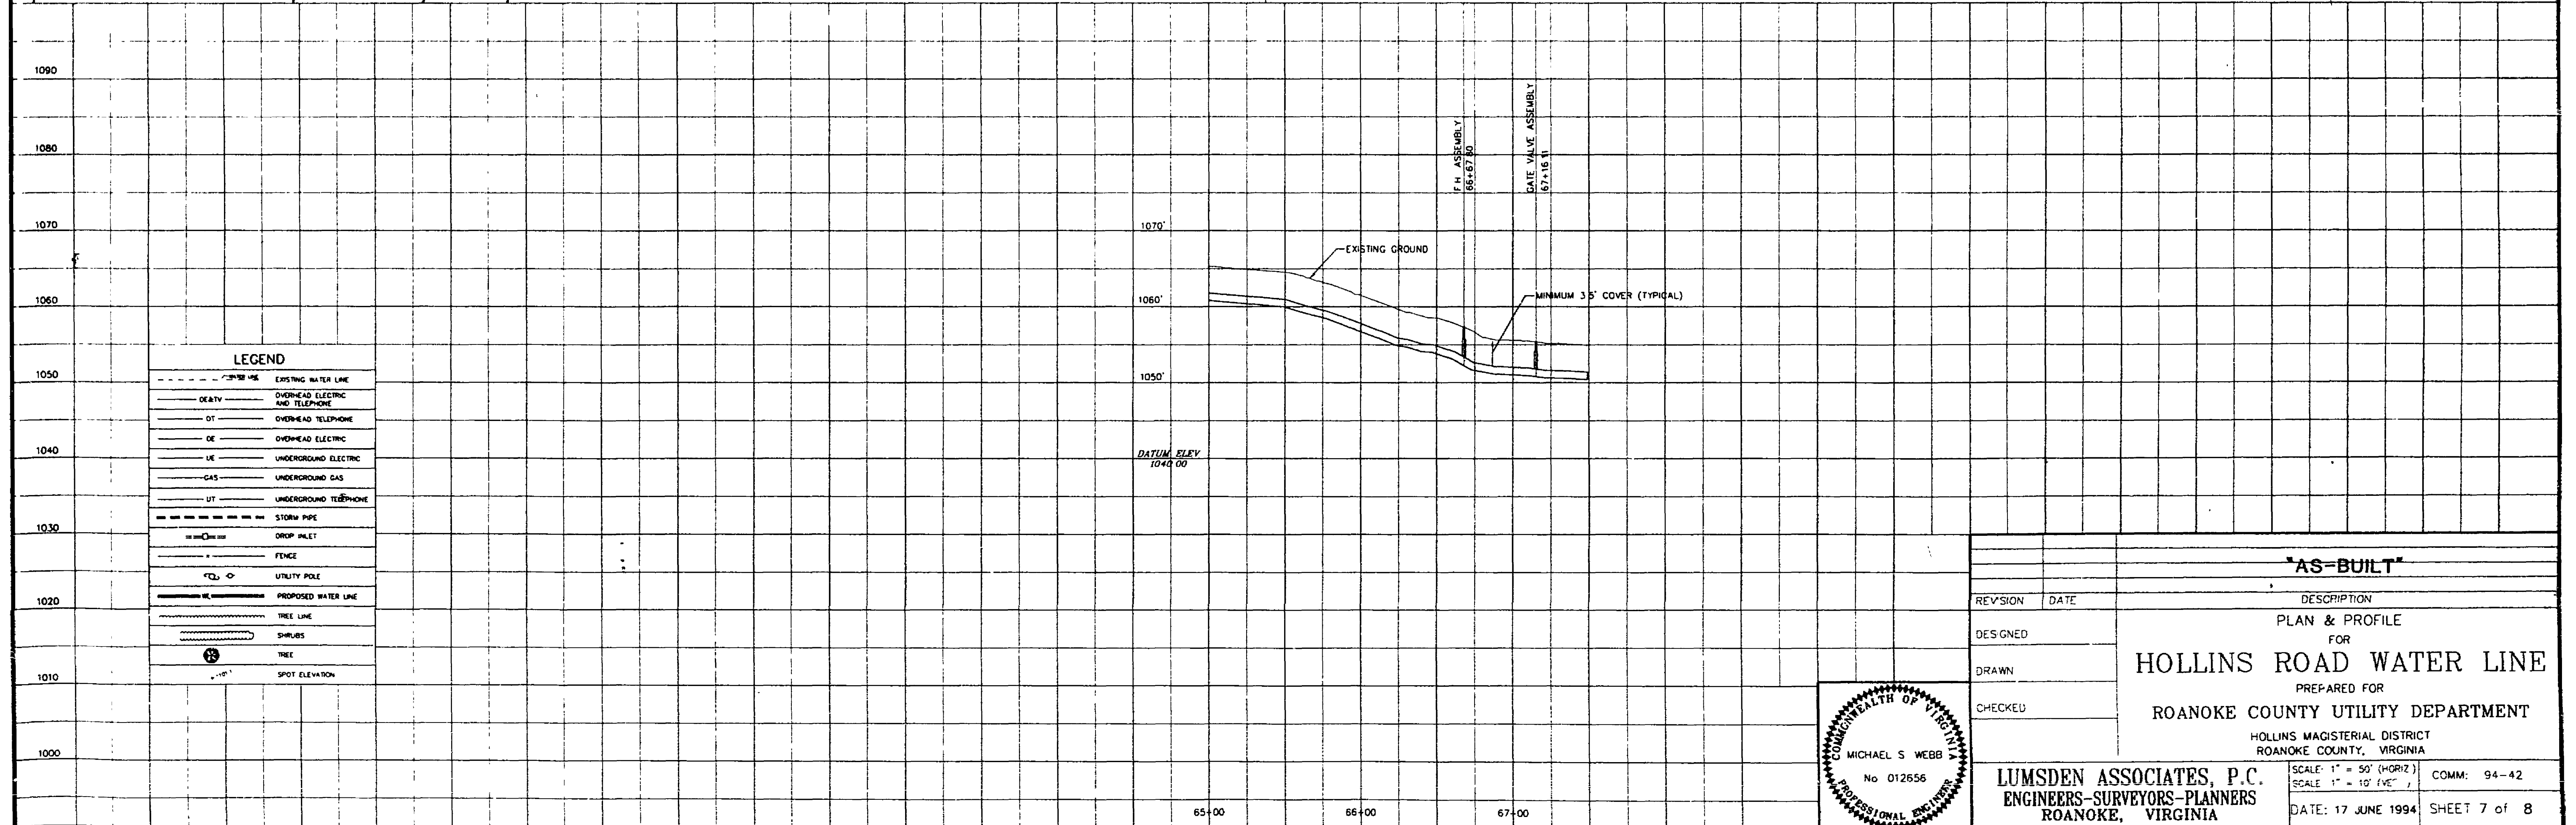


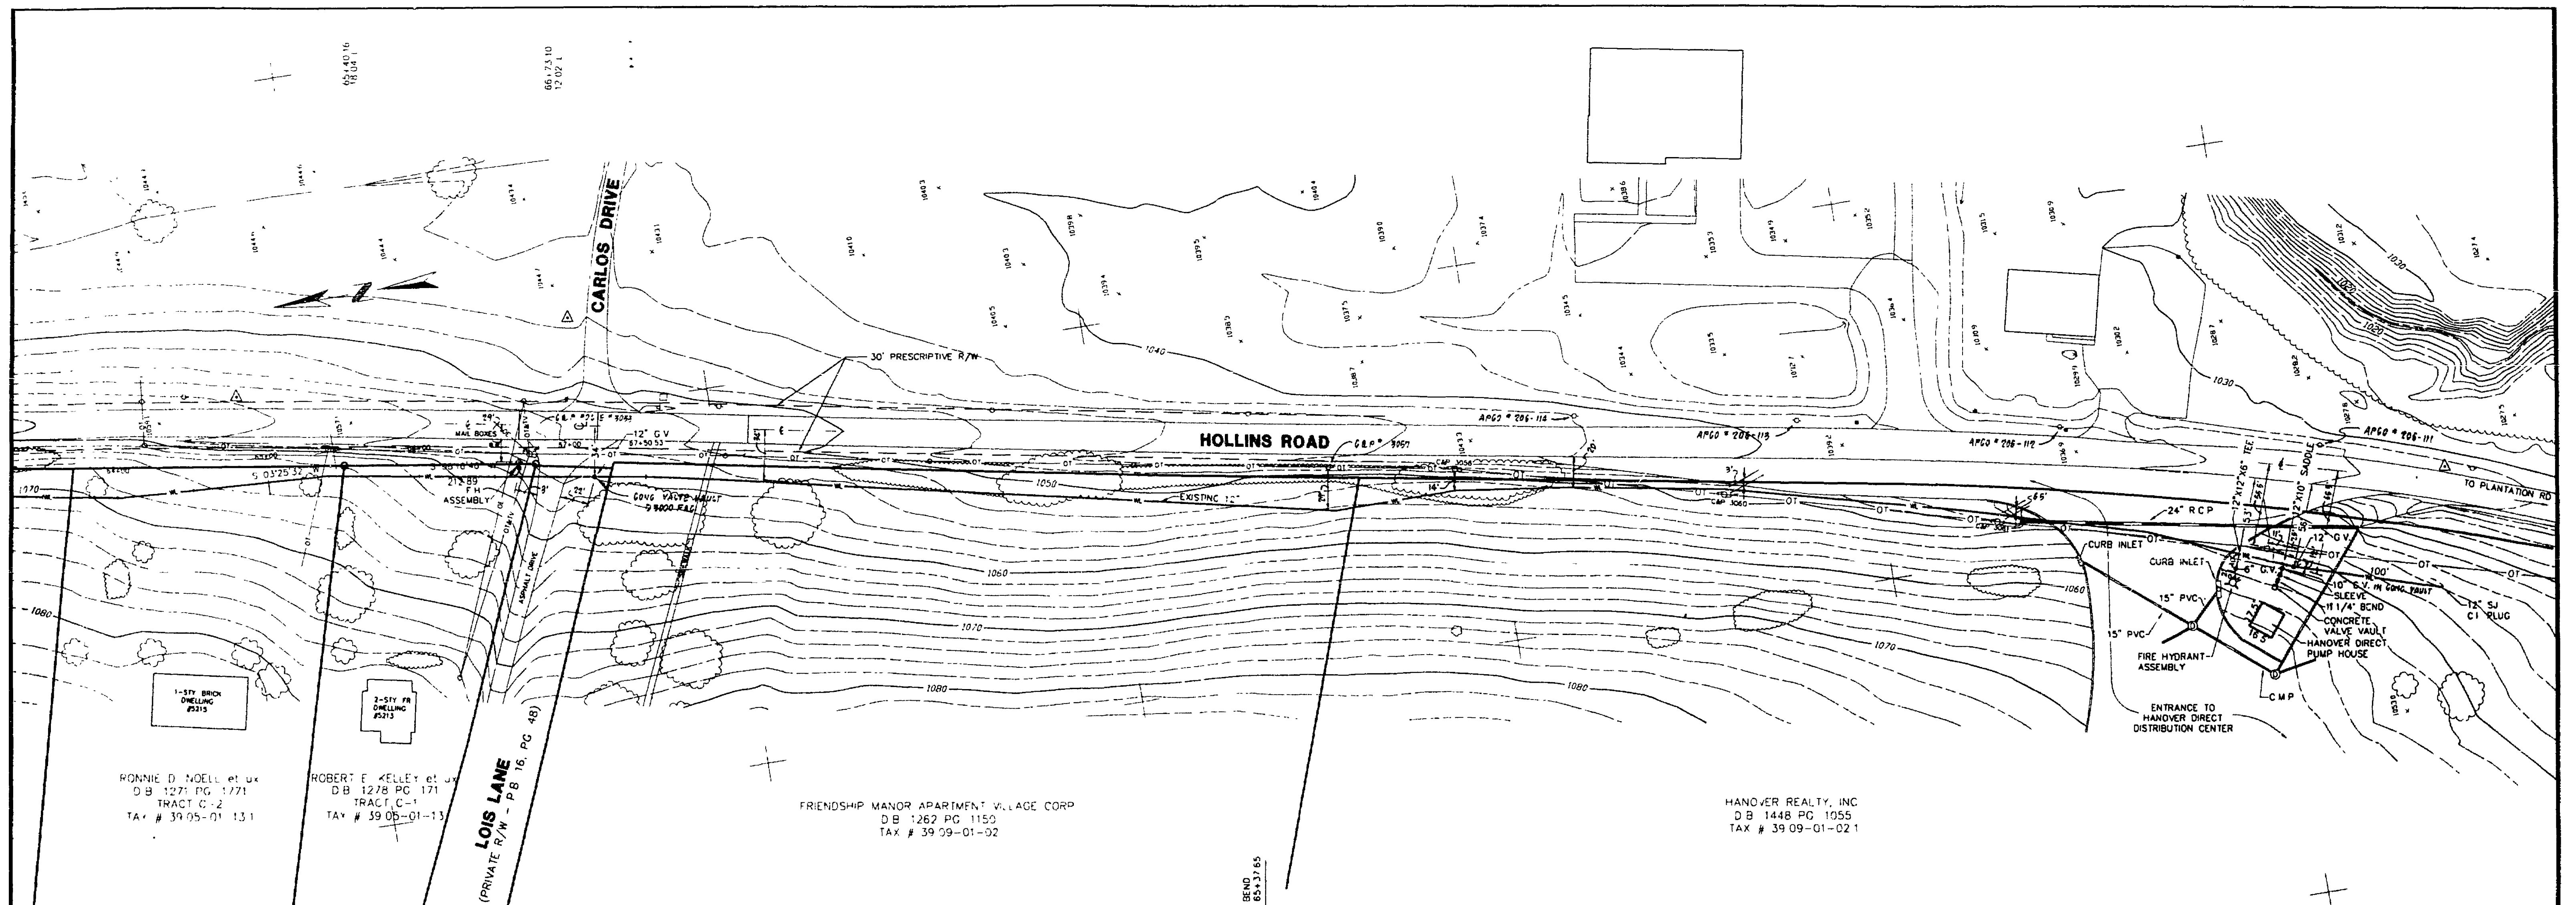

LEGEND	
---	EXISTING WATER LINE
---	OVERHEAD ELECTRIC AND TELEPHONE
---	OVERHEAD TELEPHONE
---	OVERHEAD ELECTRIC
---	UNDERGROUND ELECTRIC
---	UNDERGROUND GAS
---	UNDERGROUND TELEPHONE
---	STORM PIPE
---	DROP INLET
---	FENCE
---	UTILITY POLE
---	PROPOSED WATER LINE
---	TRAIL LINE
---	SHRUBS
---	TREE
---	SPOT ELEVATION

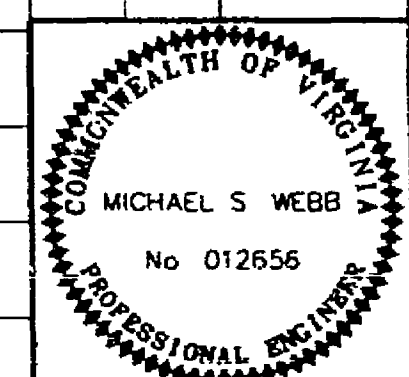

REVISION		DATE	DESCRIPTION
DESIGNED			
DRAWN			
CHECKED			

AS-BUILT

PLAN & PROFILE
FOR
HOLLINS ROAD WATER LINE
PREPARED FOR
ROANOKE COUNTY UTILITY DEPARTMENT
HOLLINS MAGISTERIAL DISTRICT
ROANOKE COUNTY, VIRGINIA

LUMSDEN ASSOCIATES, P.C.
ENGINEERS-SURVEYORS-PLANNERS
ROANOKE, VIRGINIA

SCALE: 1" = 50' (HORIZ)
SCALE: 1" = 10' (VERT)
DATE: 17 JUNE 1994

COMM: 94-42
SHEET 7 of 8