
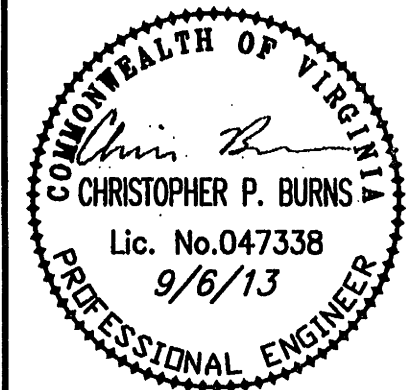


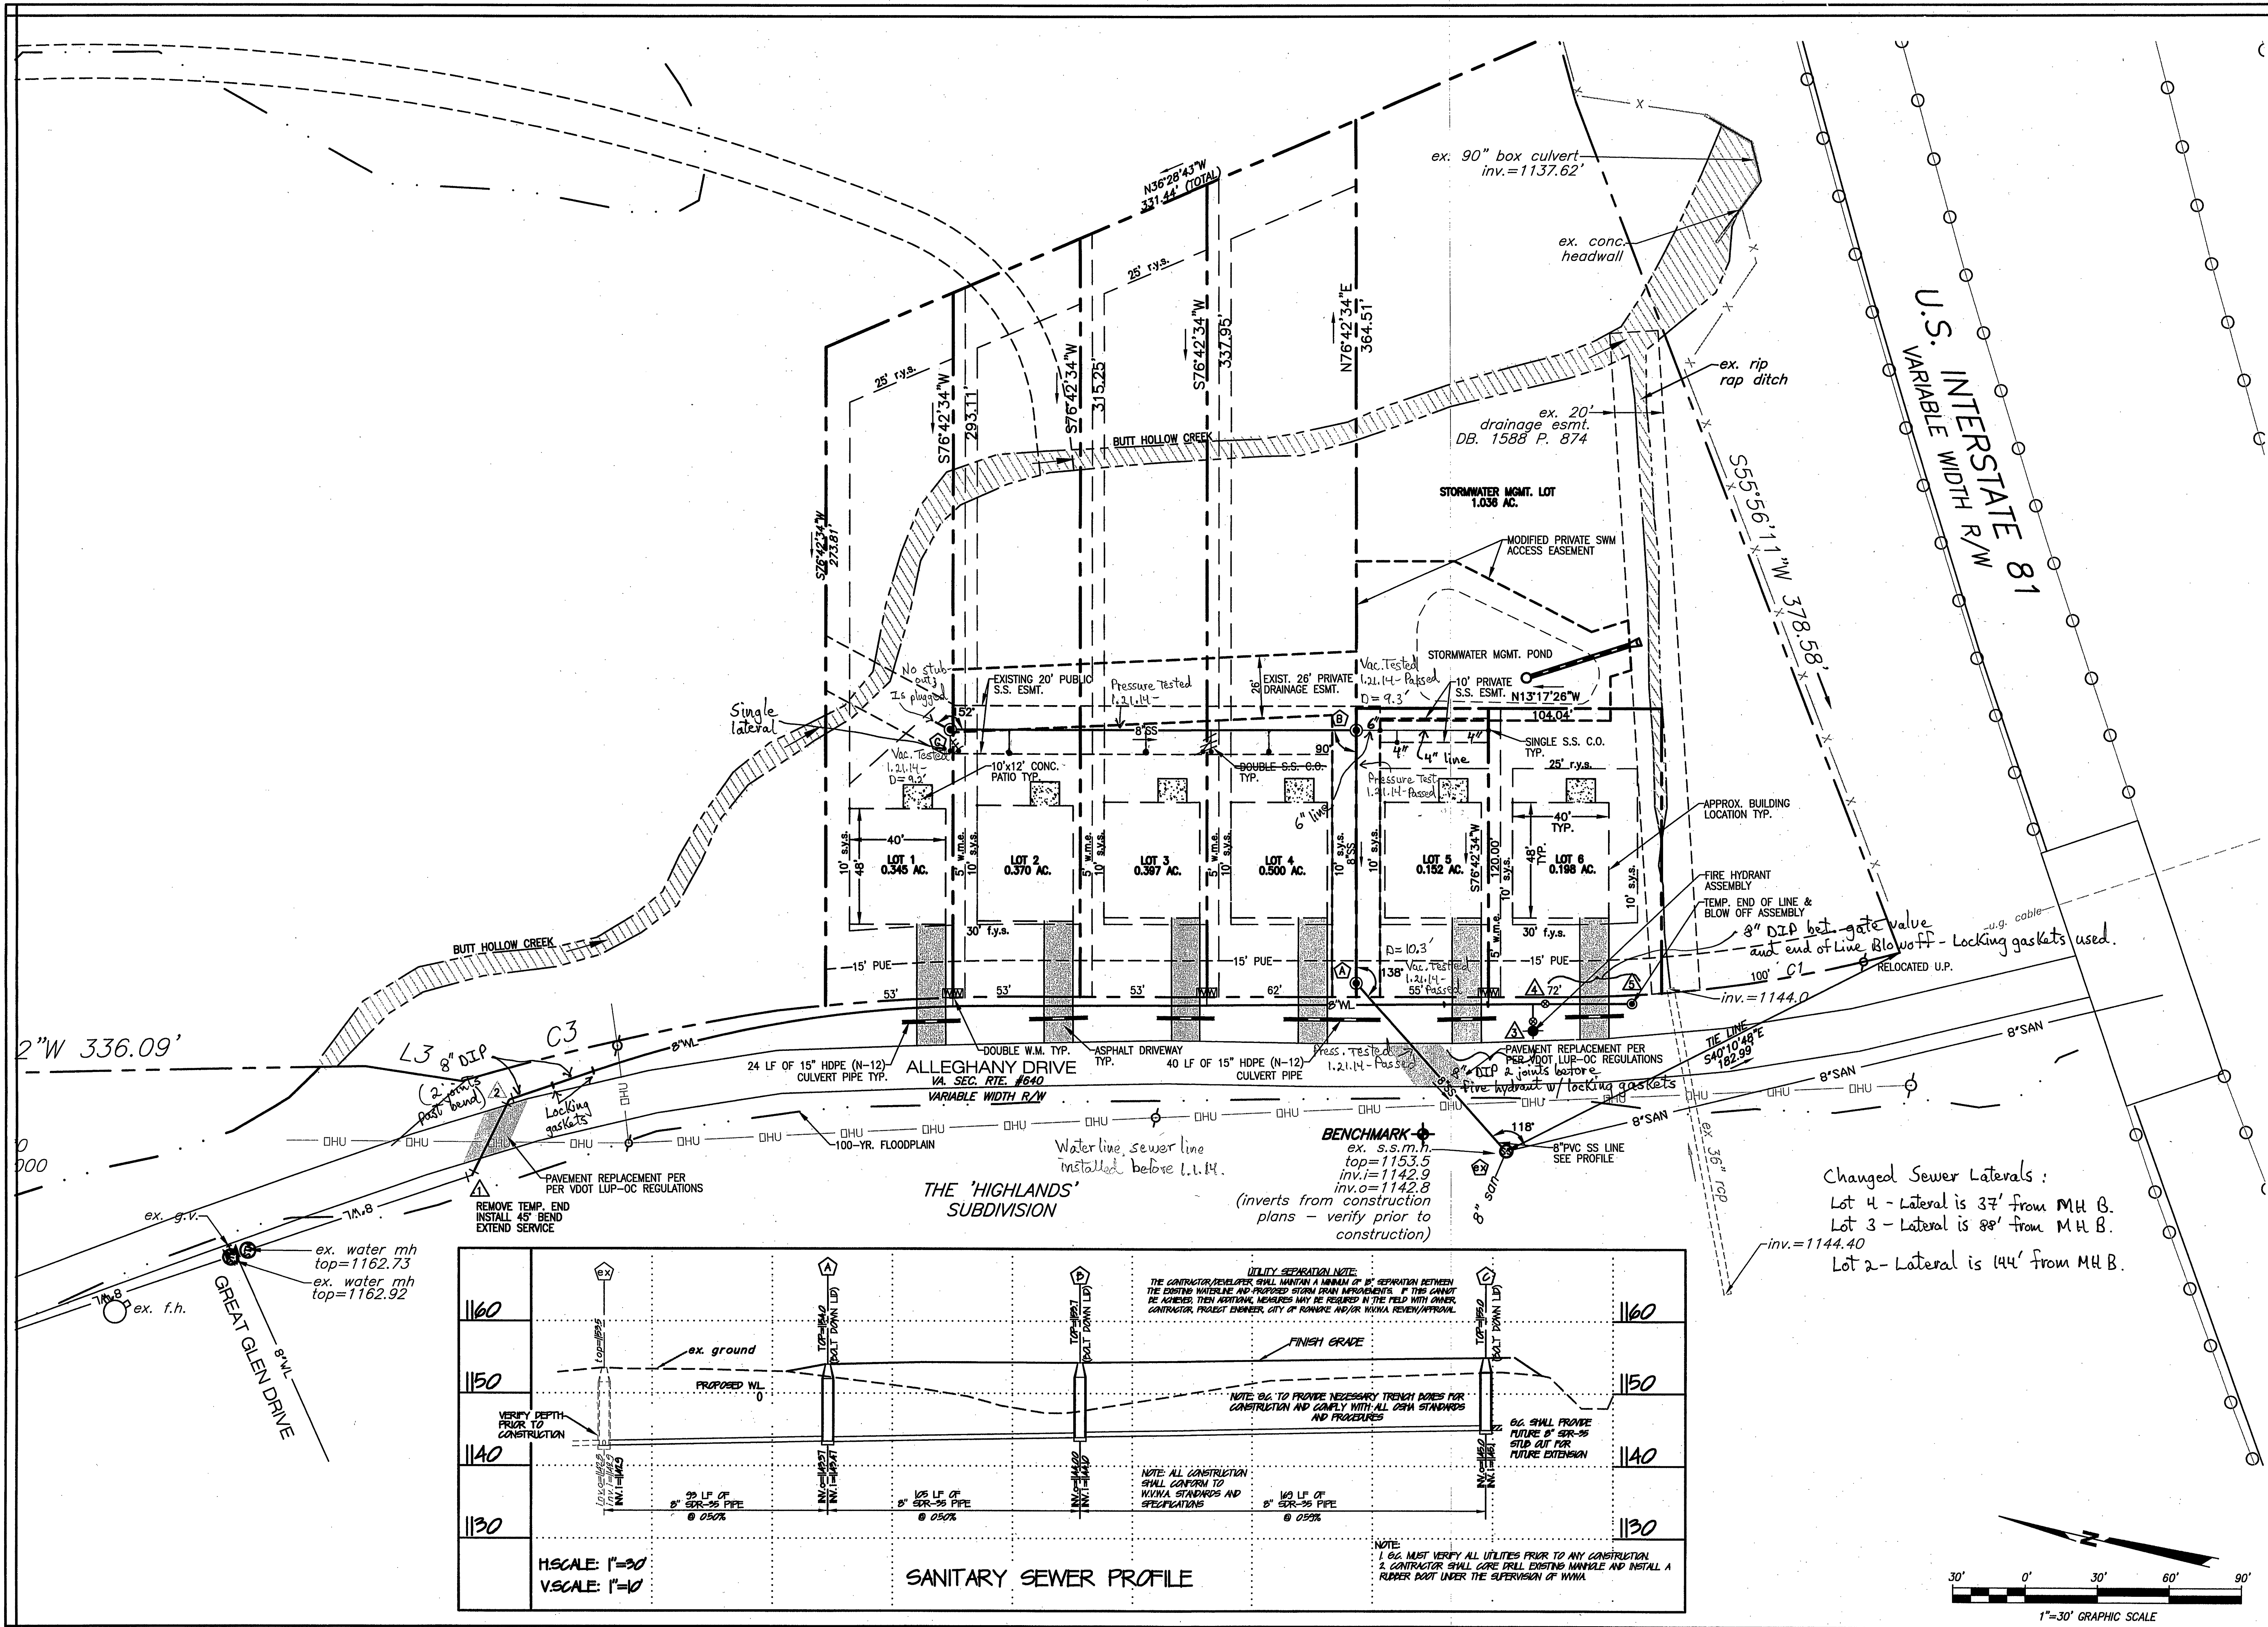

BALZER AND ASSOCIATES, INC.
PLANNERS • ARCHITECTS
ENGINEERS • SURVEYORS

1208 Corporate Circle
 Roanoke, Virginia 24018
 Phone: 540/772-9550
 FAX: 540/772-8050

501 Branchway Road
 Richmond, Virginia 23236
 Phone: 804/794-0571
 FAX: 804/794-2655

880 Technology Park Drive
 Suite 200
 Glen Allen, Virginia 23059
 Phone: 804/653-0132
 FAX: 804/653-0133

448 Peppers Ferry Road, NW
 Christiansburg, Virginia 24073
 Phone: 540/381-4280
 FAX: 540/381-4291

1561 Commerce Road
 Suite 401
 Verona, Virginia 24482
 Phone: 540/248-9220
 FAX: 540/248-3221

HOLLOW CREEK SUBDIVISION DIMENSIONAL PLAN

ROANOKE COUNTY, VIRGINIA

DRAWN BY: BTC
DESIGNED BY: BTC
CHECKED BY: SMH
DATE: 4/5/2013
REVISIONS: 5/7/2013
 9/6/2013

SCALE: 1" = 30'
SHEET NO.

C-04

JOB NO.
 R0700180.02

As-Built 2.24.14 K. Winslow