
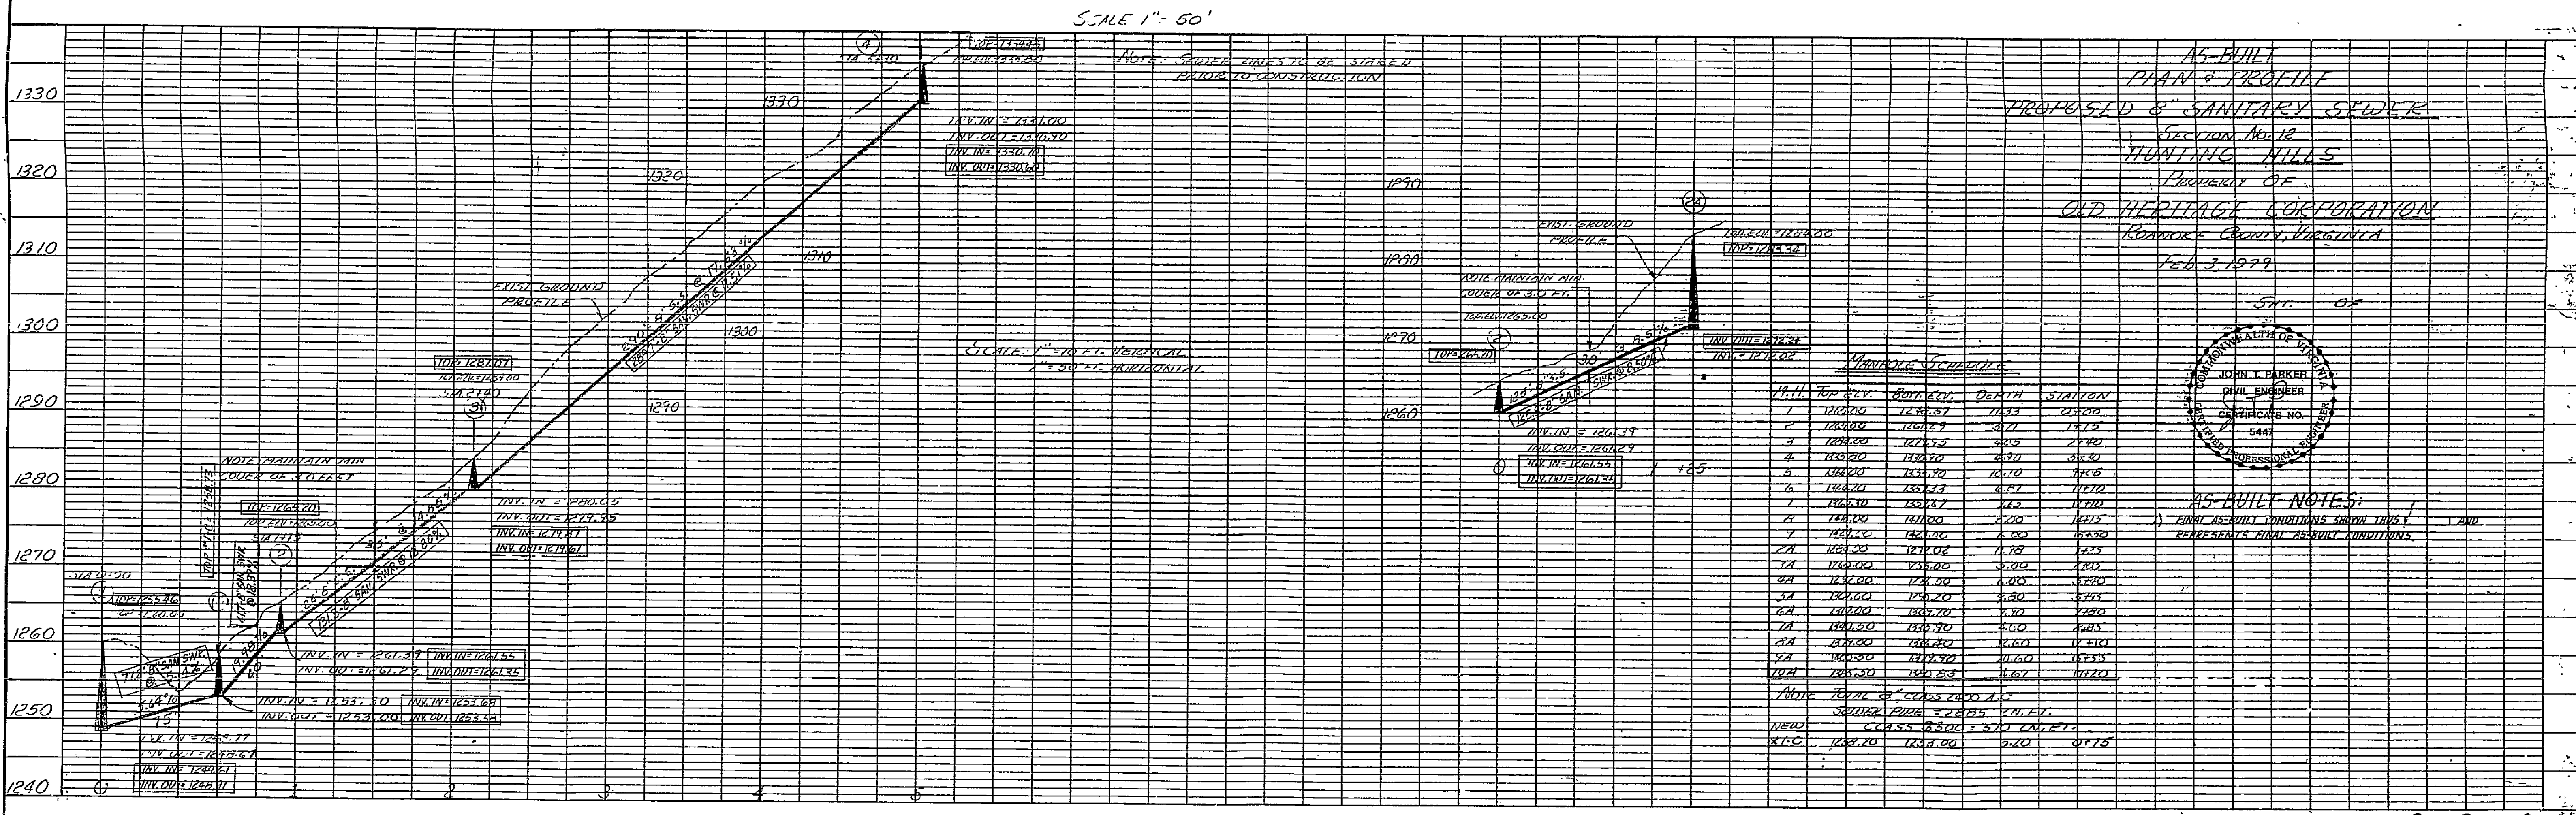


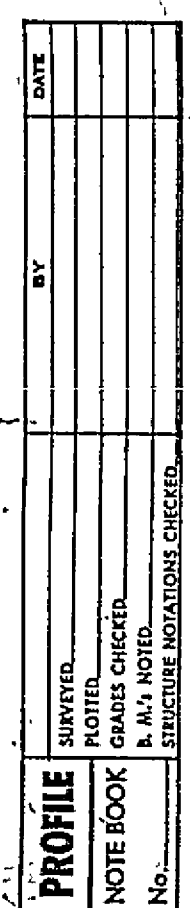

- 544.
- 6
- COMMONWEALTH OF VIRGINIA
JOHN I. PARKER
CIVIL ENGINEER
STATE
CERTIFICATE NO.
544
REGISTERED PROFESSIONAL ENGINEER

AS-BUILT NOTES:

1) FINAL AS-BUILT CONDITIONS SHOWN THUS
REPRESENTS FINAL AS-BUILT CONDITIONS